4

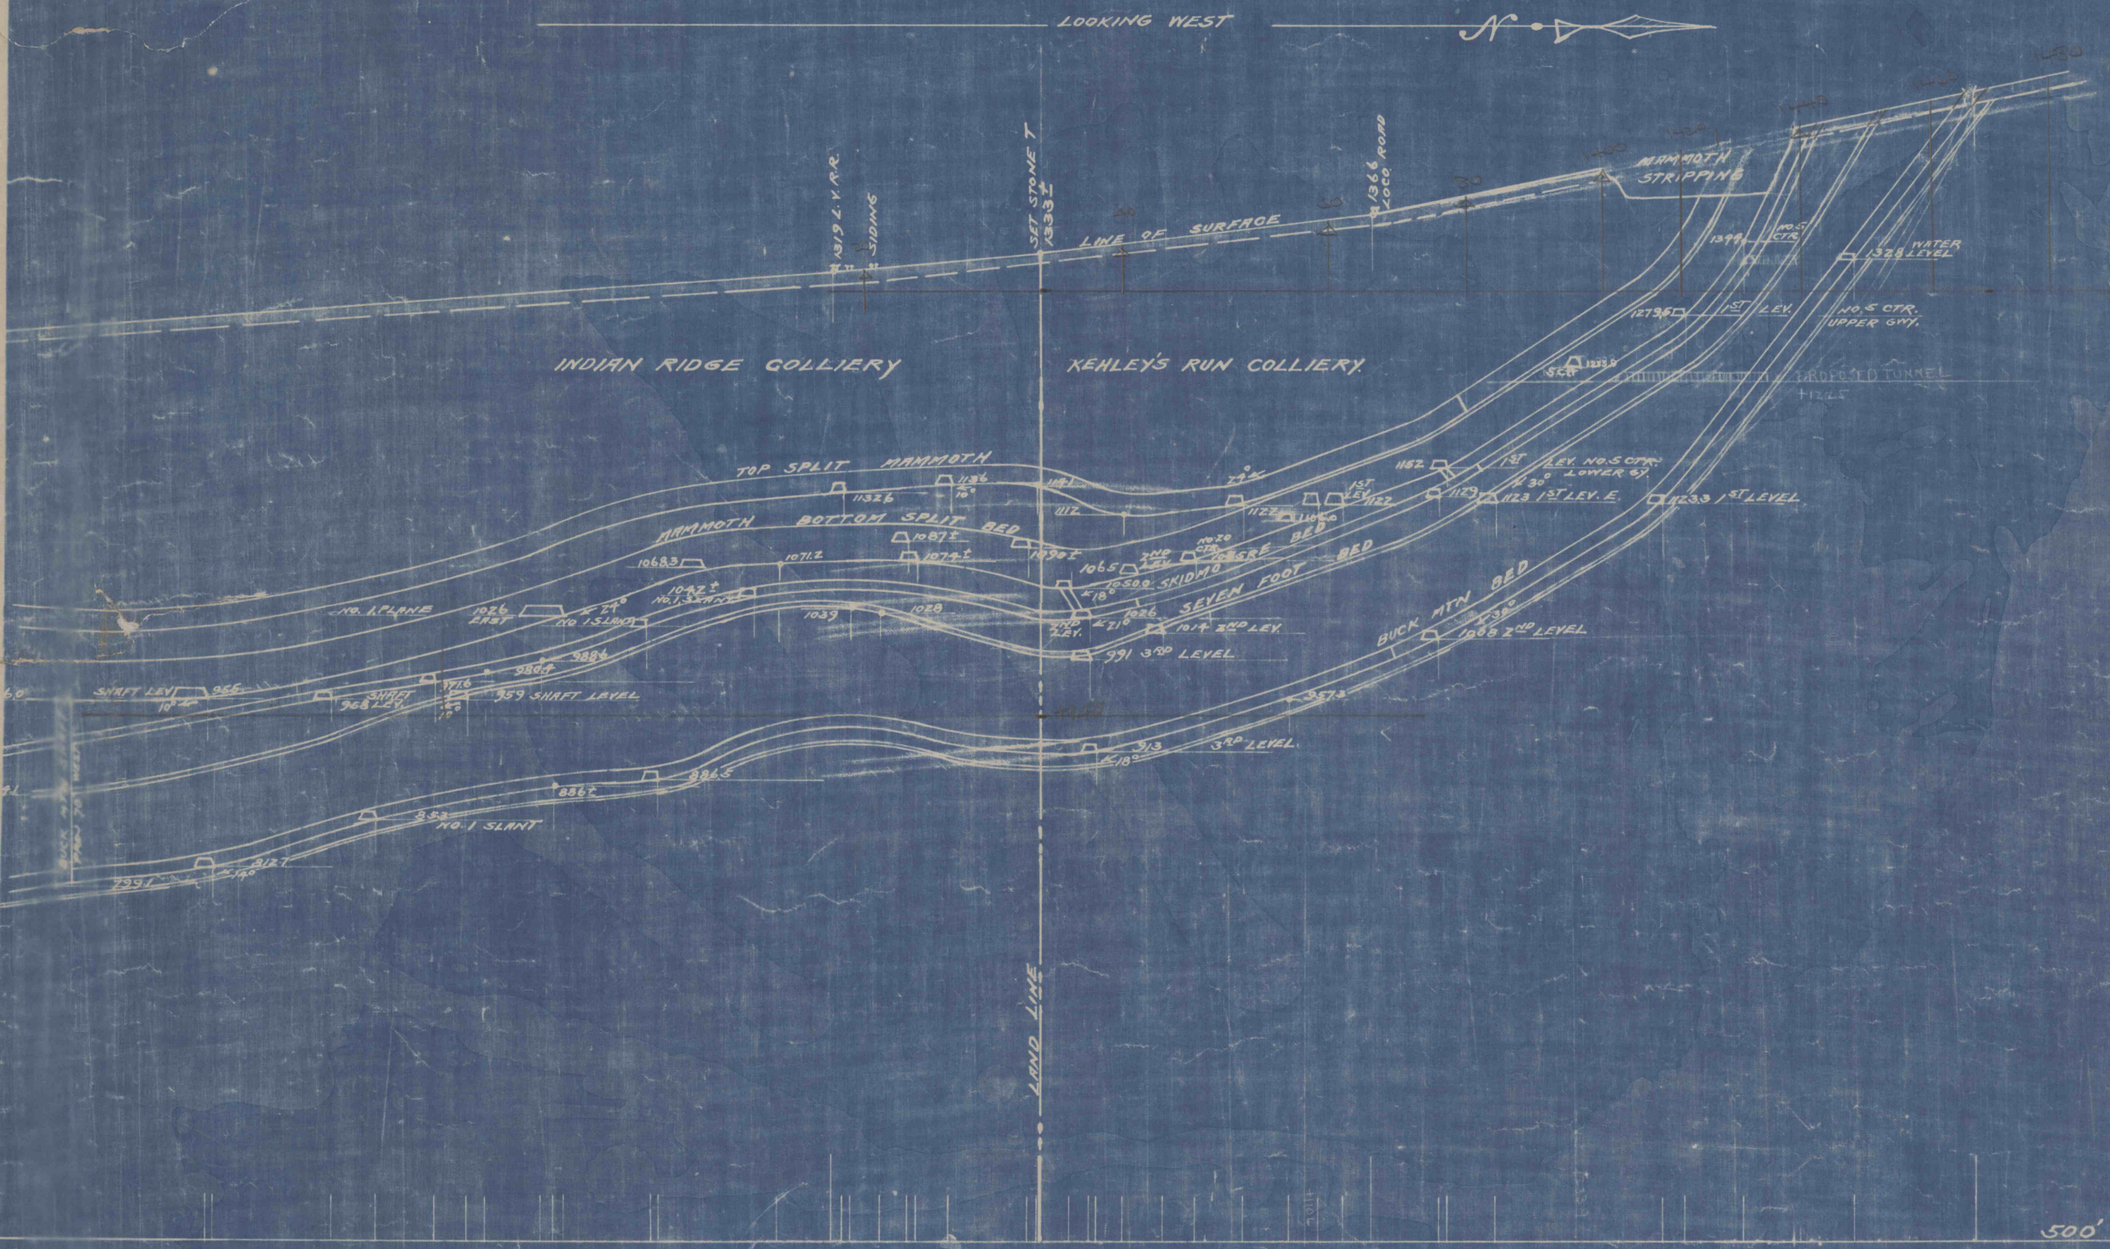

KEHLEY'S RUN COLLIERY

CROSS SECTION THROUGH SET STONE T AT 375 FEET EAST OF AND PARALLEL TO MERIDIAN LINE 21000 E.

SCALE 1" = 100'

FRACKVILLE, PENNA. JUNE 14-1917.

THOMAS COLLIERY COMPANY.
SHENANDOAH, PENNA.