


3

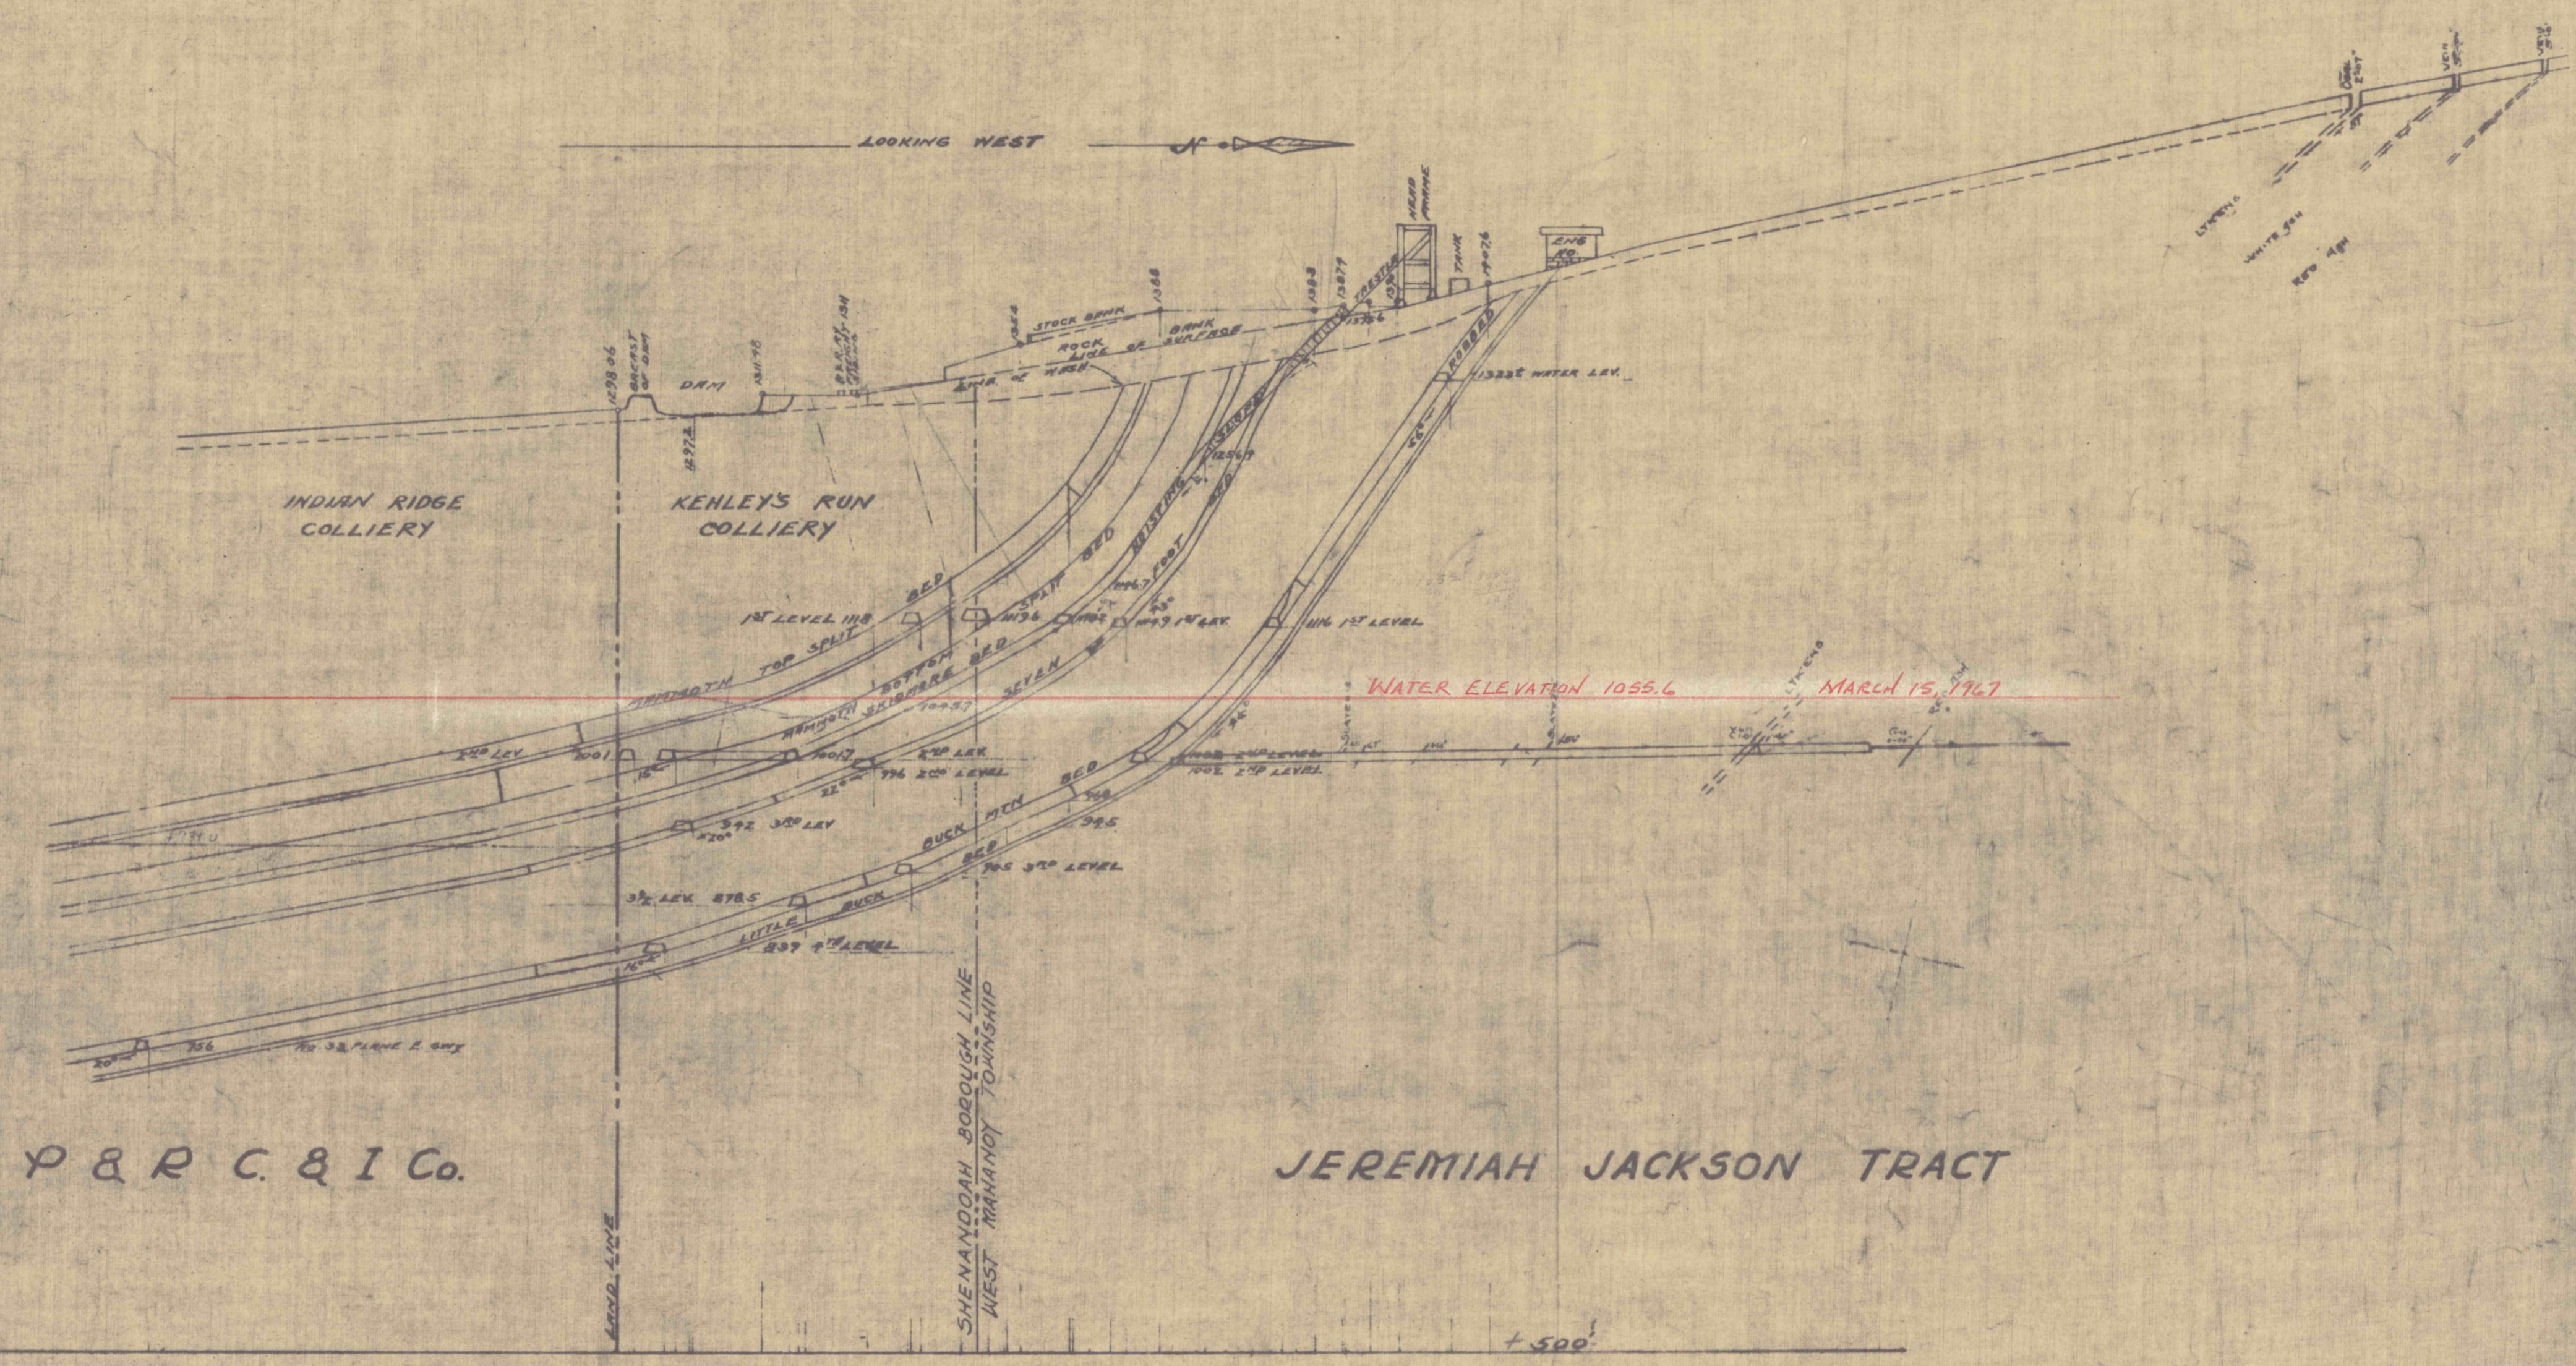

P & R C. & I Co.

JEREMIAH JACKSON TRACT

KEHLEYS RUN COLLIERY
 CROSS SECTION THROUGH MAIN SKIDMORE HOISTING SLOPE.
 SCALE 1" = 100'

FRACKVILLE, PENNA. JUN 5 - 1971
 THOMAS COLLIERY COMPANY
 SHENANDOH PA.

101-8