


KEHLEY RUN COLLIERY  
 CROSS SECTION 400 FEET WEST OF MAIN  
 SLOPE AND THRU GRANT STREET SHOWING  
 COAL VEINS IN RELATION TO SHENANDOAH  
 BOROUGH.

SCALE 1" = 50'

"B"

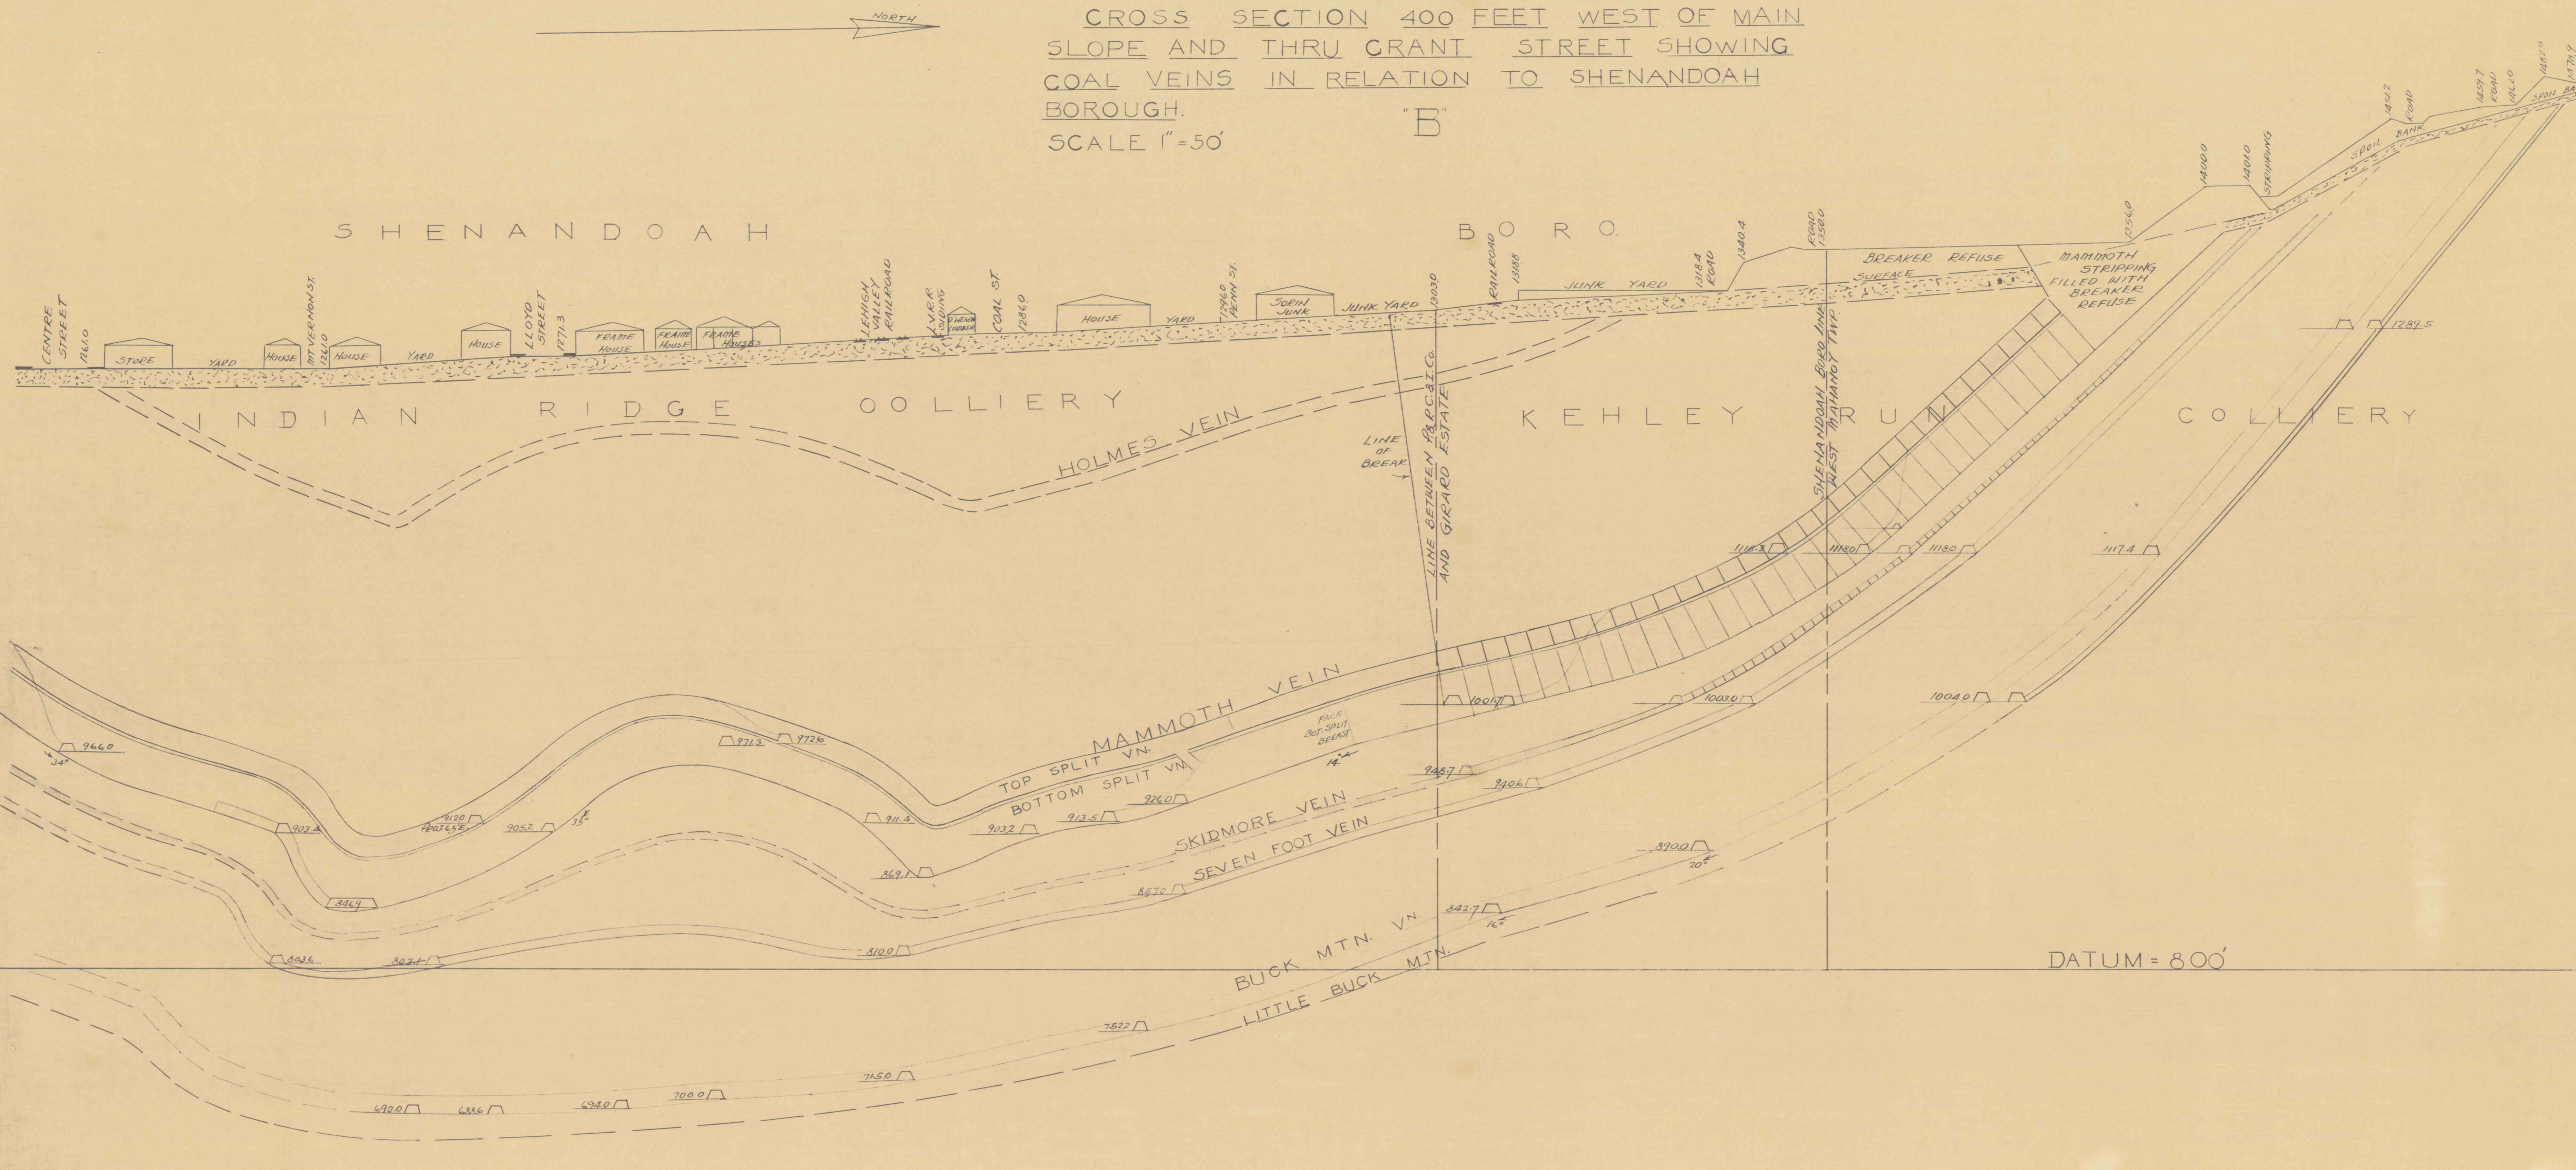

DATUM = 800'