

KEHLEY'S RUN

Little Buck

Scale 1 inch = 100 feet

Pot
Au

GIRARD ESTA

Jeremiah Jackson Tract.

REFUSE BANK


LEASED TO GILBERTON COAL CO

LARGE REFUSE BANK

COAL RESERVE TO J.A. JACOBS

AREA TO BE COVERED

SOLD TO PHI

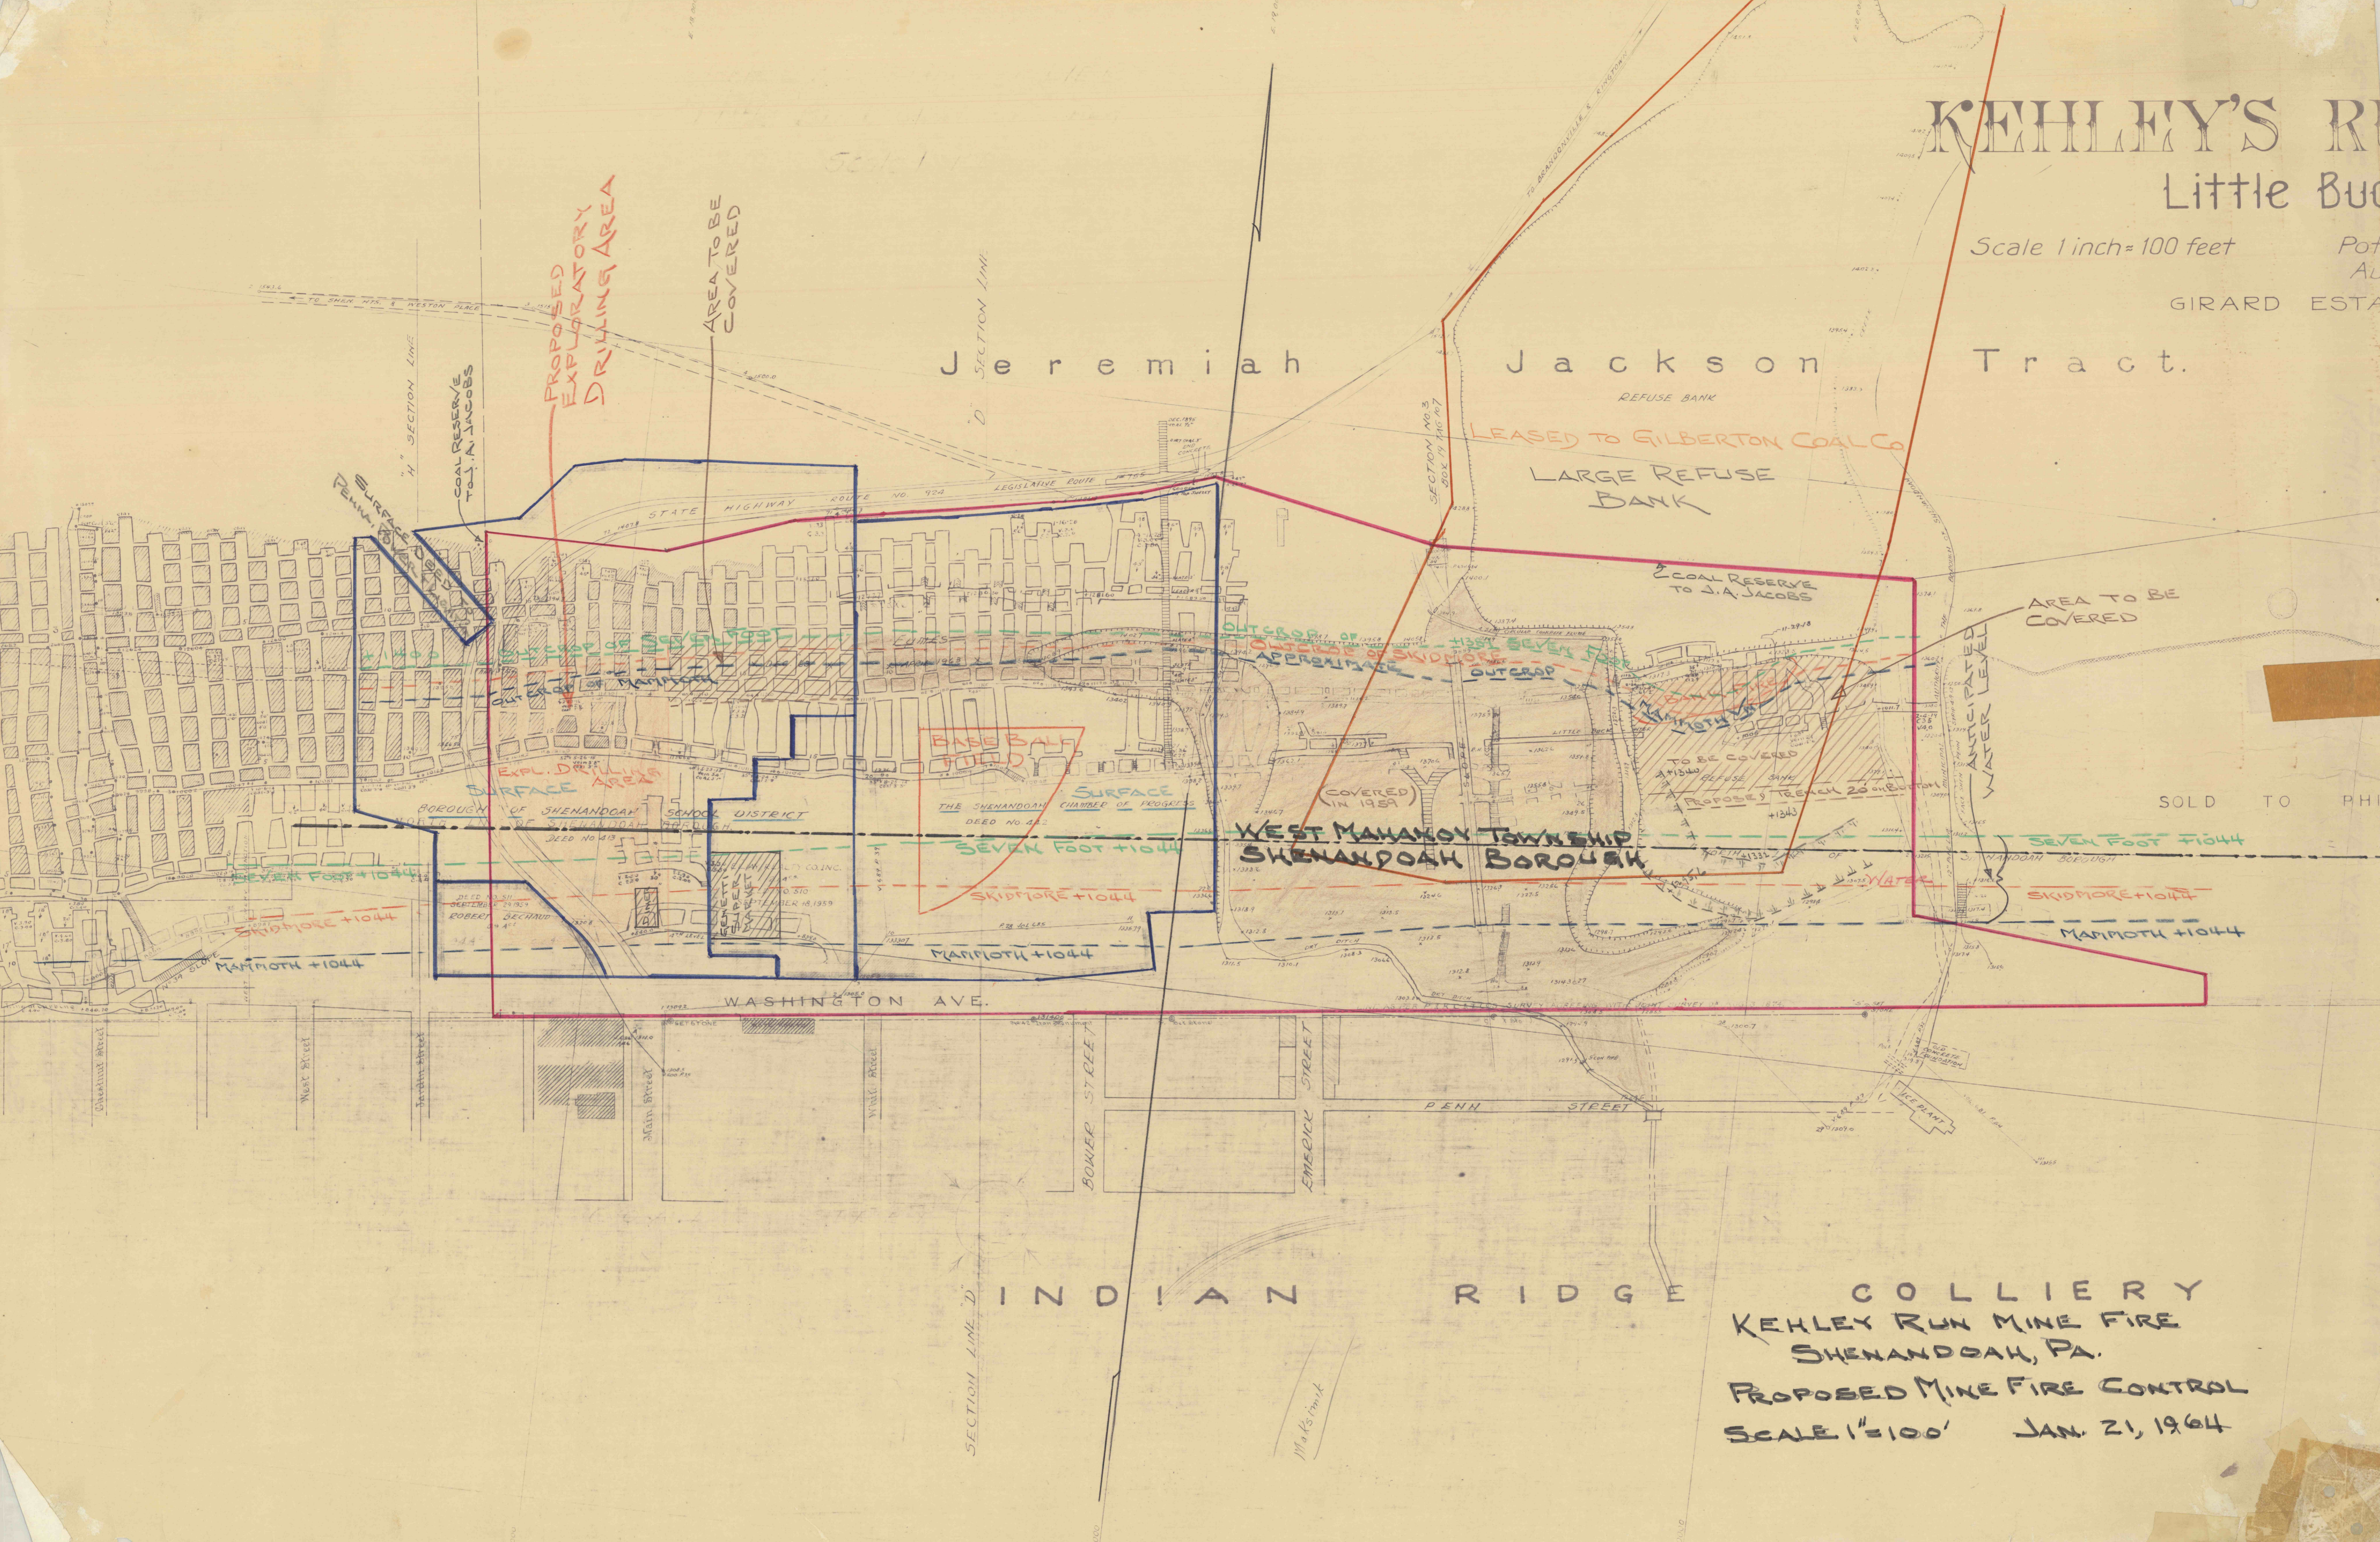

INDIAN RIDGE

COLLIERY
 KEHLEY RUN MINE FIRE
 SHENANDOAH, PA.
 PROPOSED MINE FIRE CONTROL
 SCALE 1"=100' JAN 21, 1964

PROPOSED EXPLORATORY DRILLING AREA

AREA TO BE COVERED

SECTION LINE

SECTION NO. 3

SECTION LINE

COAL RESERVE TO J.A. JACOBS

SURFACE

EXPL. DRILLING AREA

BASE BALL FIELD

SURFACE

WEST MAHANOX TOWNSHIP SHENANDOAH BOROUGH

SEVEN FOOT +1044

SKIDMORE +1044

MAMMOTH +1044

WASHINGTON AVE.

BOWER STREET

EMERICK STREET

PENN STREET

ANTICIPATED WATER LEVEL

SEVEN FOOT +1044

SKIDMORE +1044

MAMMOTH +1044

SECTION LINE

Mine Fire Control