KEHLEY'S RUN COLLIERY

Buck Mountain Bed

Scale 1 inch = 100 feet — Pottsville, Pa. August 1916. — James Archbald, Mining Engineer
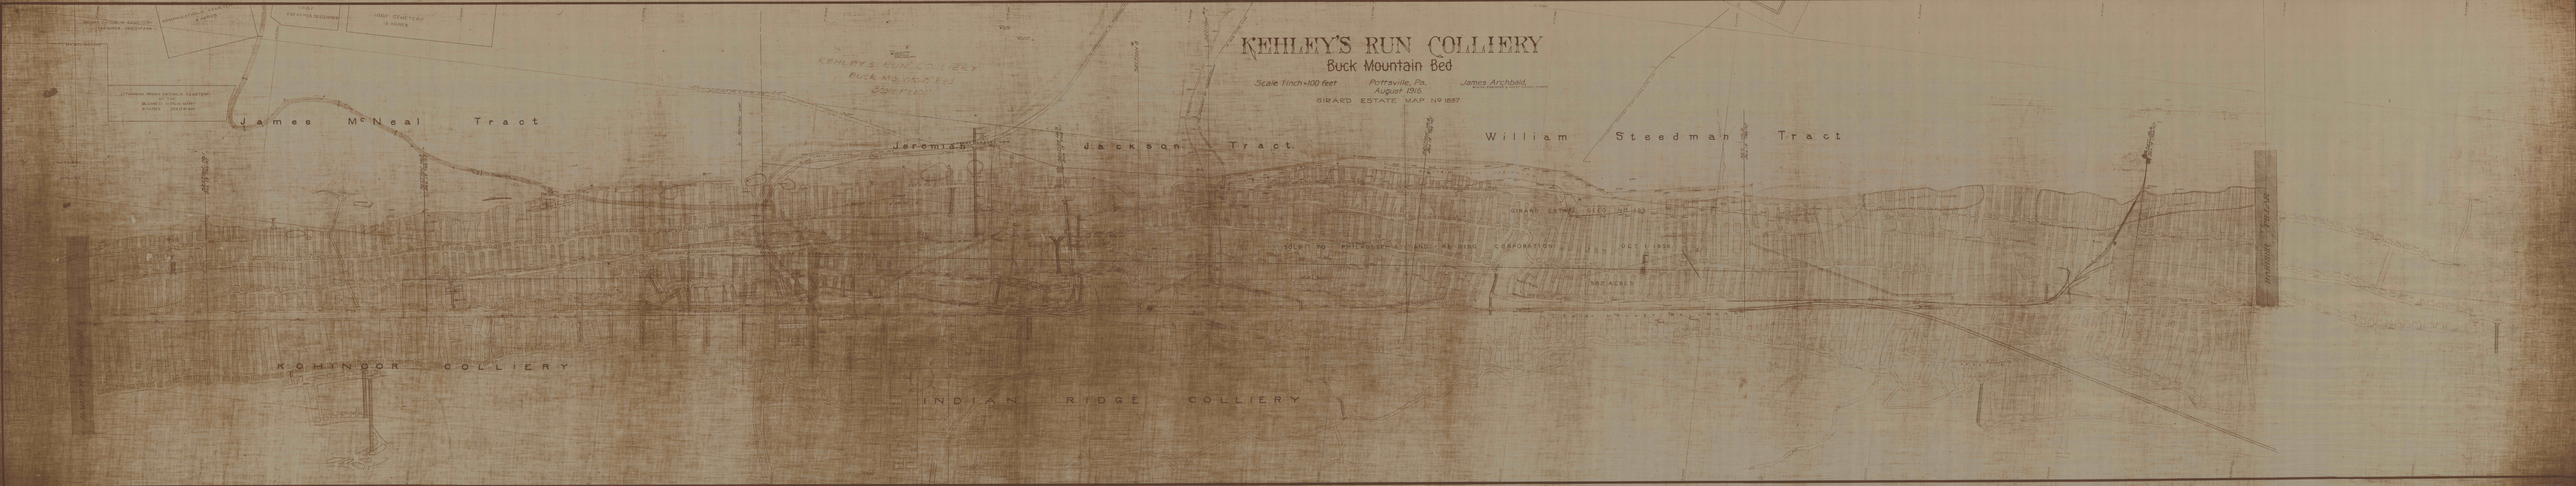
GIRARD ESTATE MAP No 1537