KEHLEY'S RUN COLLIERY

Little Buck Mountain Bed

Scale 1 inch = 100 feet Pottsville, Pa. August 1918. James Archbald.
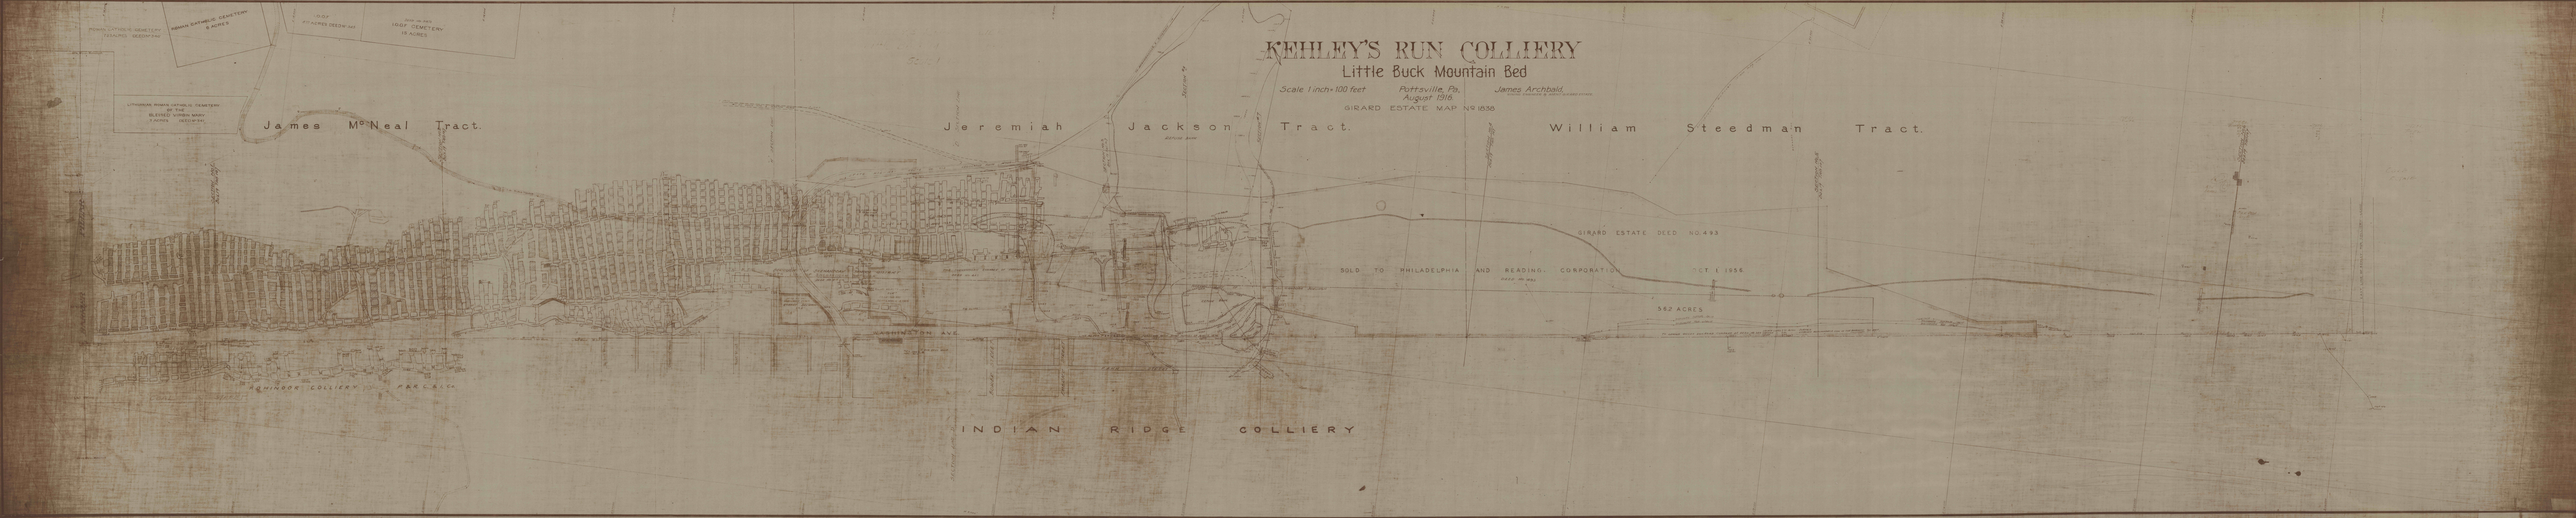
GIRARD ESTATE MAP No 1536