


No 1

LOOKING WEST

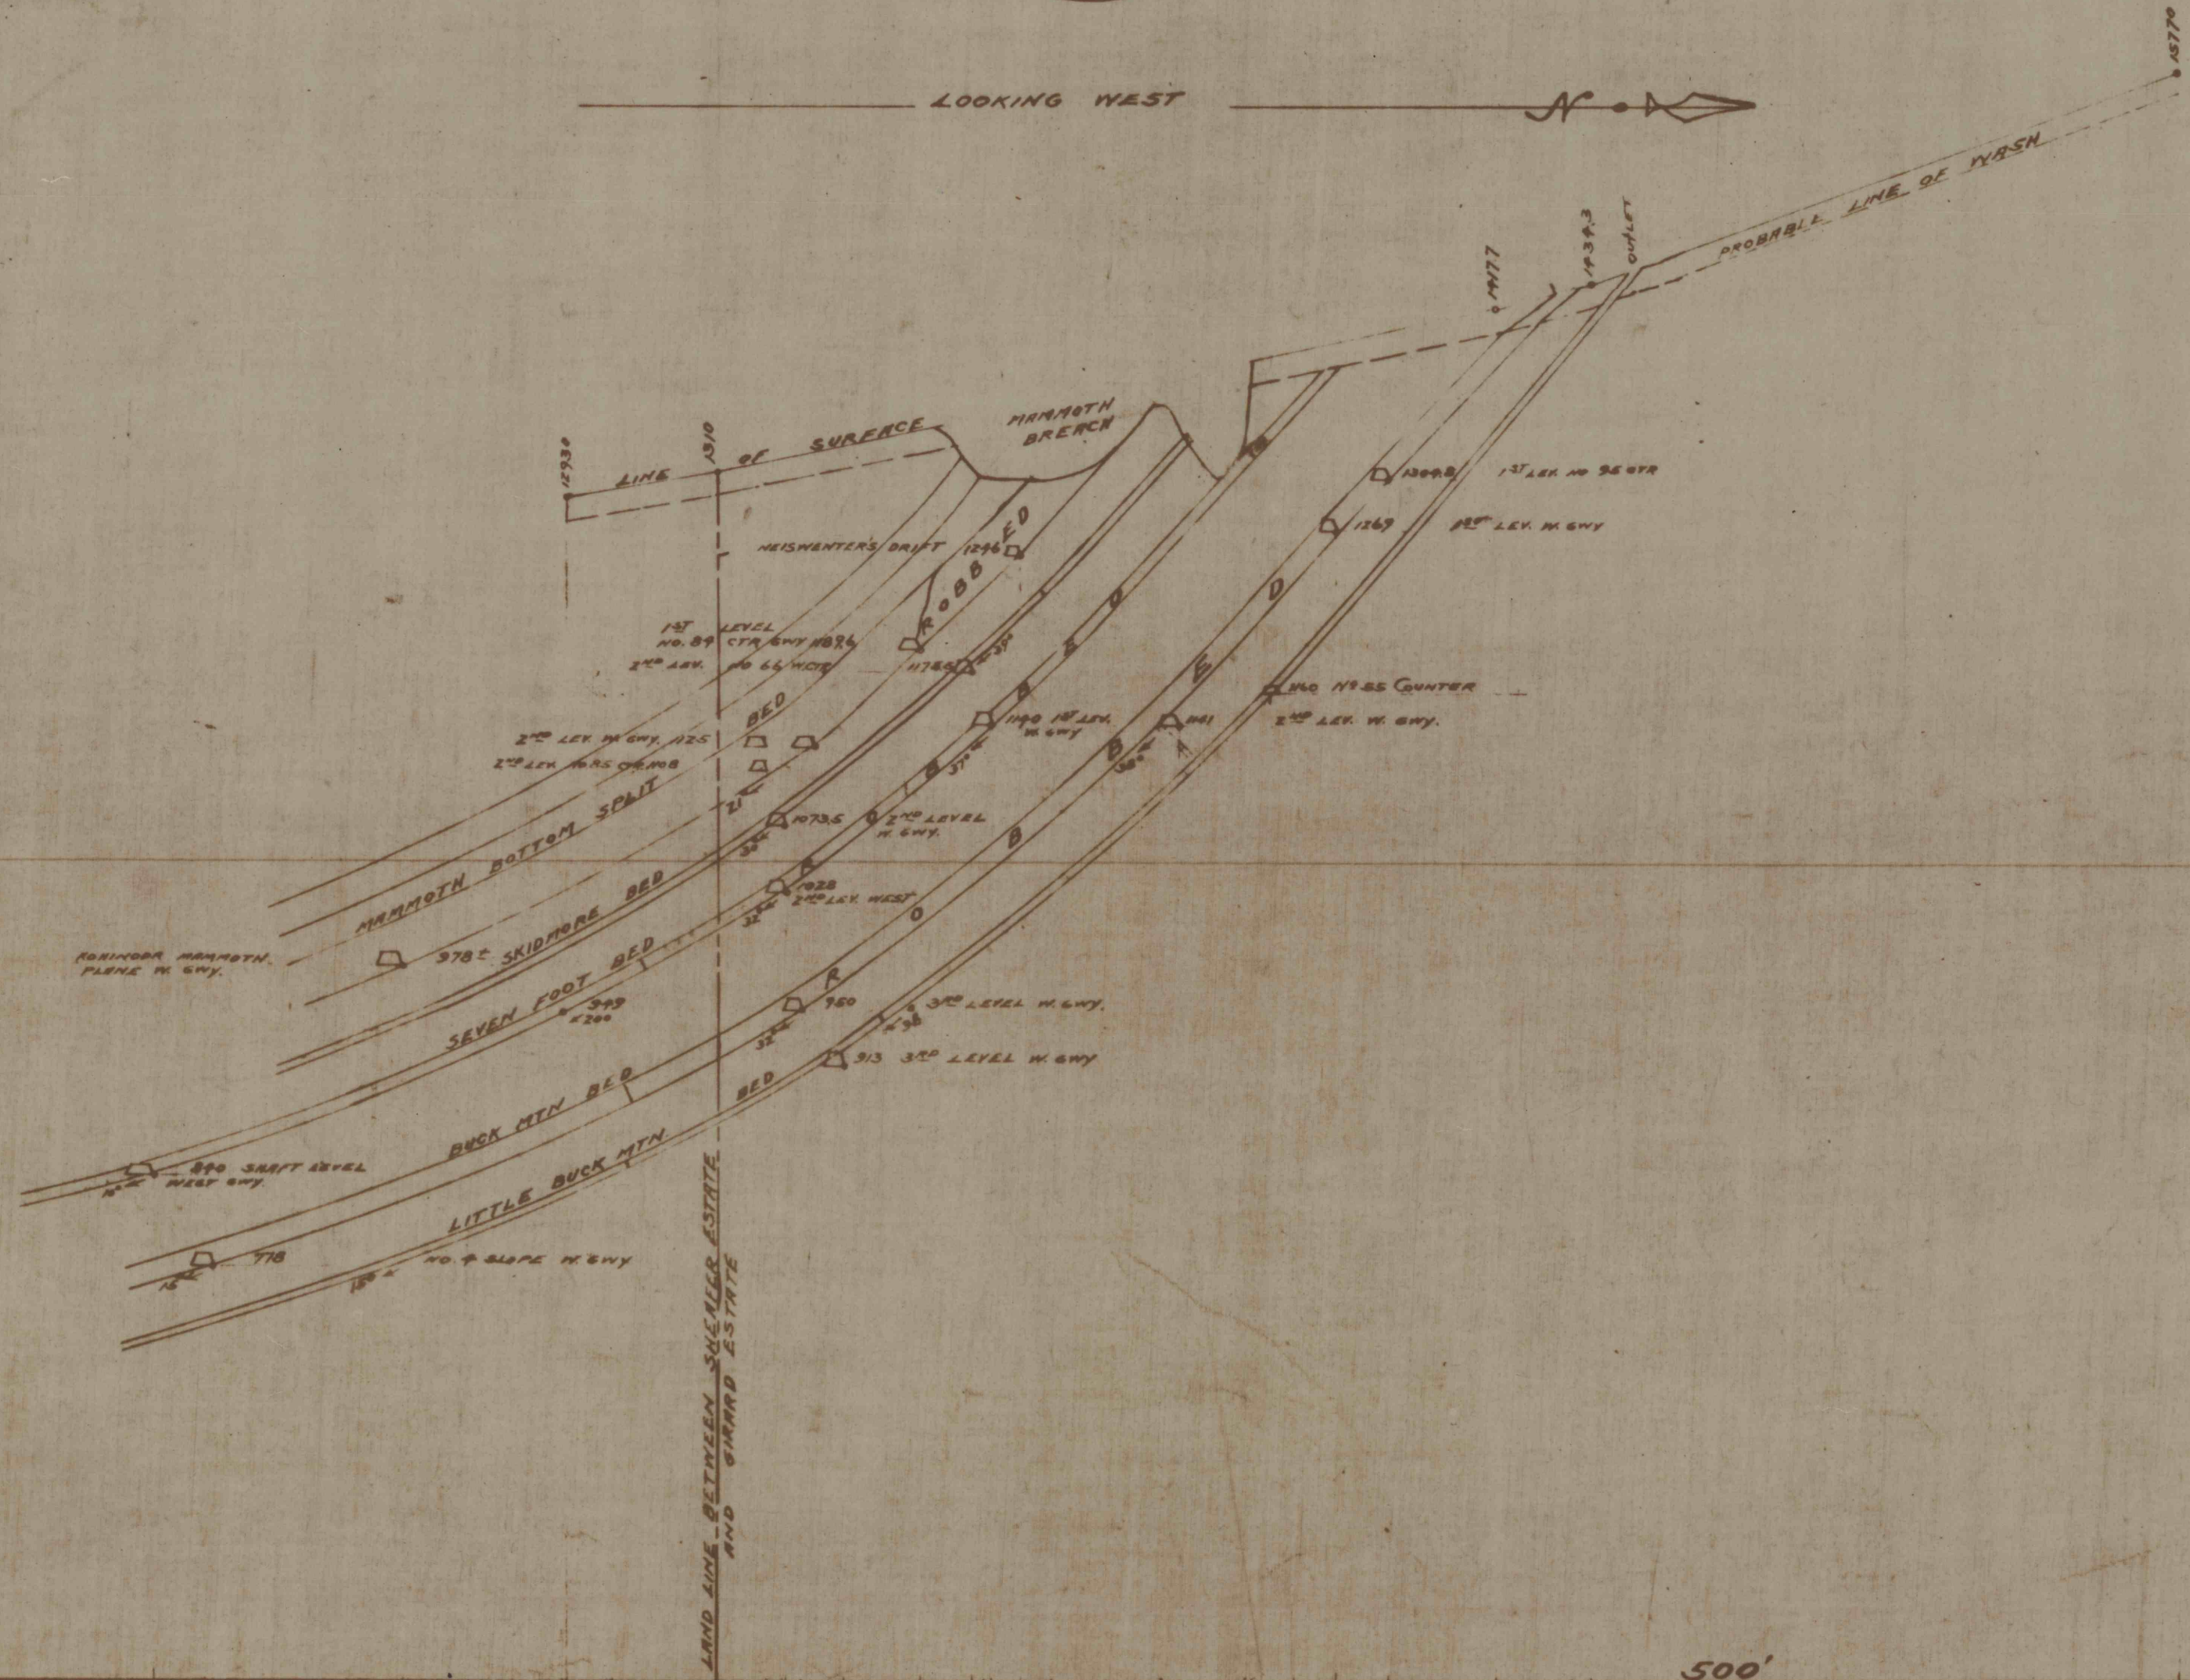

500'

KEHLEY'S RUN COLLIERY

CROSS SECTION THRU No. 95 BUCK MTN TIMBER CHUTE ON 1st LEVEL WEST BUCK MTN G.W.Y.

SCALE 1" = 100'
FRICKVILLE PENNA. JUNE 9-1917.
THOMAS COLLIERY COMPANY.
SHENANDOOK PENNA.