


5

LOOKING WEST

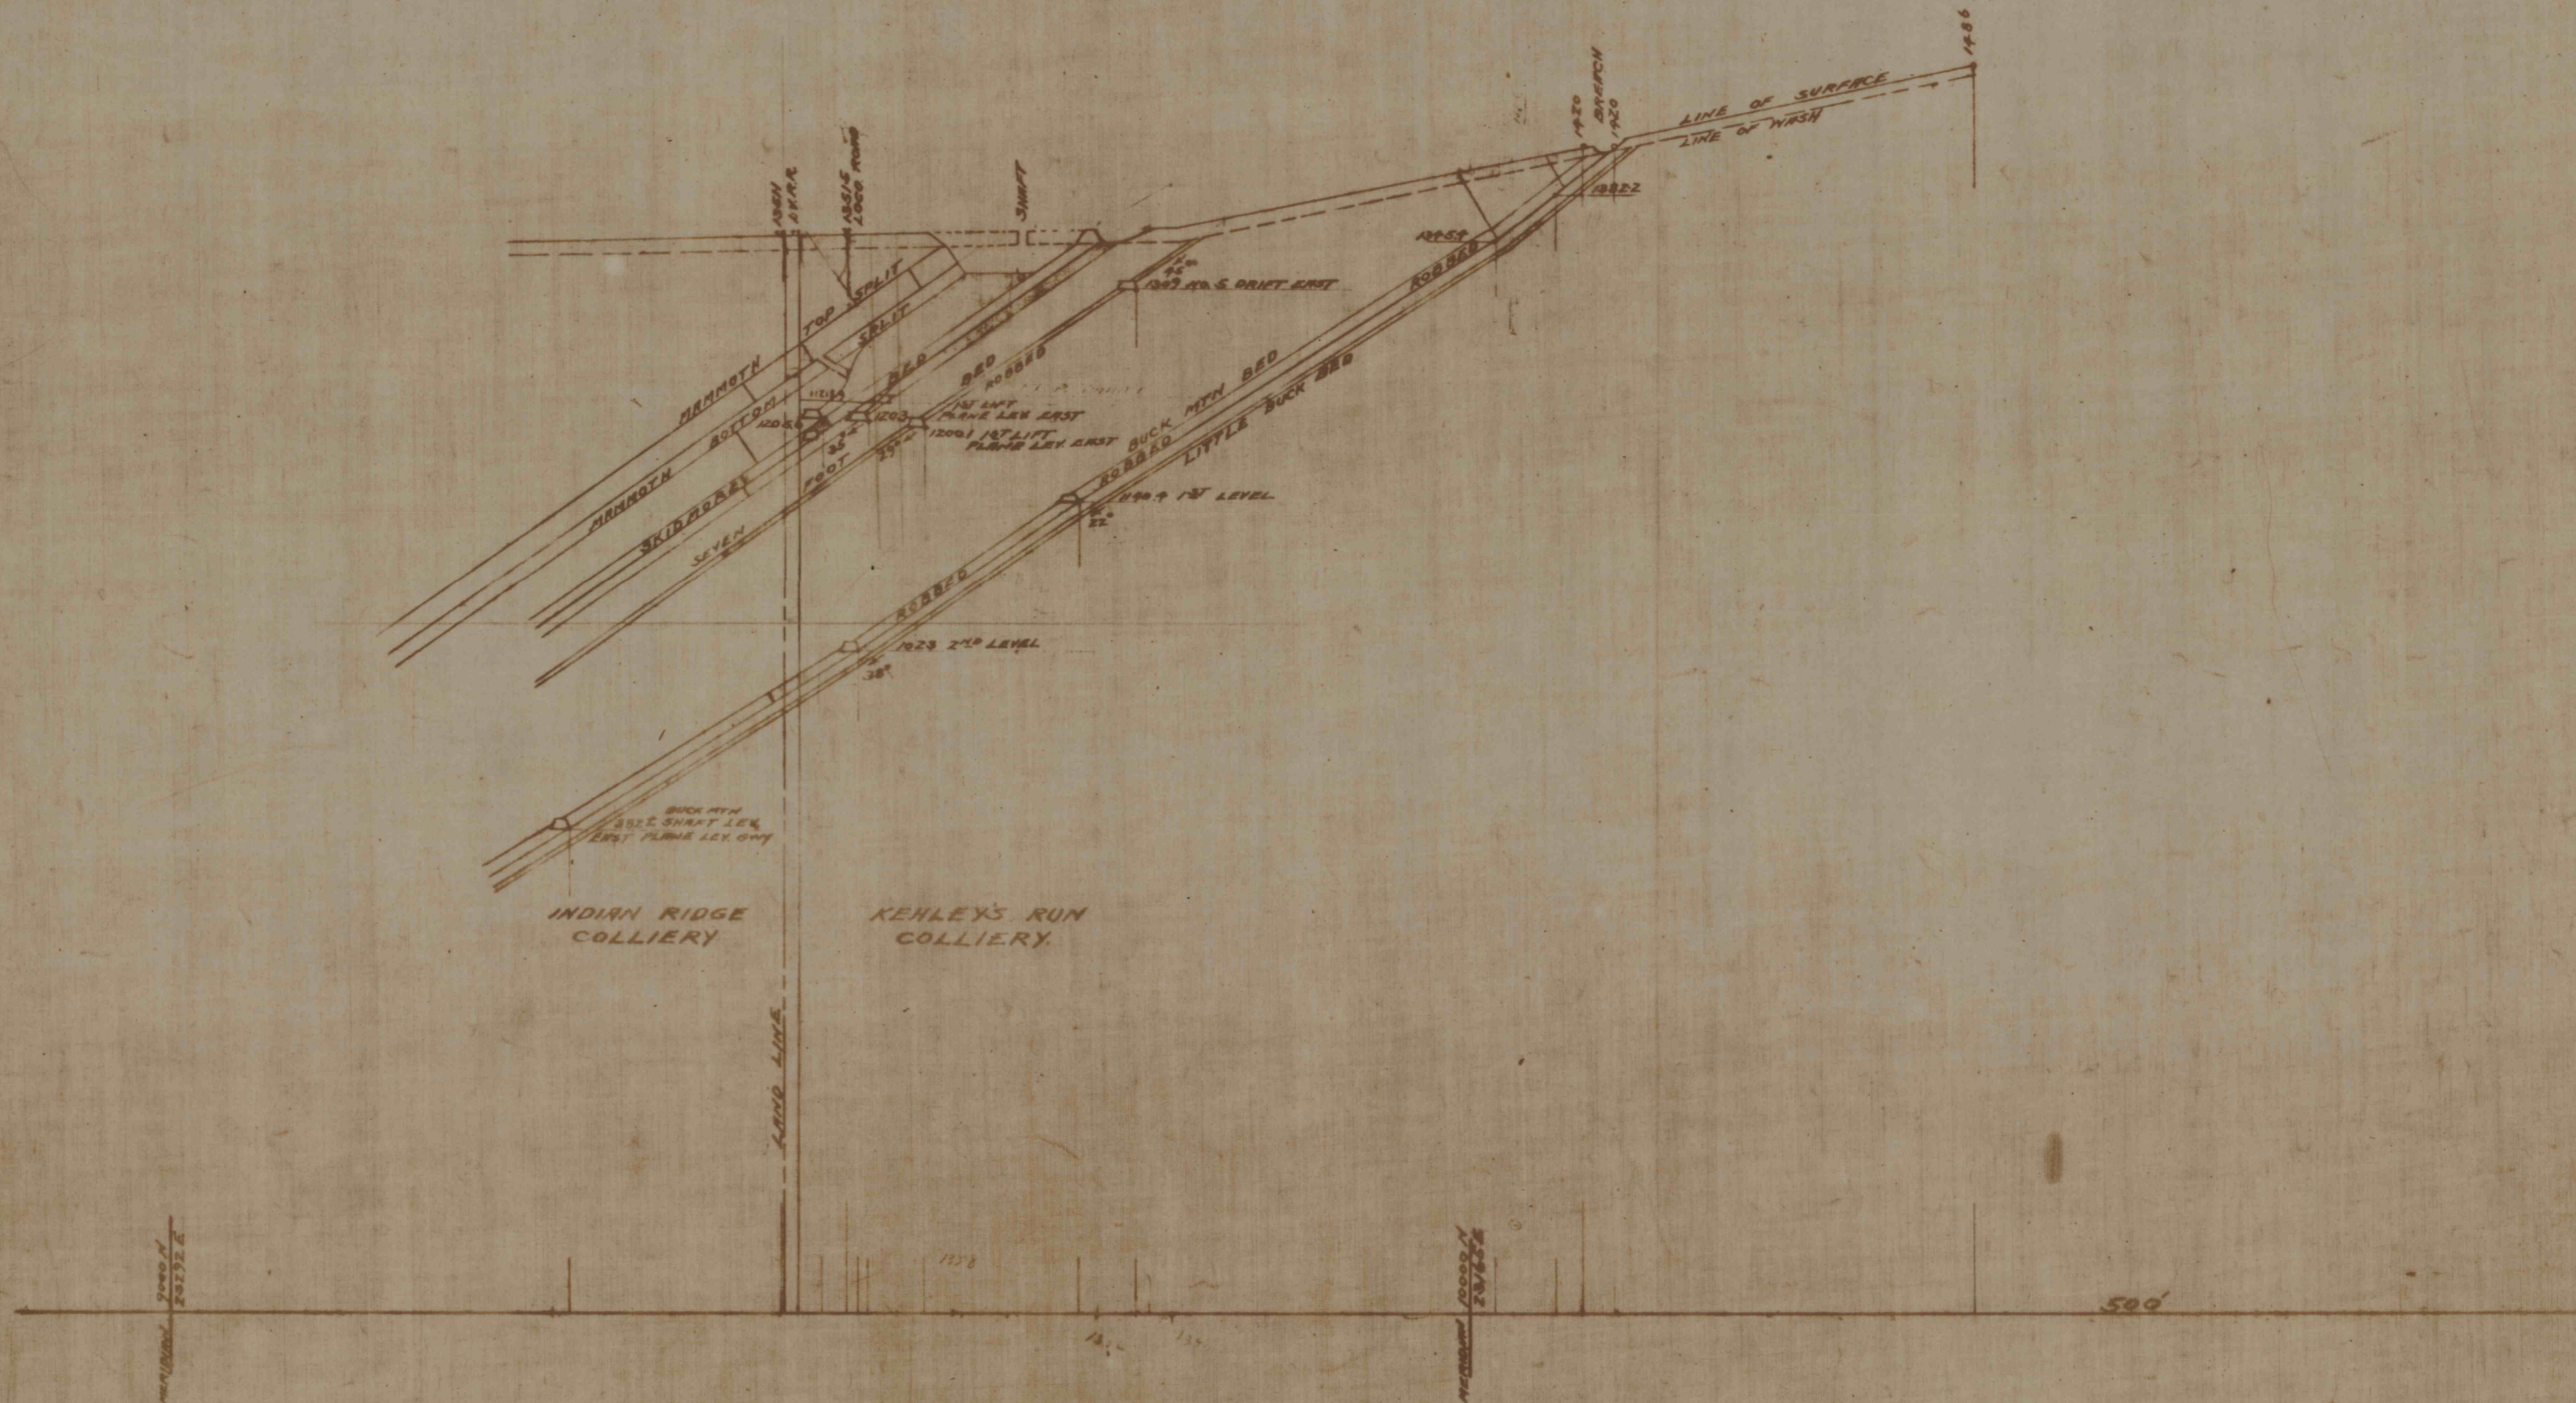

KEHLEYS RUN COLLIERY.
 CROSS SECTION THRO BREAST No. 31 ON FIRST LIFT PLANE LEVEL
 EAST BOTTOM SPLIT GANGWAY.

SCALE 1" = 100'

FERRVILLE, PENNA. THOMAS COLLIERY COMPANY. SHEENBORO, PA. JUNE 3-1877

D-101

C-101