


SECTION #8

LOOKING WEST

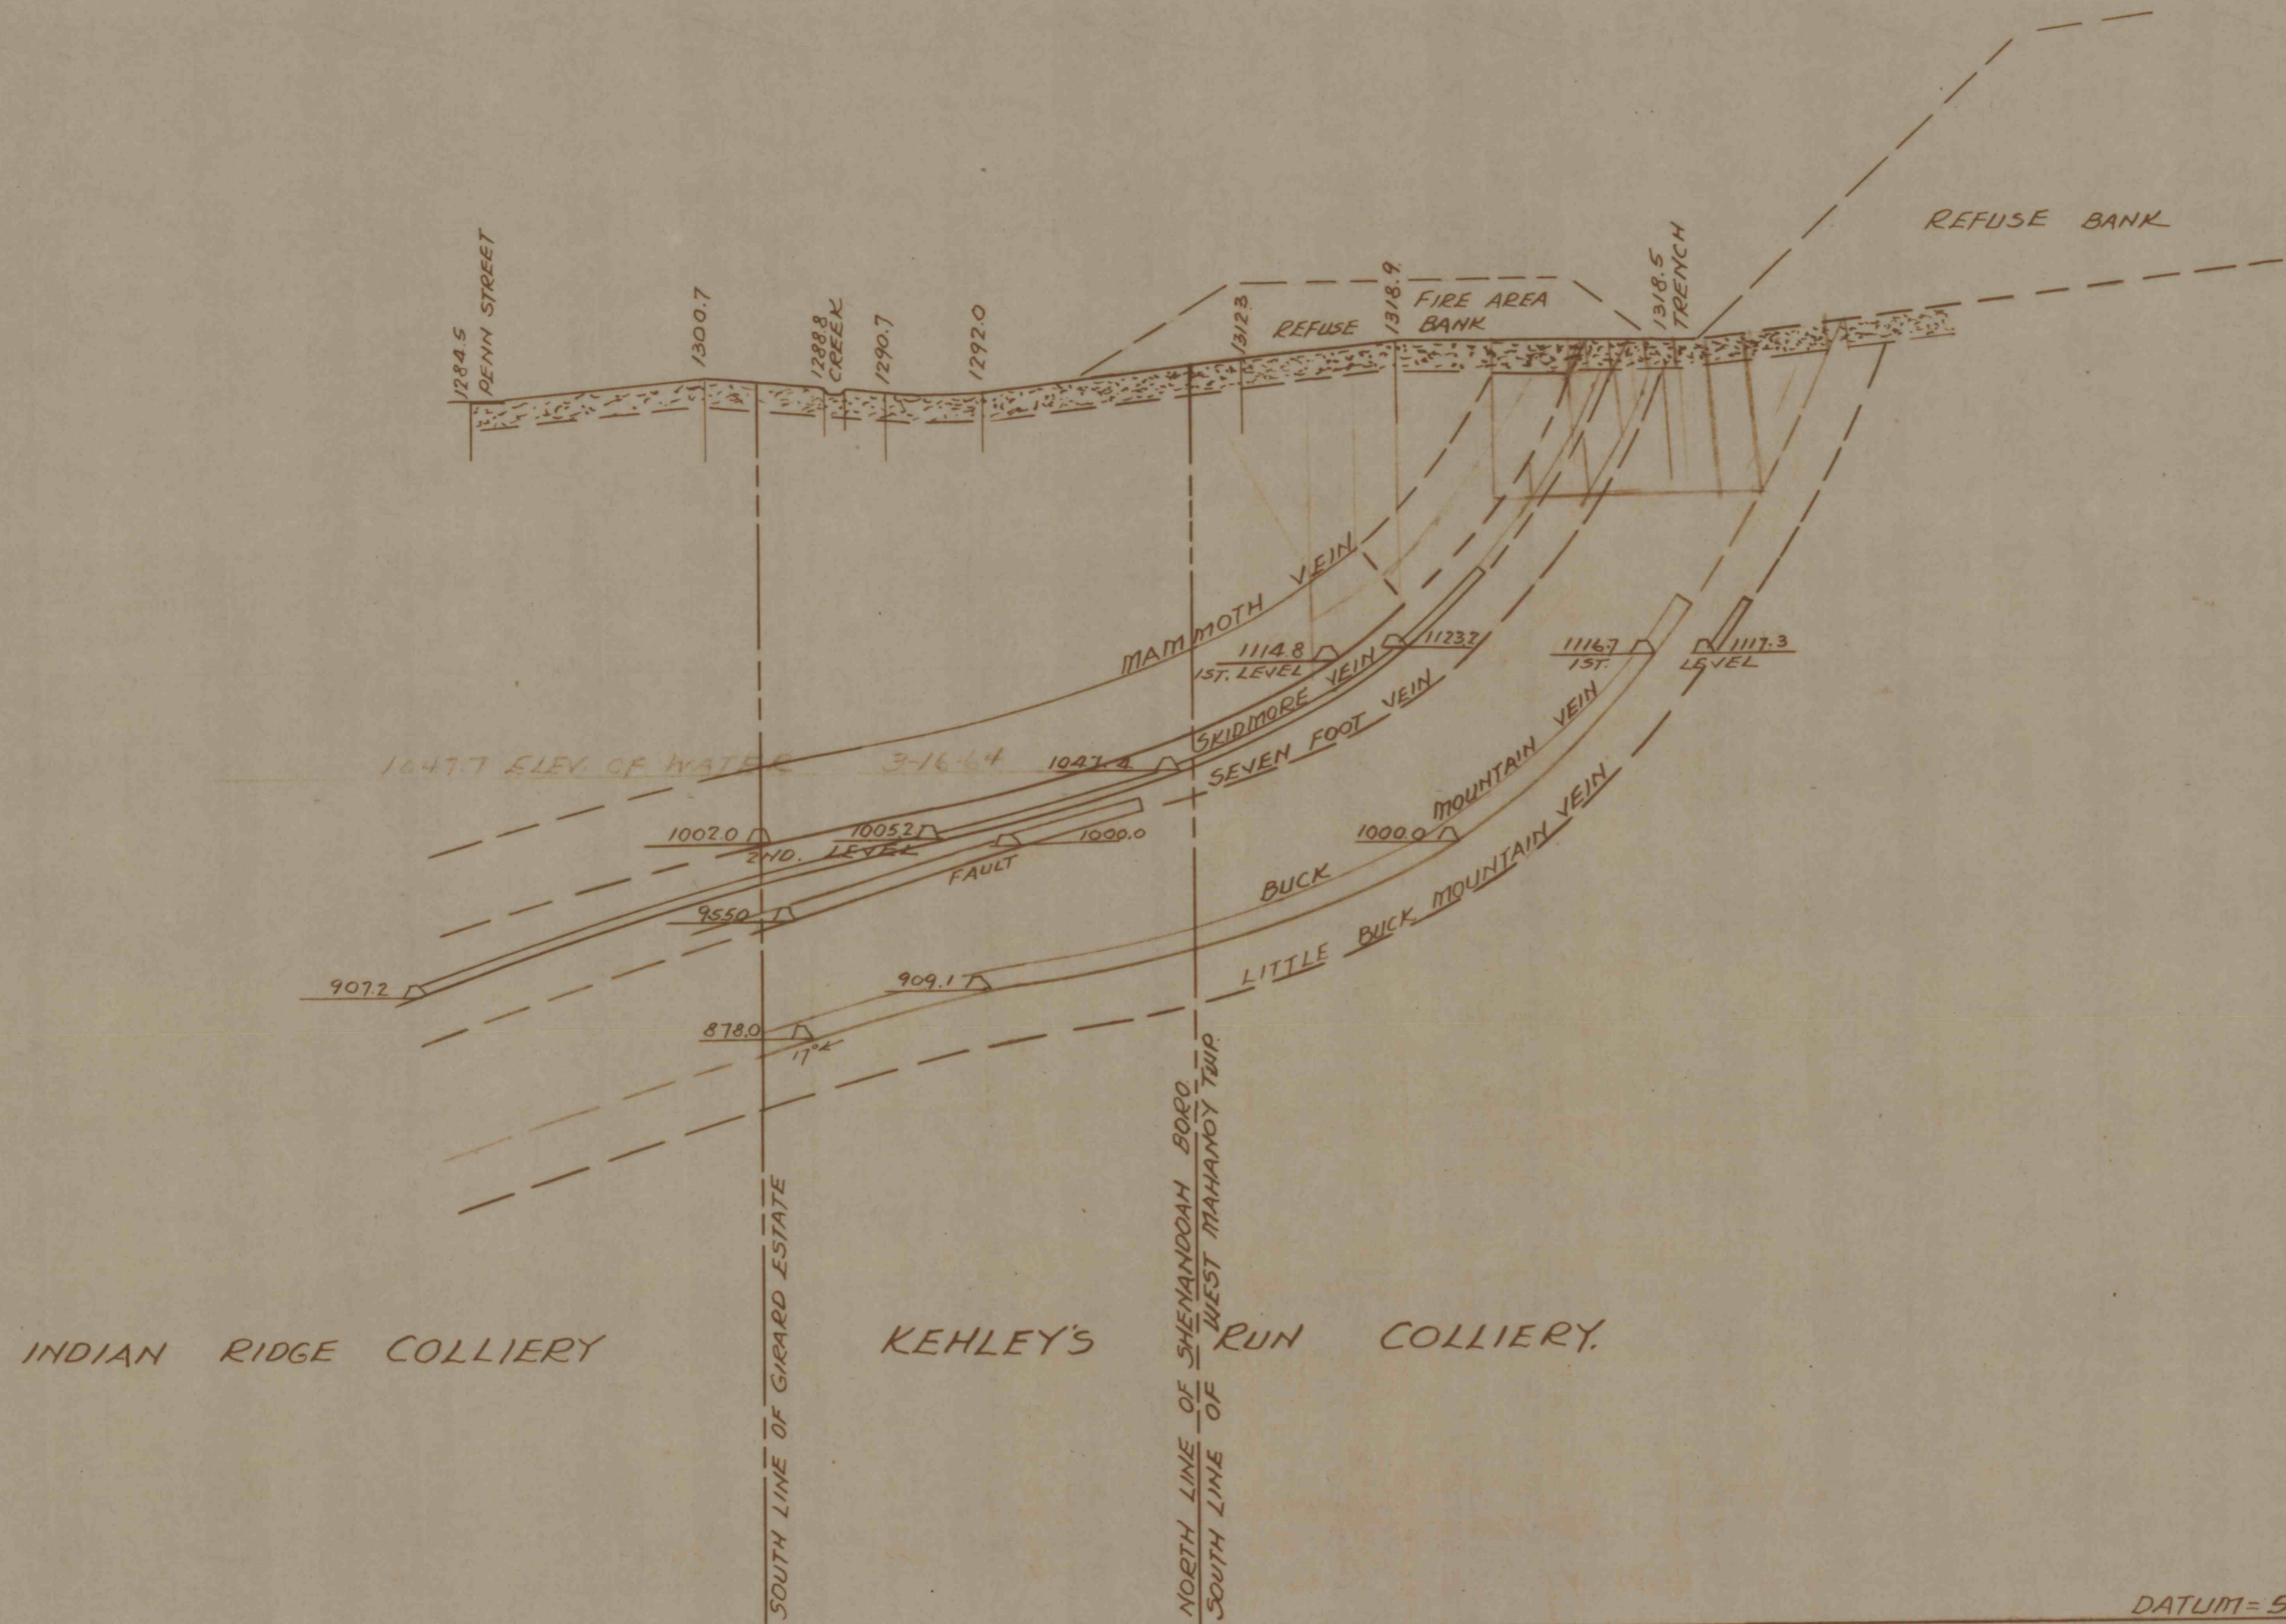

KEHLEY'S RUN COLLIERY.

CROSS SECTION APPROXIMATELY 400' EAST OF MAIN SLOPE
Scale 1"=100'
GIRARDVILLE, PENNA.
MARCH 18, 1964.