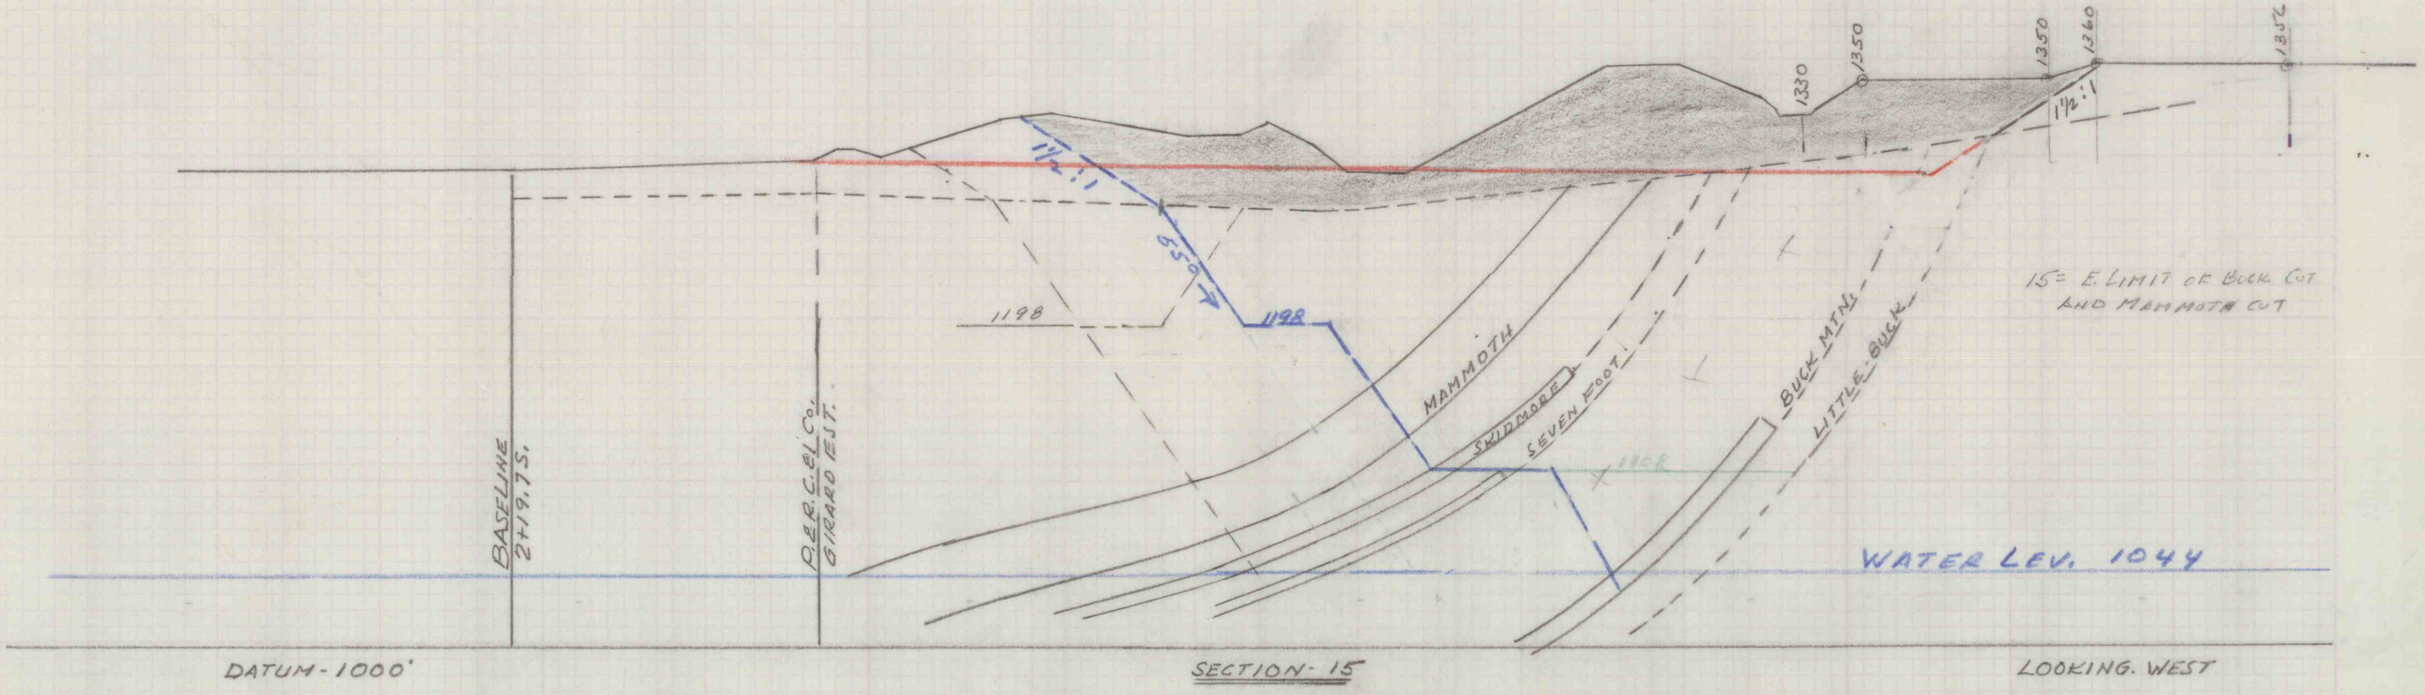
1330
1350
1350
1360
1372
1½:1
1½:1
65°
1198
1198
MAMMOTH
SKIDMORE
SEVEN FOOT
BUCK MTN.
LITTLE BUCK
15= E. LIMIT OF BUCK CUT AND MAMMOTH CUT
BASELINE 2+19.7S.
P.G.R.C.&L.Co. GIRARD EST.
WATER LEV. 1044
DATUM - 1000'
SECTION - 15
LOOKING. WEST