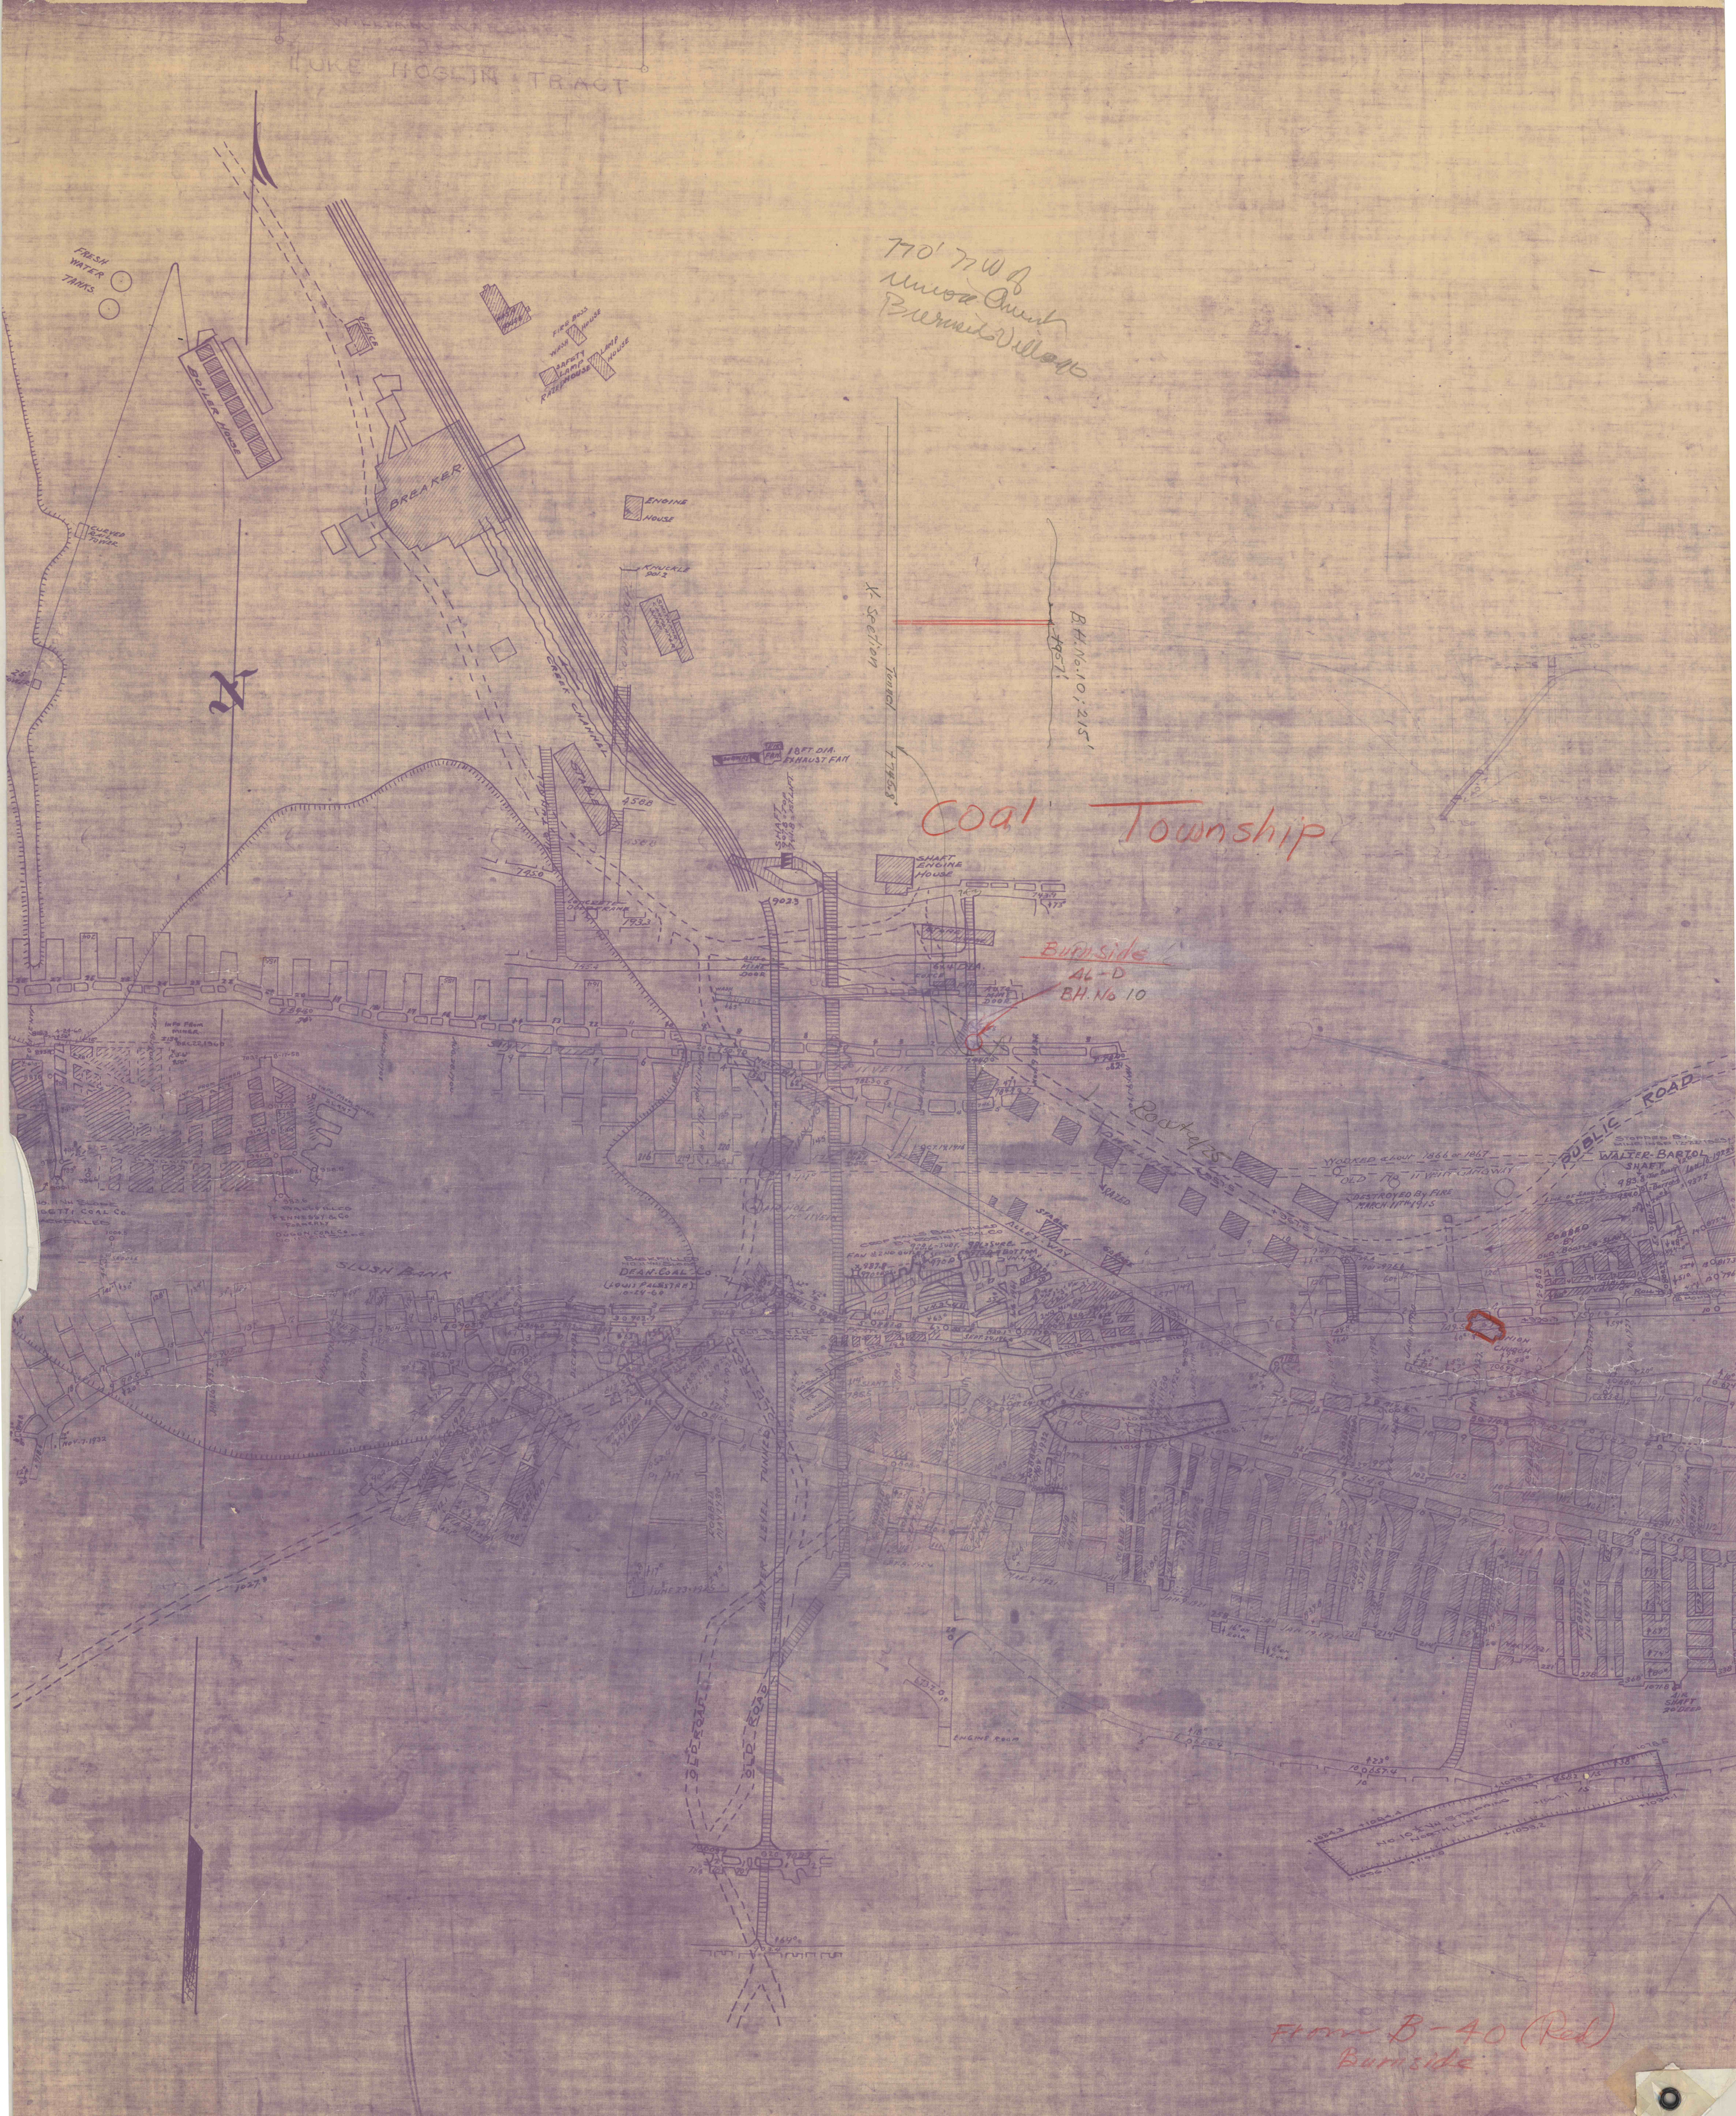
LUKE HOGLIN TRACT
FRESH WATER TANKS
BOILER HOUSE
OFFICE
WASH HOUSE
FIRE BOSS WASH HOUSE
SAFETY LAMP RAZED HOUSE
LAMP HOUSE
BREAKER
ENGINE HOUSE
CURVED RAIL TOWER
KNUCKLE 901.2
CREEK CHANNEL
STABLE
18 FT. DIA. EXHAUST FAN
SHAFT
770' NW of Union Church Burnside Village
X-Section
Tunnel 774.5.8'
B.H. No. 10; 215'
Coal Township
SHAFT ENGINE HOUSE
Burnside
A6-D
B.H. No 10
CONCRETE DOOR FRAME
AUTO MINE DOOR
INFO FROM MINER
NOV. 7. 1932
SLUSH BANK
FENNESSY & CO FORMERLY DUGON COAL CO
DEAN COAL CO
(LOUIS PALESTRE) 10-24-60
DWELLINGS
RAZED
STABLE
ALLEY WAY
GARAGE
Roasted 25
WORKED about 1866 or 1867
OLD No. 11 VEIN GANGWAY
DESTROYED BY FIRE MARCH 11TH 1915
PUBLIC ROAD
WALTER-BARTOL SHAFT
LINE OF SADDLE
ROBBED BY OLD BOOTLEG SLANT
UNION CHURCH
WATER LEVEL TUNNEL
OLD ROAD
ENGINE ROOM
AIR SHAFT 20' DEEP
No. 10 1/2 Vn STRIPPING NORTH LINE
JUNE 23. 1925
JAN. 19. 1921
MAR. 9. 1921
From B-40 (Red)
Burnside