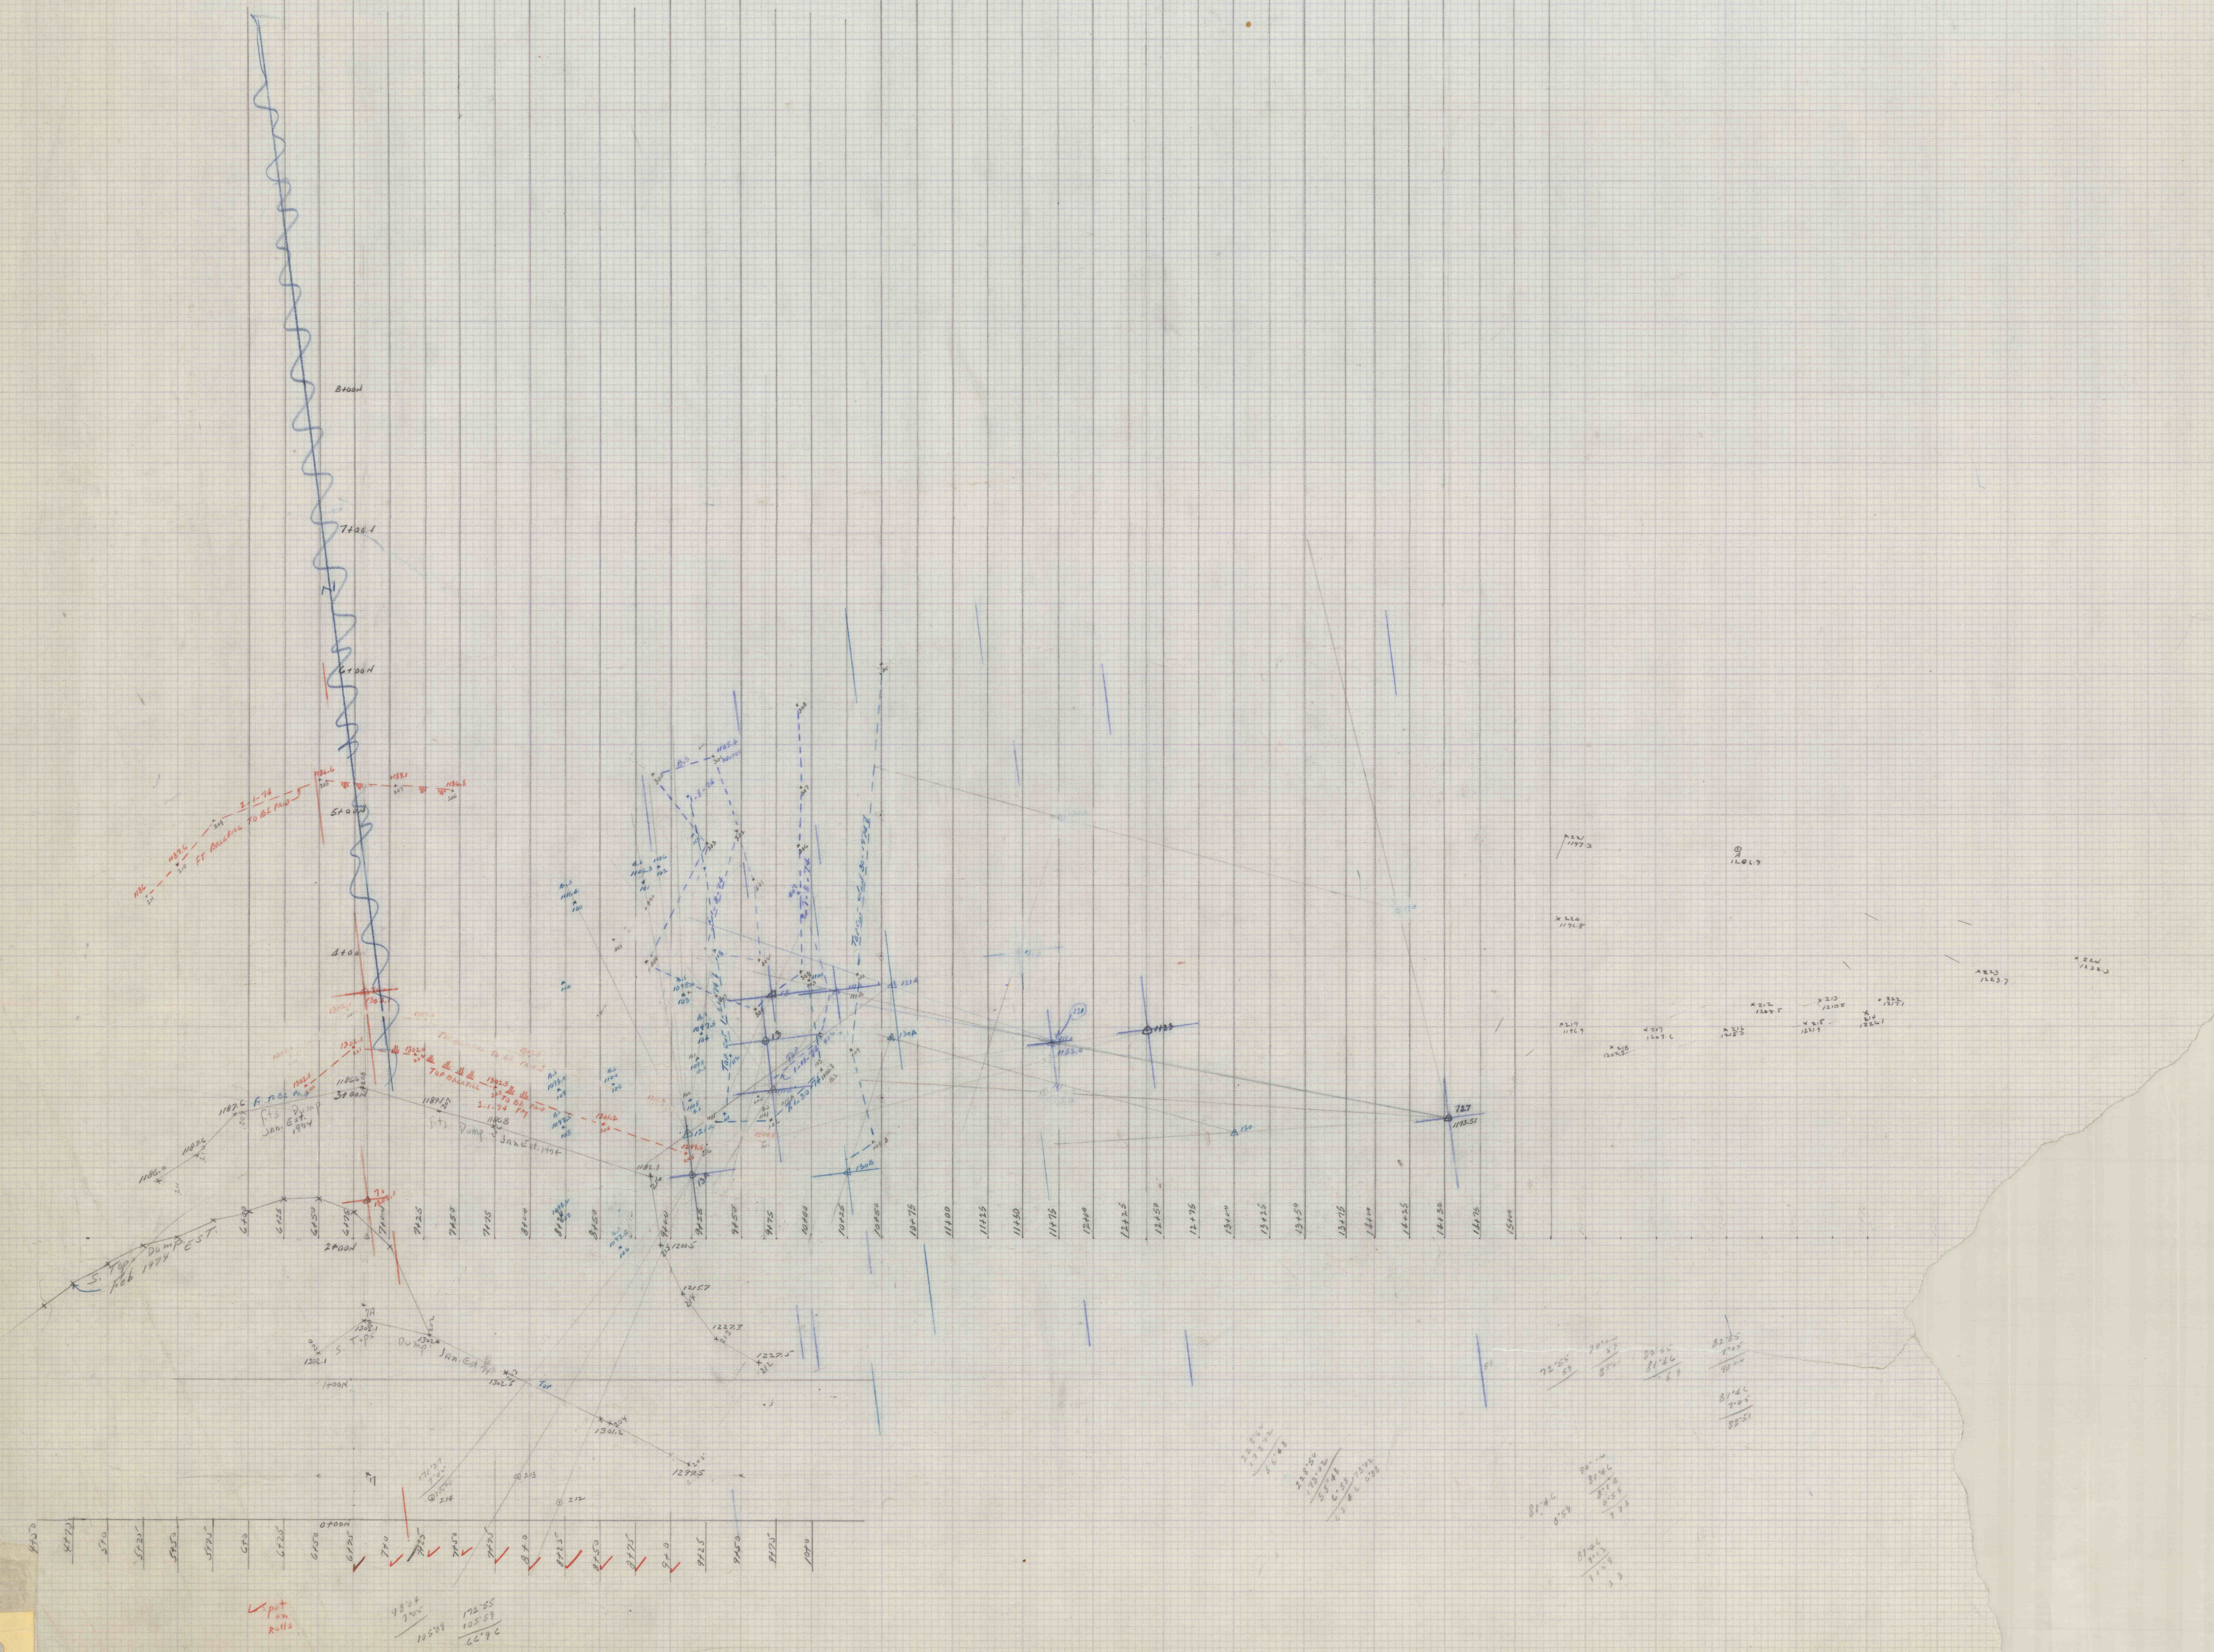
8+00N
7+00.1
6+00N
5+00N
4+00
3+00N
2+00N
1+00N
0+00N
FT BACKFILL TO BE PAID
2-1-74
TOP BACKFILL
TO BE PAID
2-1-74 PM
FT TO BE PAID
S. Tops Dump Jan. Est. 1974
S. Tops Dump Jan Est. 1974
S. Tops Dump Feb 1974 EST
S. Tops Dump Jan. Est 74
Top
Top Cut 1-8-74
7+00
7+25
7+50
7+75
8+00
8+25
8+50
9+00
9+25
9+50
9+75
10+00
10+25
10+50
10+75
11+00
11+25
11+50
11+75
12+00
12+25
12+50
12+75
13+00
13+25
13+50
13+75
14+00
14+25
14+50
14+75
15+00
727
1193.51
1123
130
130A
130B
spot on Rolls