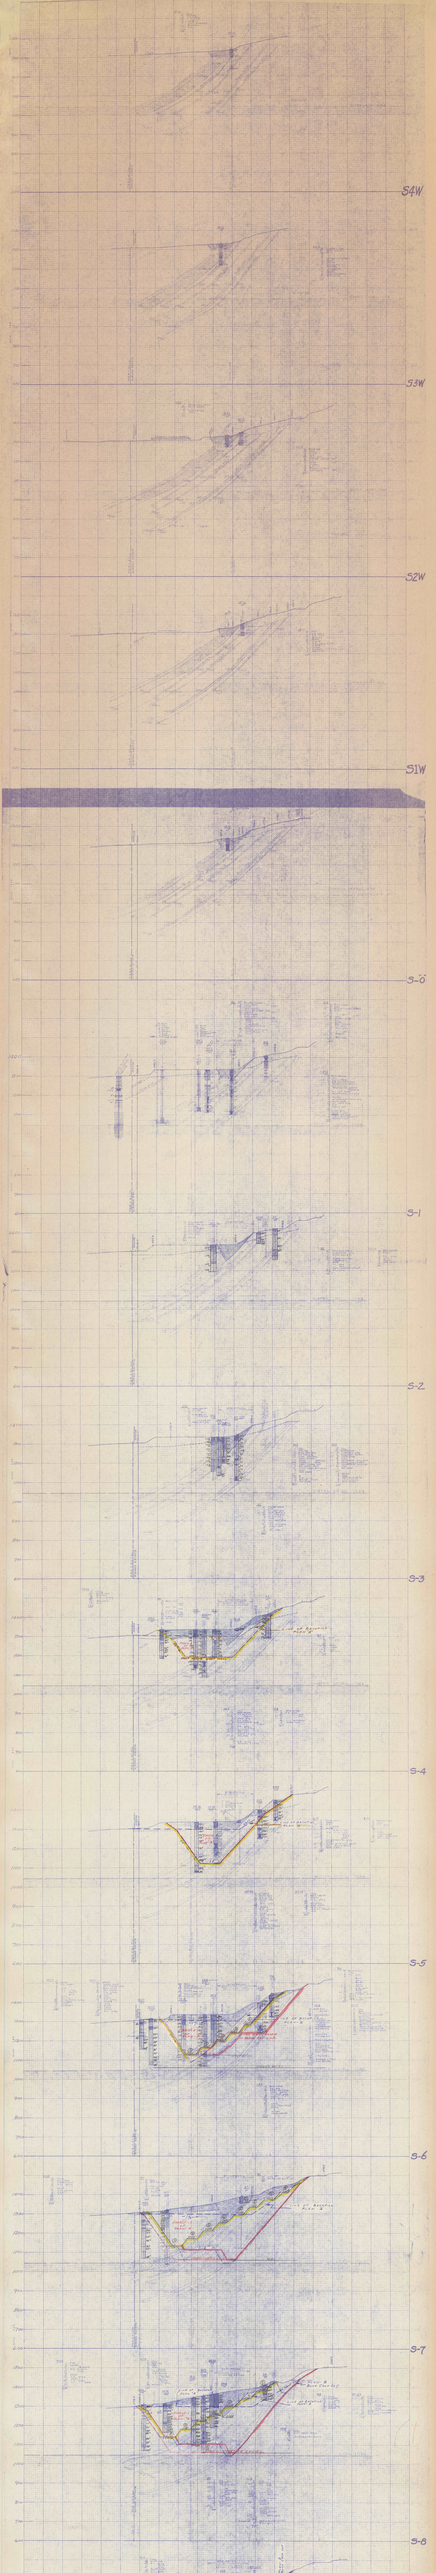
S4W
S3W
S2W
S1W
S-0
S-1
S-2
S-3
S-4
S-5
S-6
S-7
S-8