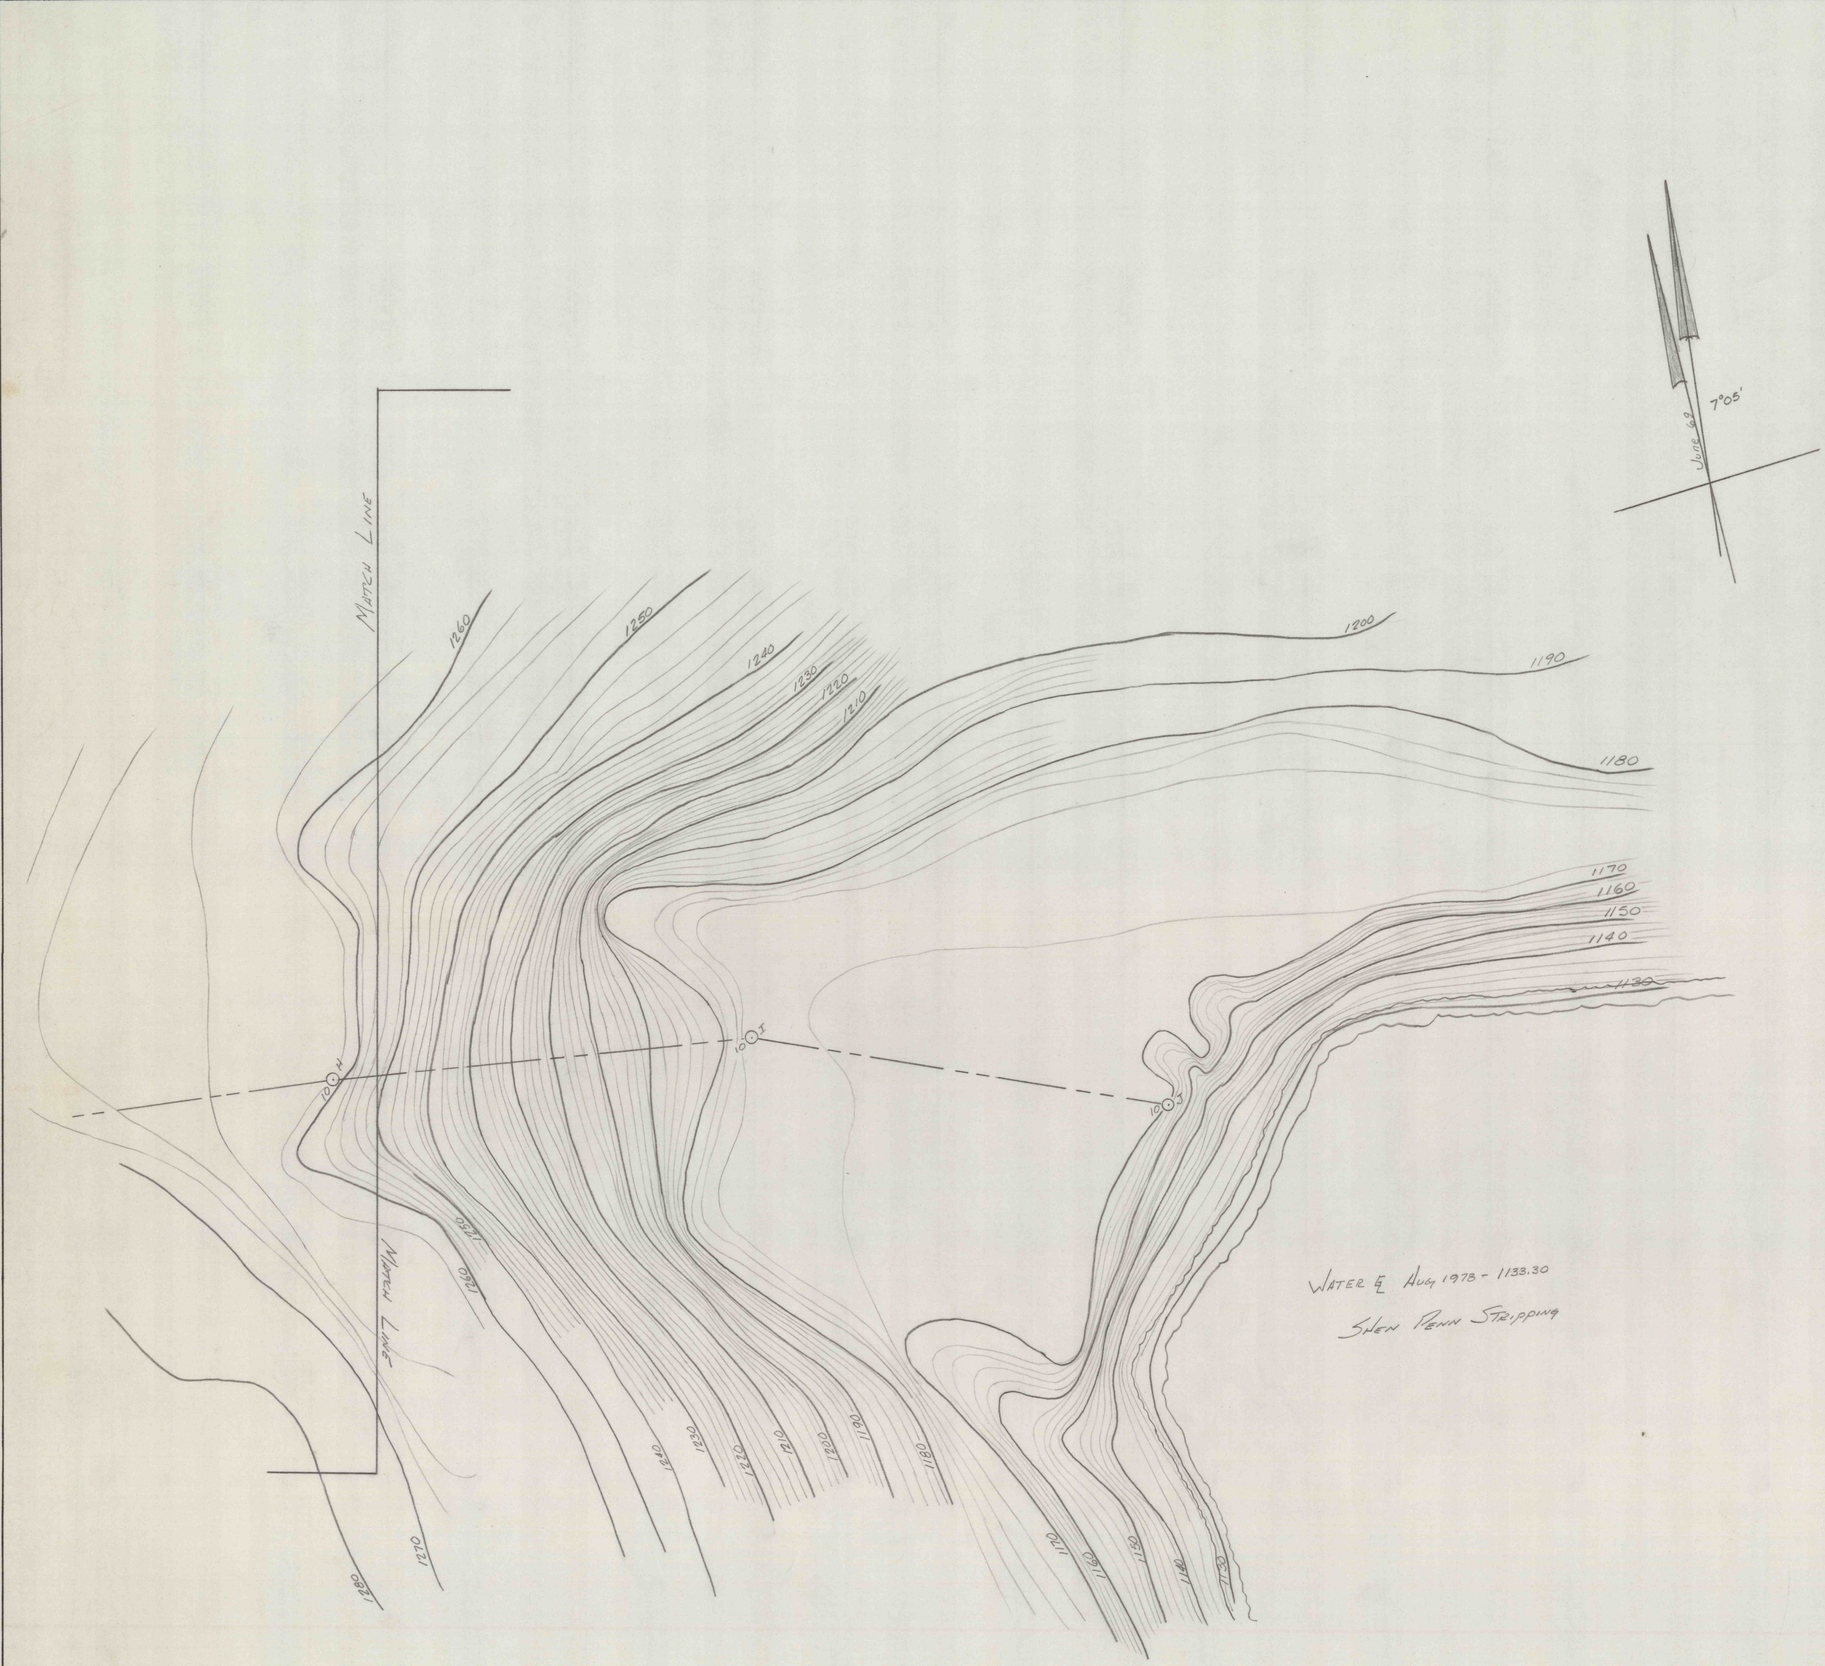

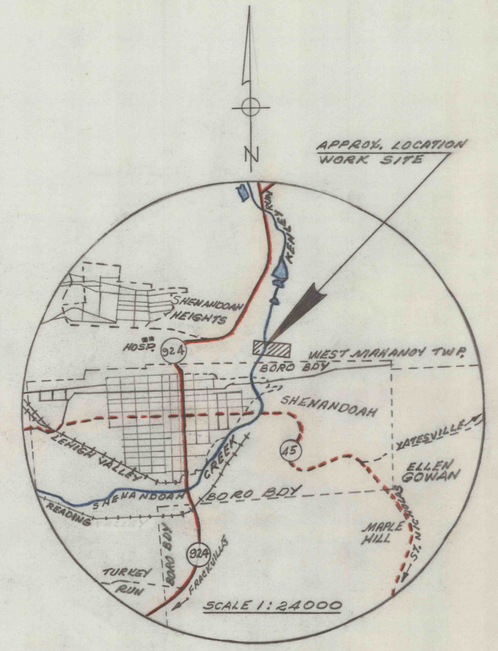

VOID

KEHLEY RUN TOPO
SL 309-2-101.2
SURVEY AUG. 1978
SCALE 1" = 40