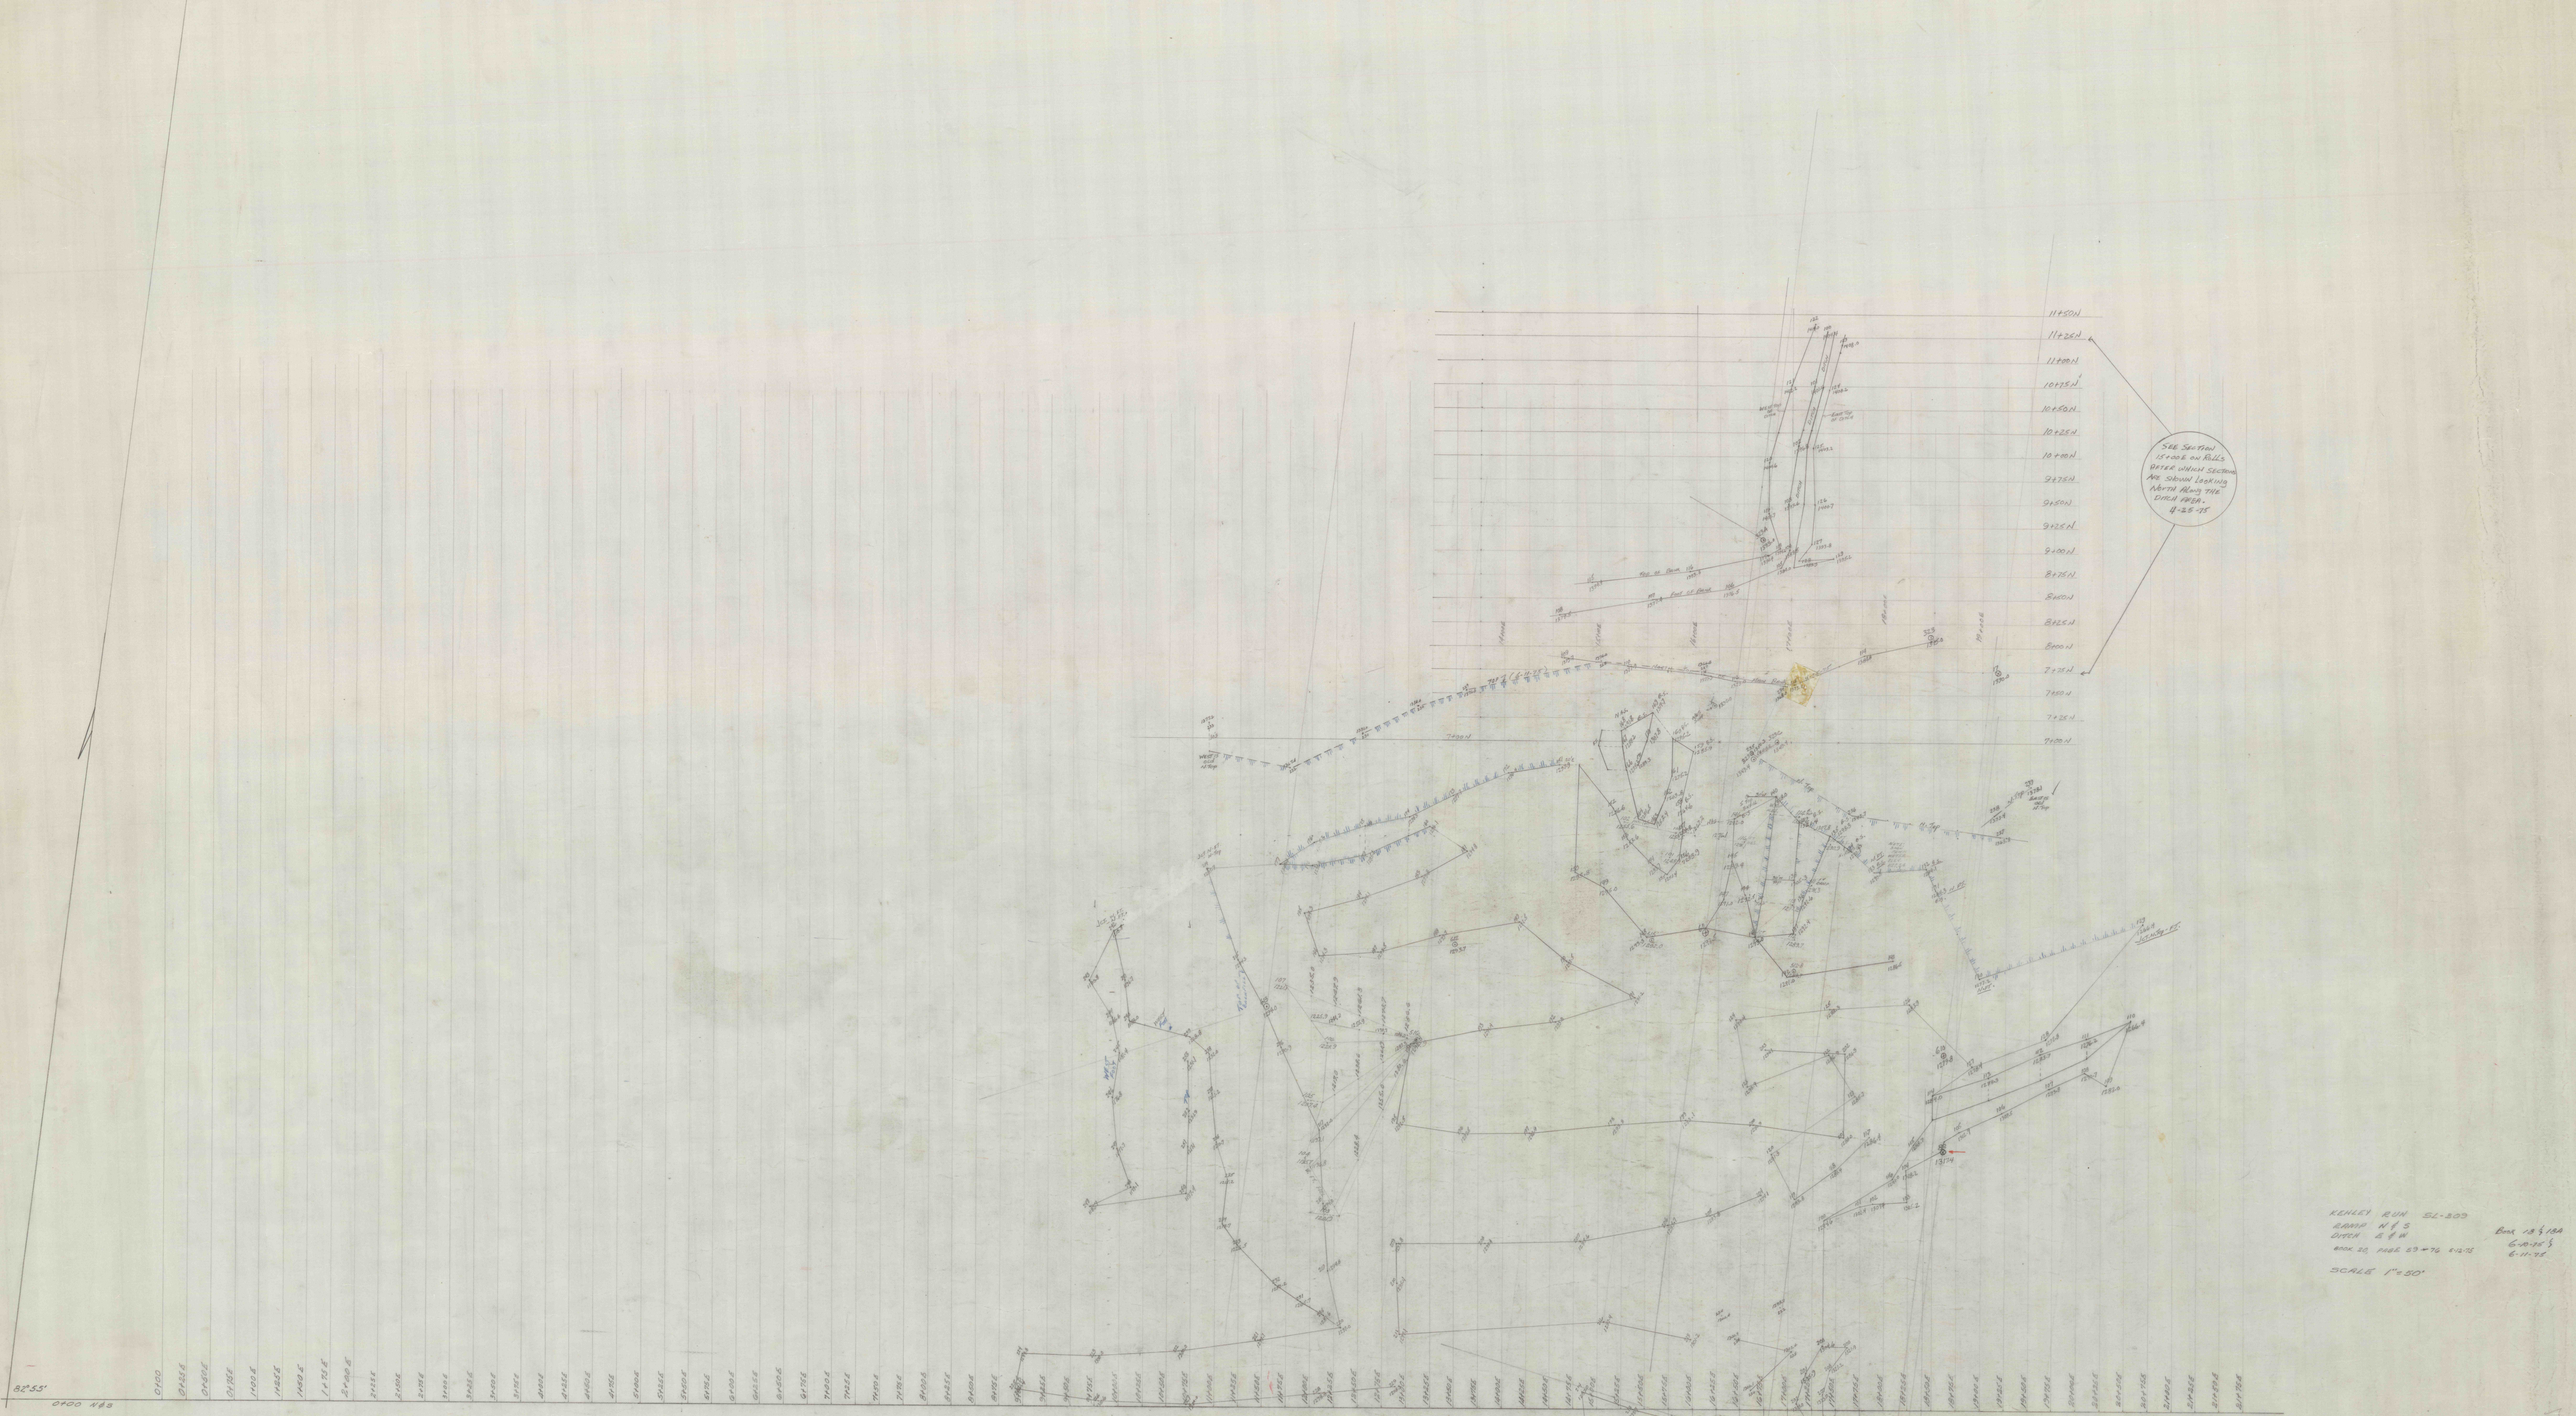
11+50N
11+25N
11+00N
10+75N
10+50N
10+25N
10+00N
9+75N
9+50N
9+25N
9+00N
8+75N
8+50N
8+25N
8+00N
7+75N
7+50N
7+25N
7+00N
SEE SECTION 15+00E on ROLLS BEYER WHICH SECTIONS ARE SHOWN LOOKING NORTH ALONG THE DITCH LINE. 4-25-75
KENLEY RUN SL-803
RAMP #1
DITCH A & B
BOOK 20, PAGE 29-76 4-14-75
BOOK 13 & 18A
6-10-75 &
6-11-75
SCALE 1"=50'
B2°55'
0+00 N83