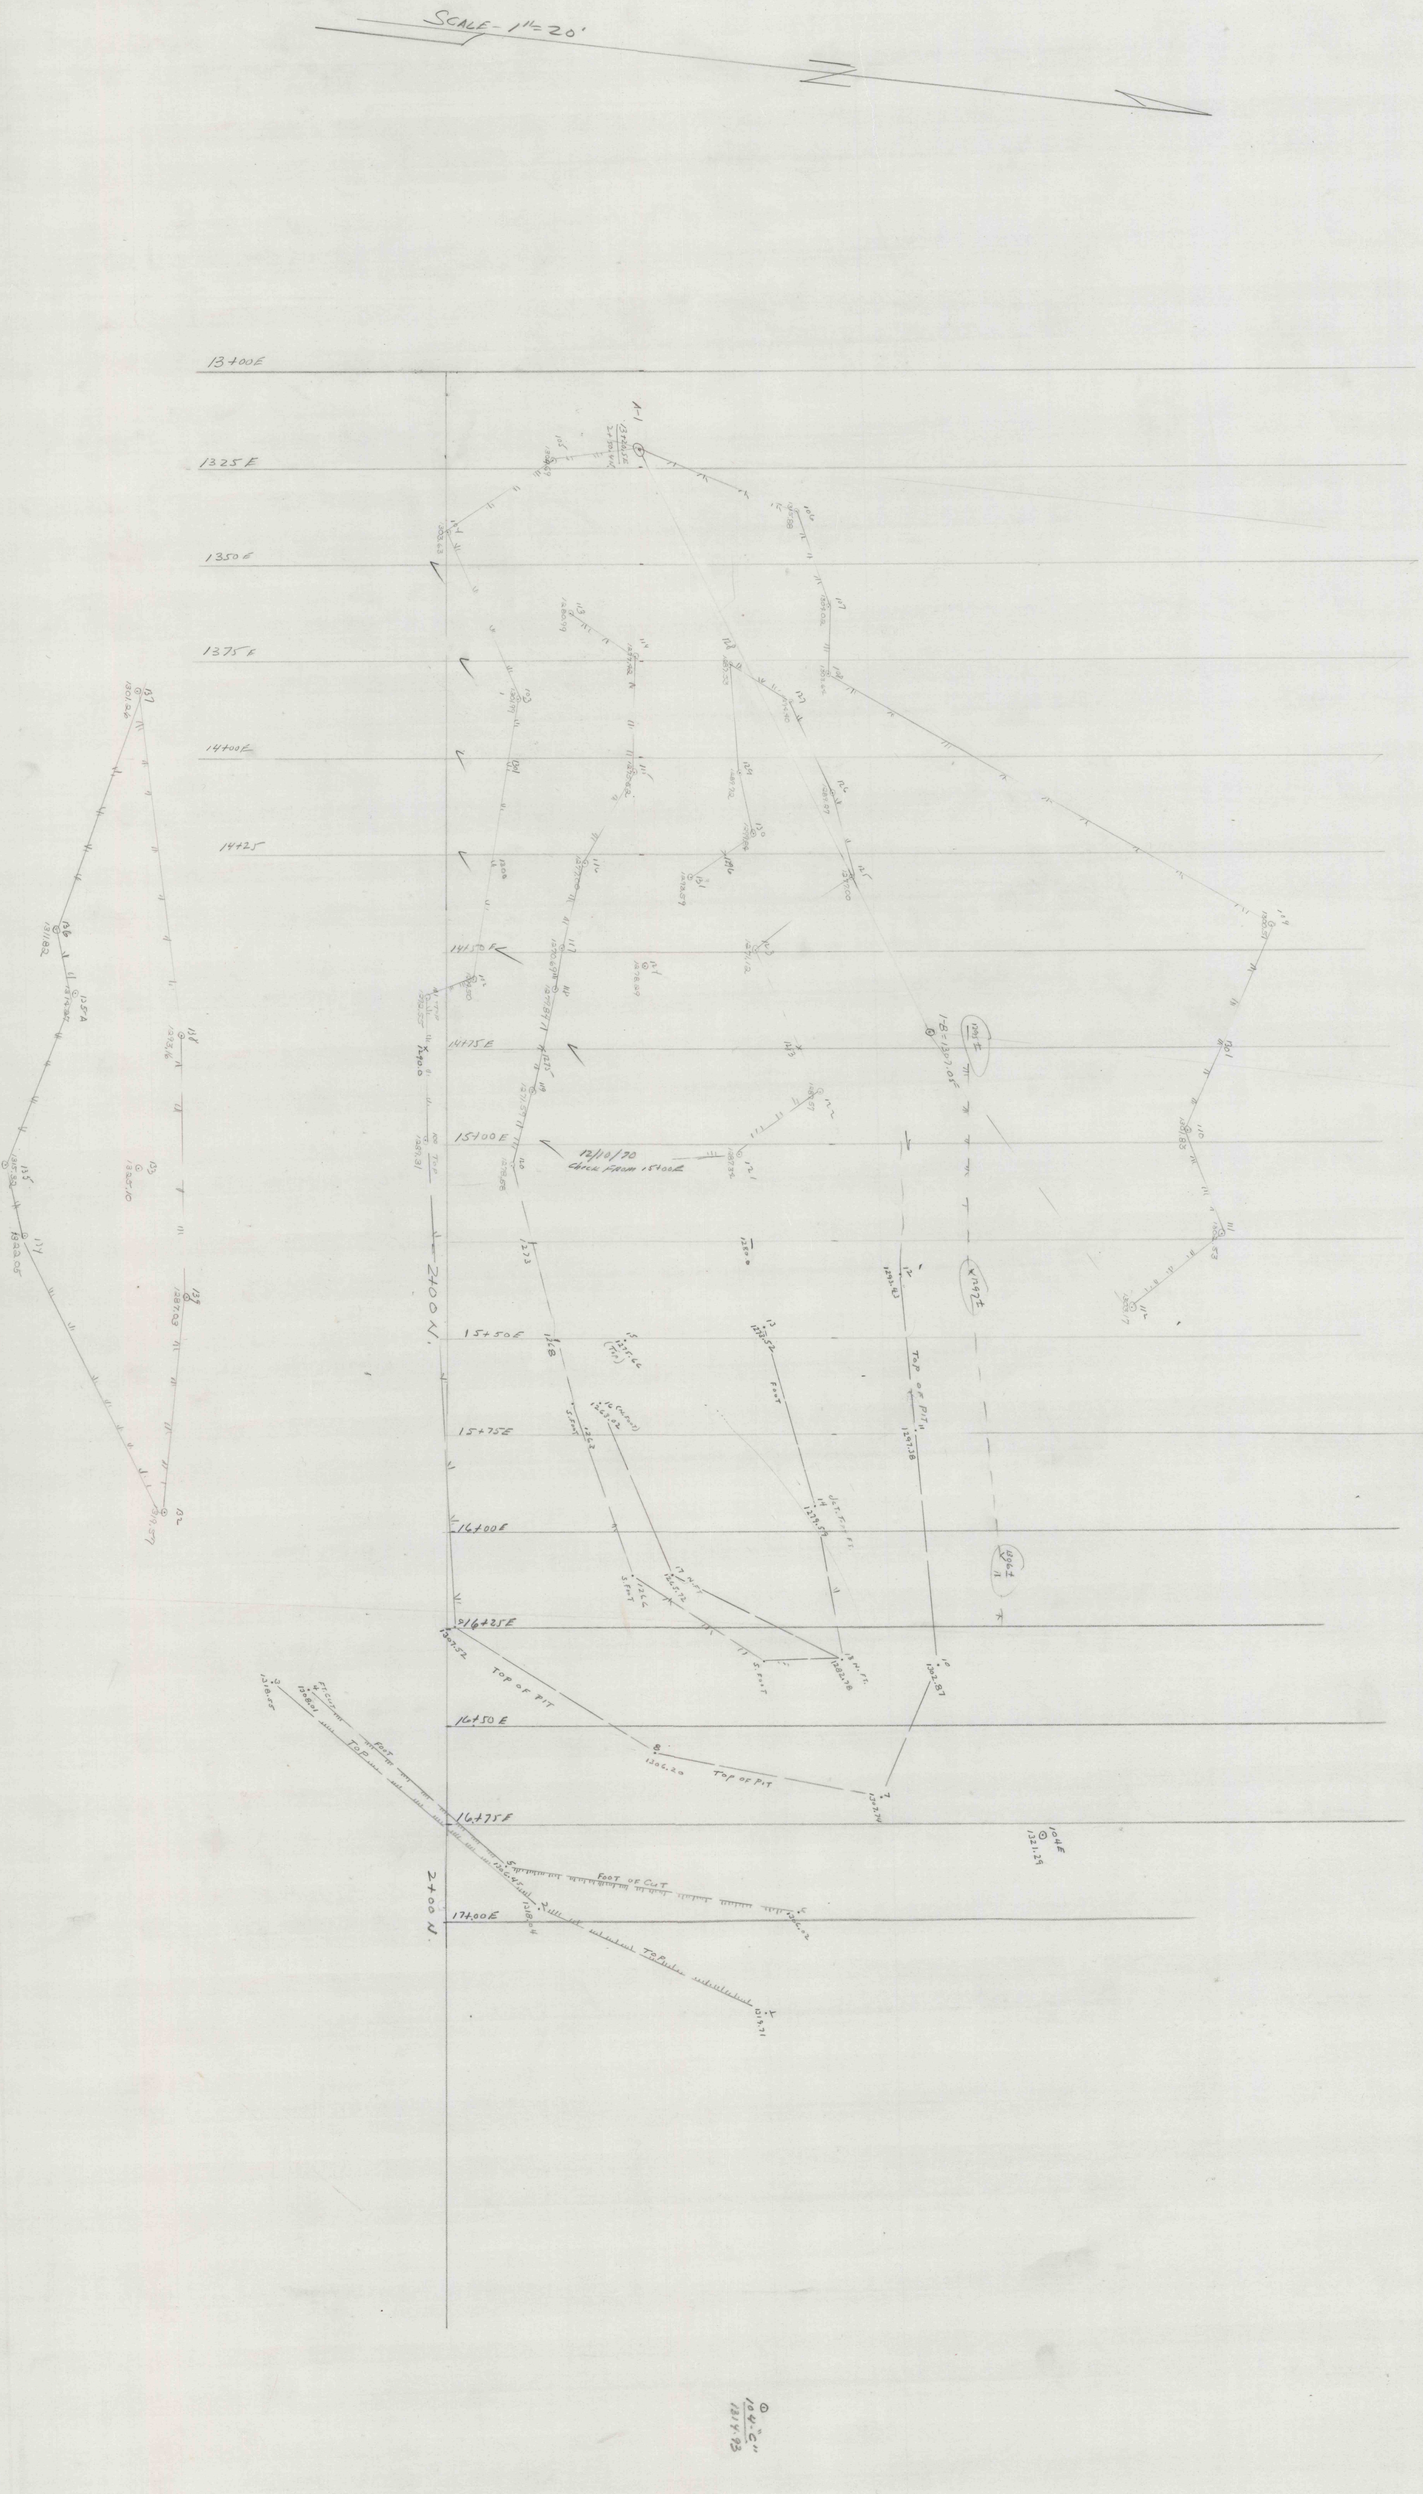
SCALE - 1" = 20'
13+00E
1325E
1350E
1375E
14+00E
14+25
14+50E
14+75E
15+00E
15+50E
15+75E
16+00E
16+25E
16+50E
16+75E
17+00E
2400 N.
2400 N.
12/10/70
CHECK FROM 15+00E
TOP OF PIT
TOP OF PIT
TOP OF PIT
FOOT OF CUT
TOP
FOOT
TOP
104"C"
1314.93