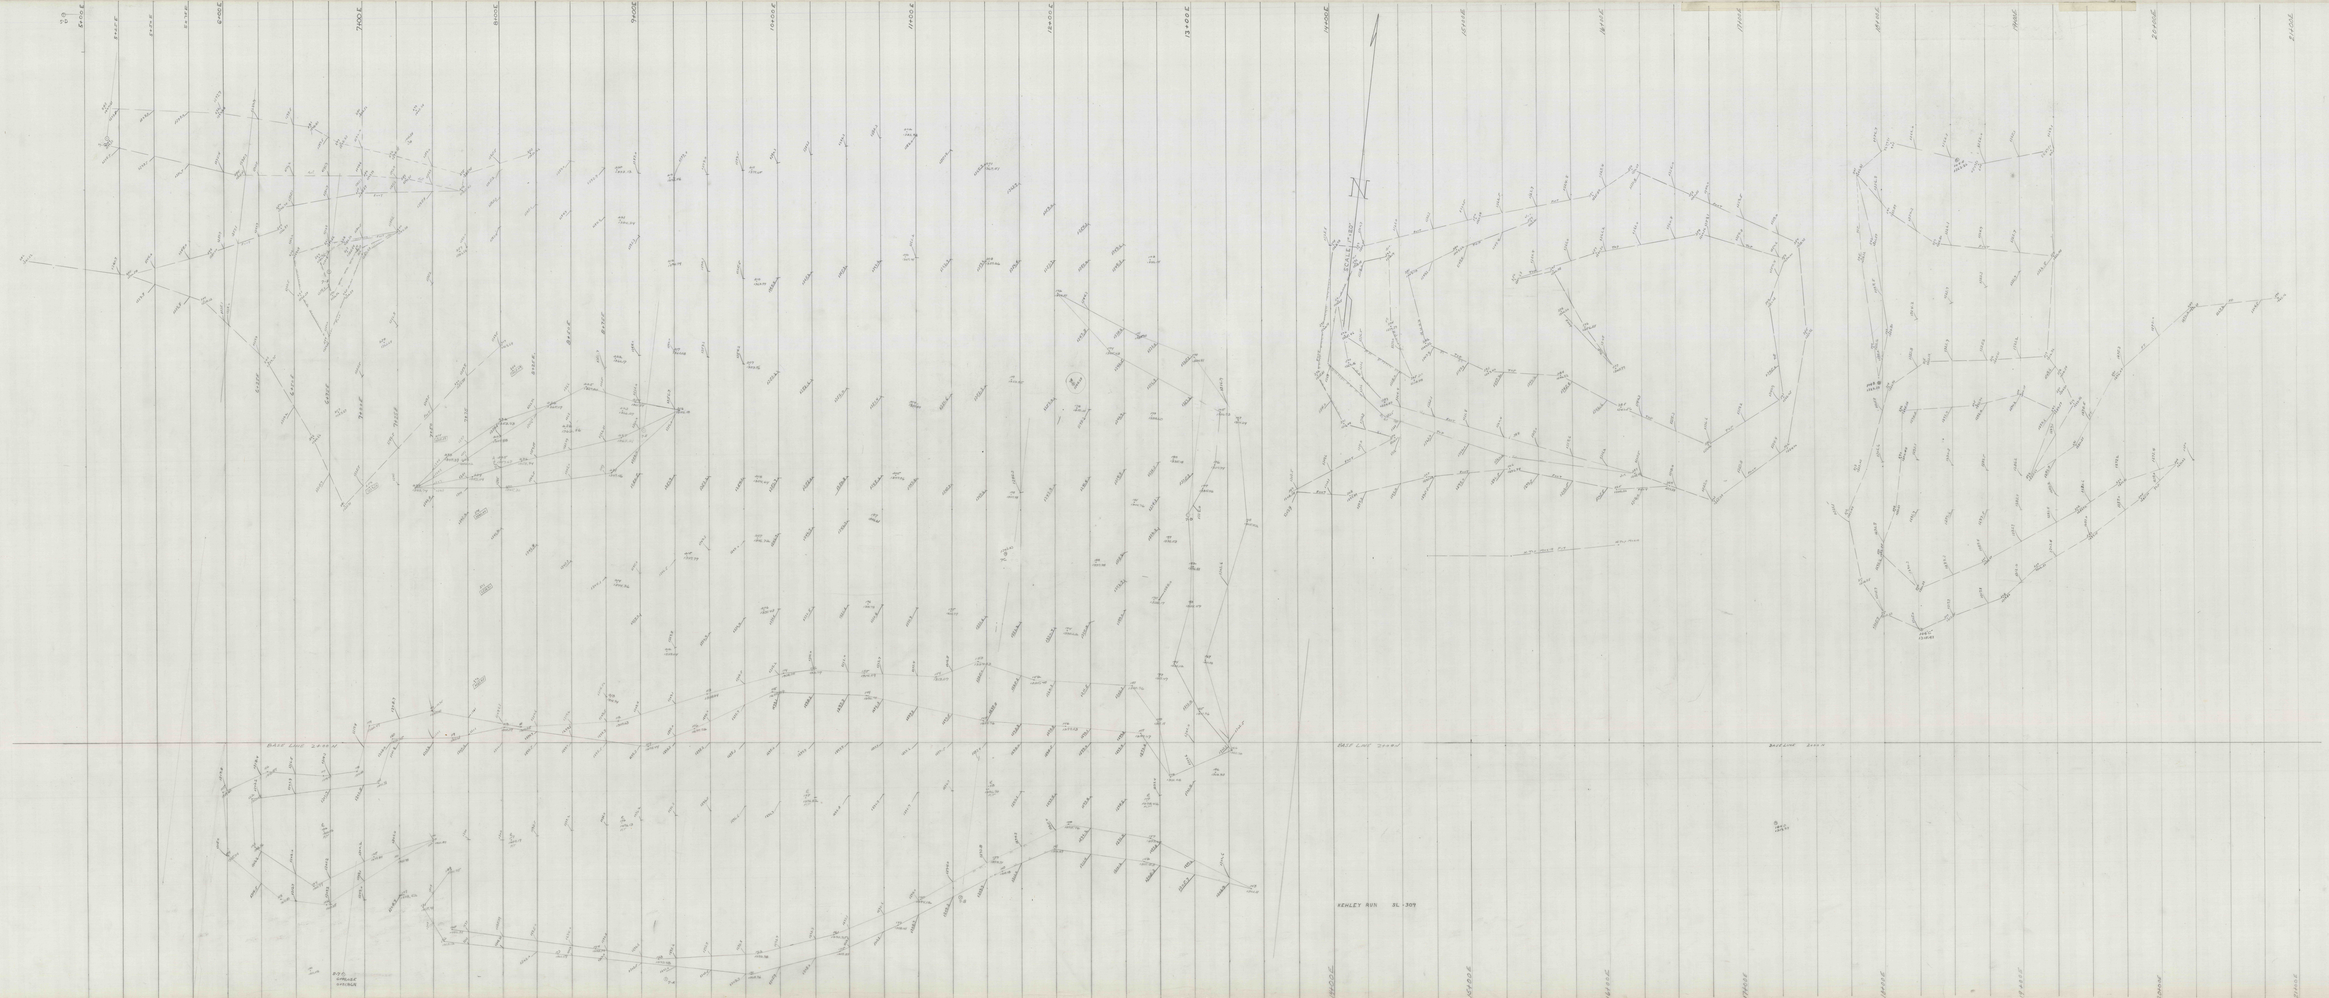
N
BASE LINE 2000N
BASE LINE 1000N
BASELINE 0000N
KENLEY RUN SL-307