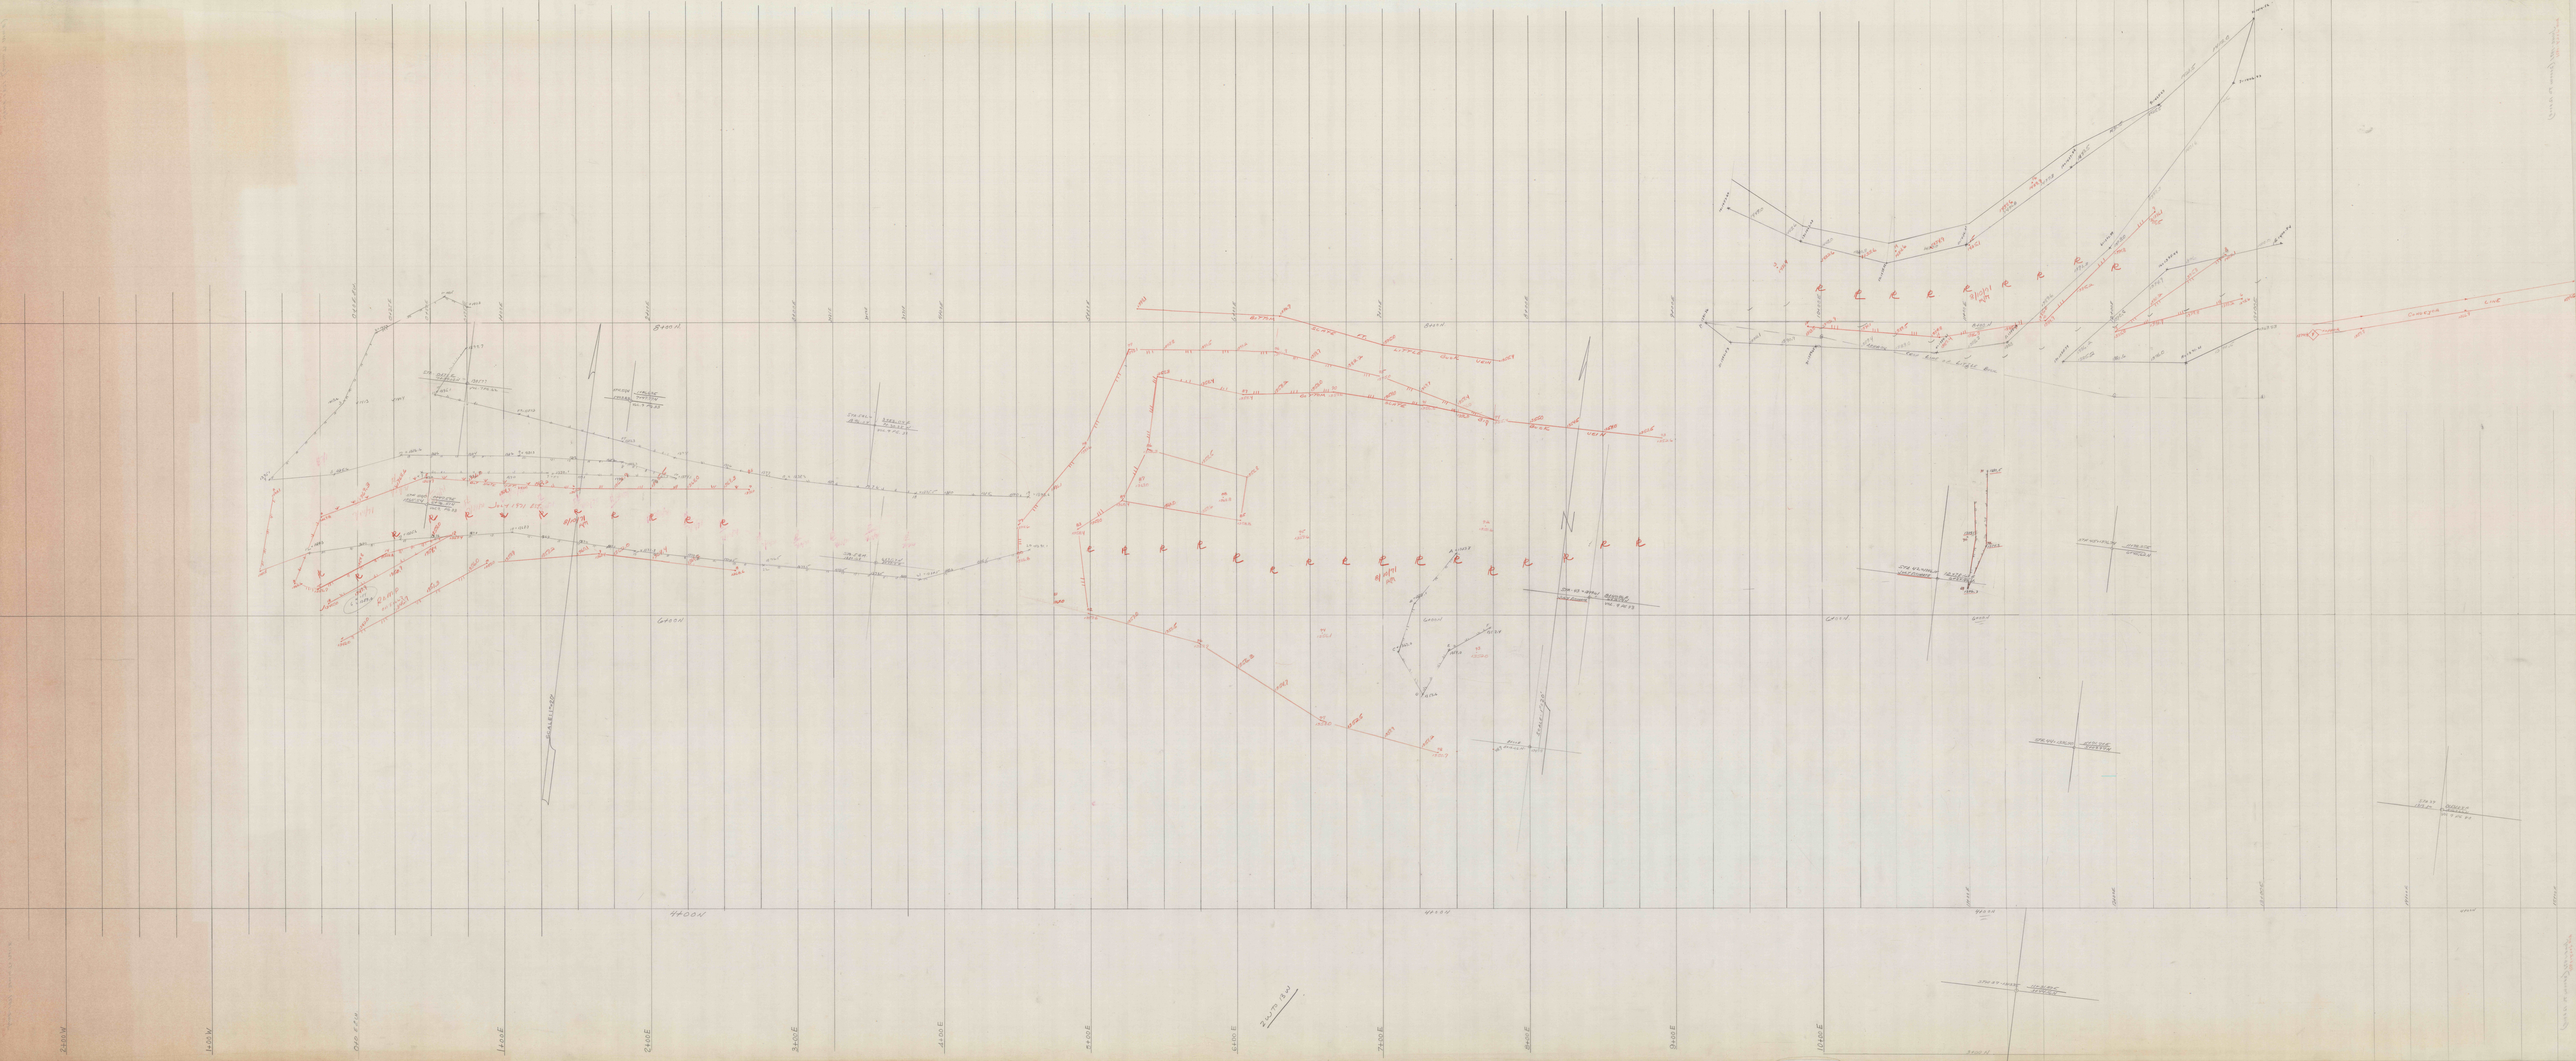
2200W
1400W
1200E
2400E
3400E
4400E
5400E
6400E
7400E
8400E
9400E
10400E
8400N
