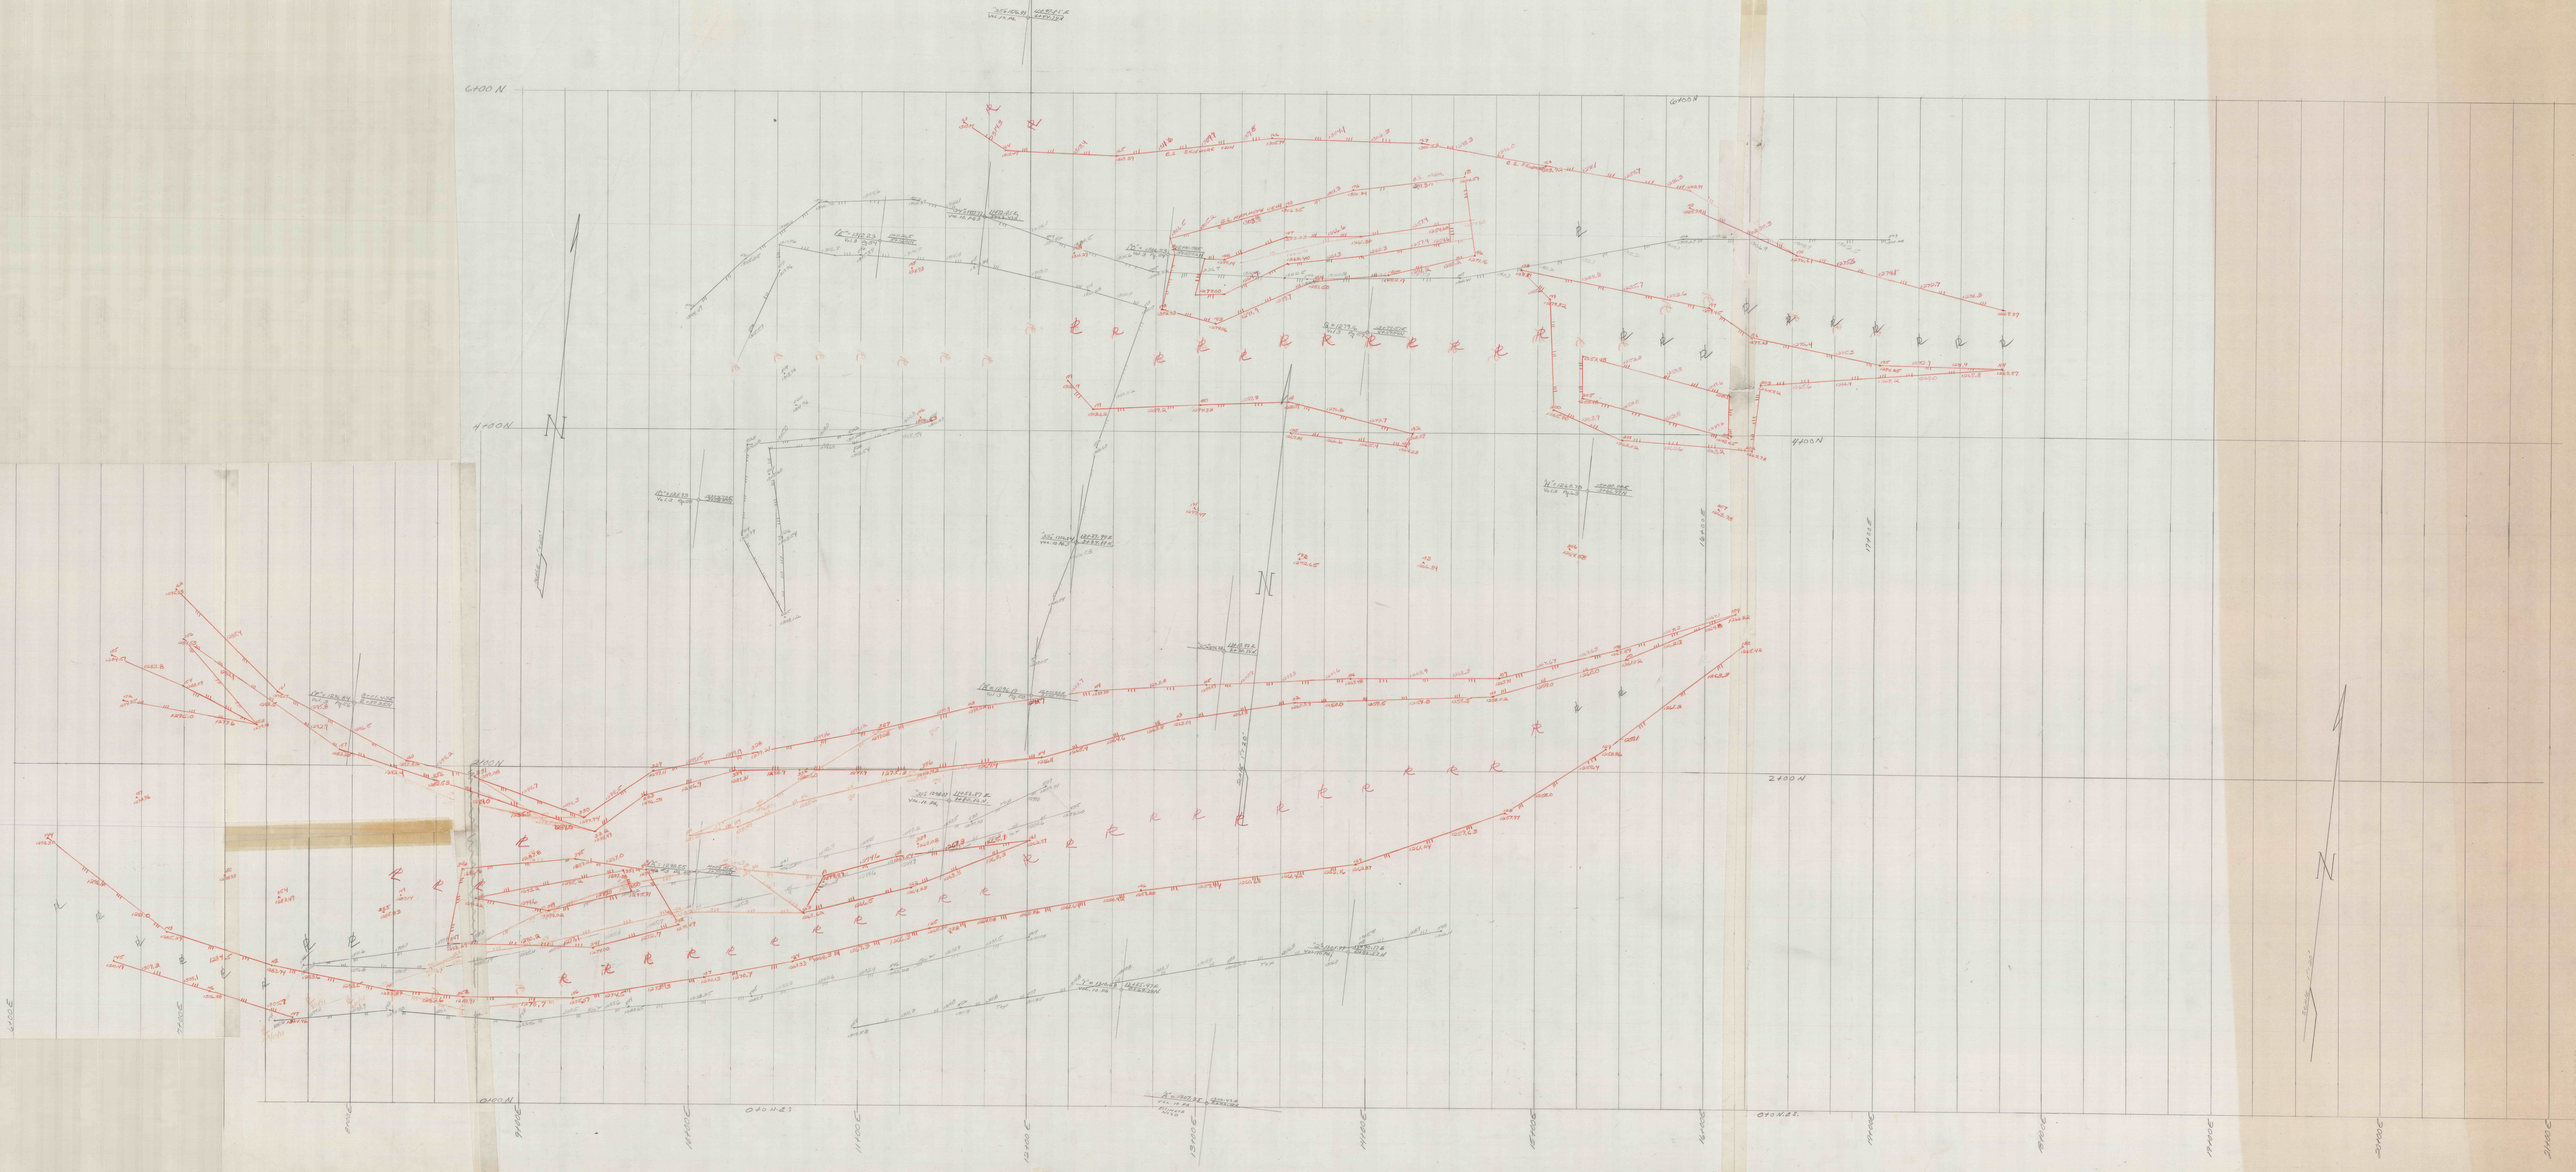
6400 N
4400 N
2400 N
0400 N
9400 E
10400 E
11400 E
12400 E
13400 E
14400 E
15400 E
16400 E
17400 E
18400 E
19400 E
20400 E
21400 E
