
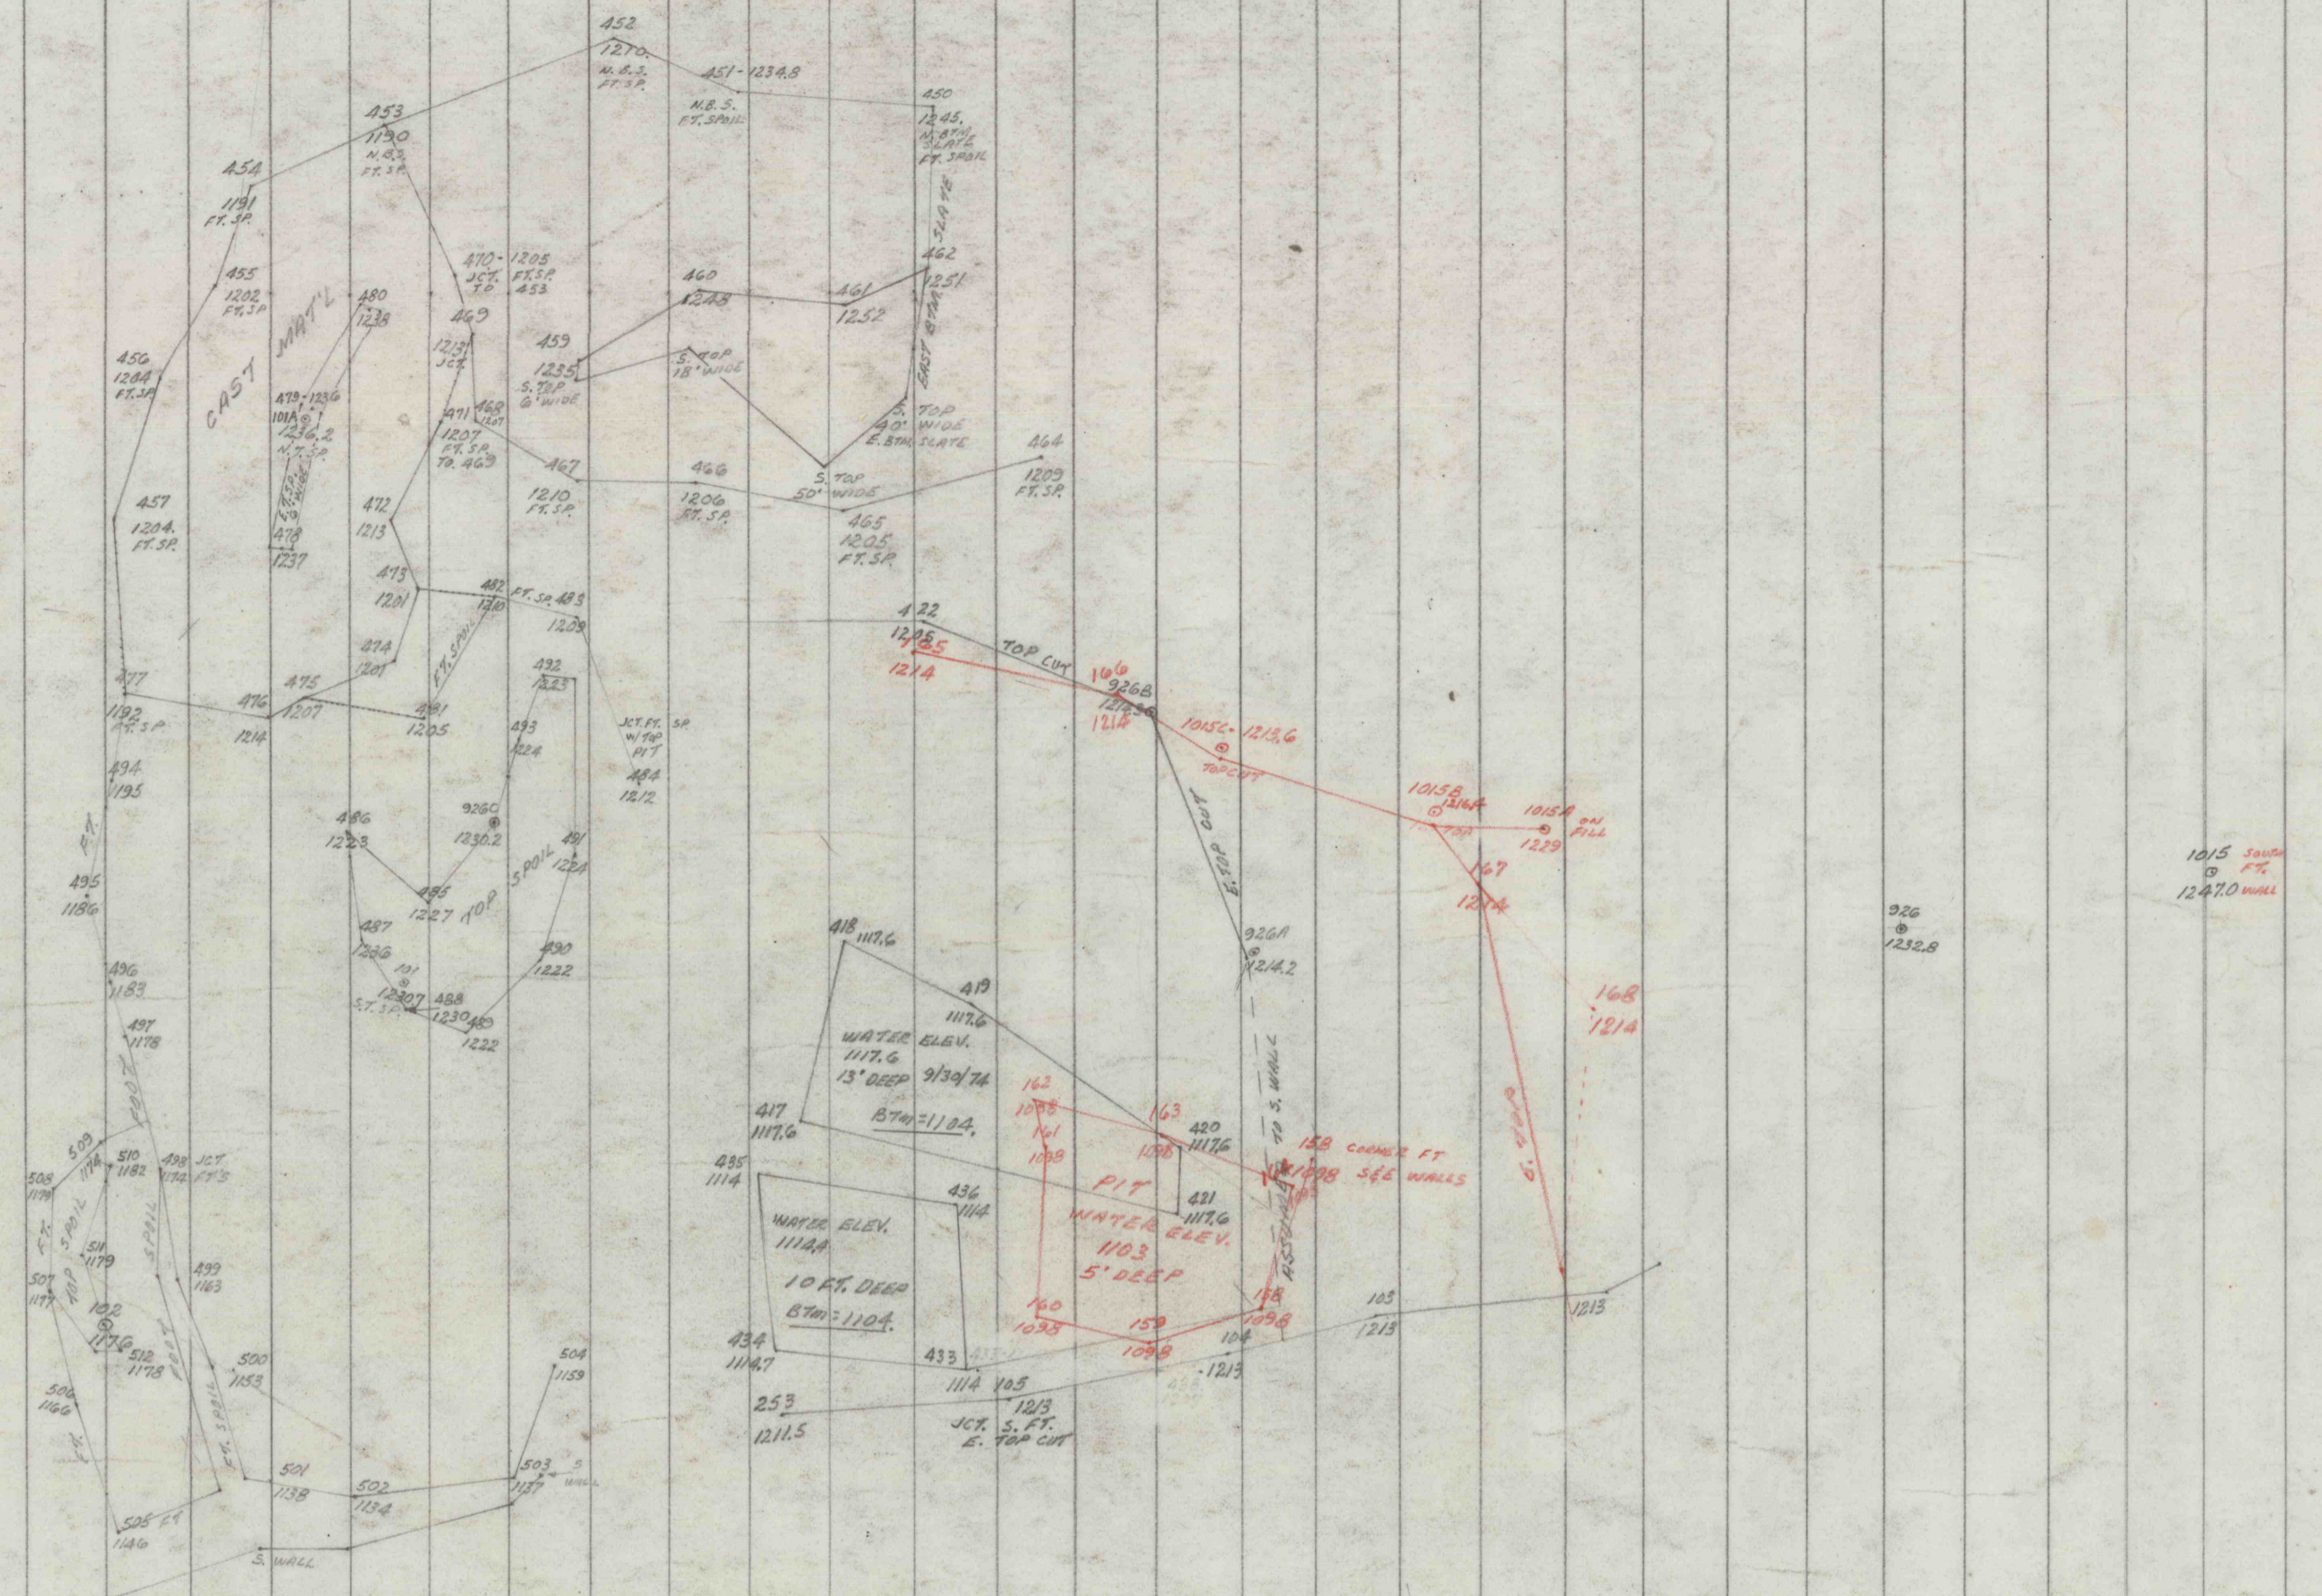


1100N

0100N45

0100 E & W

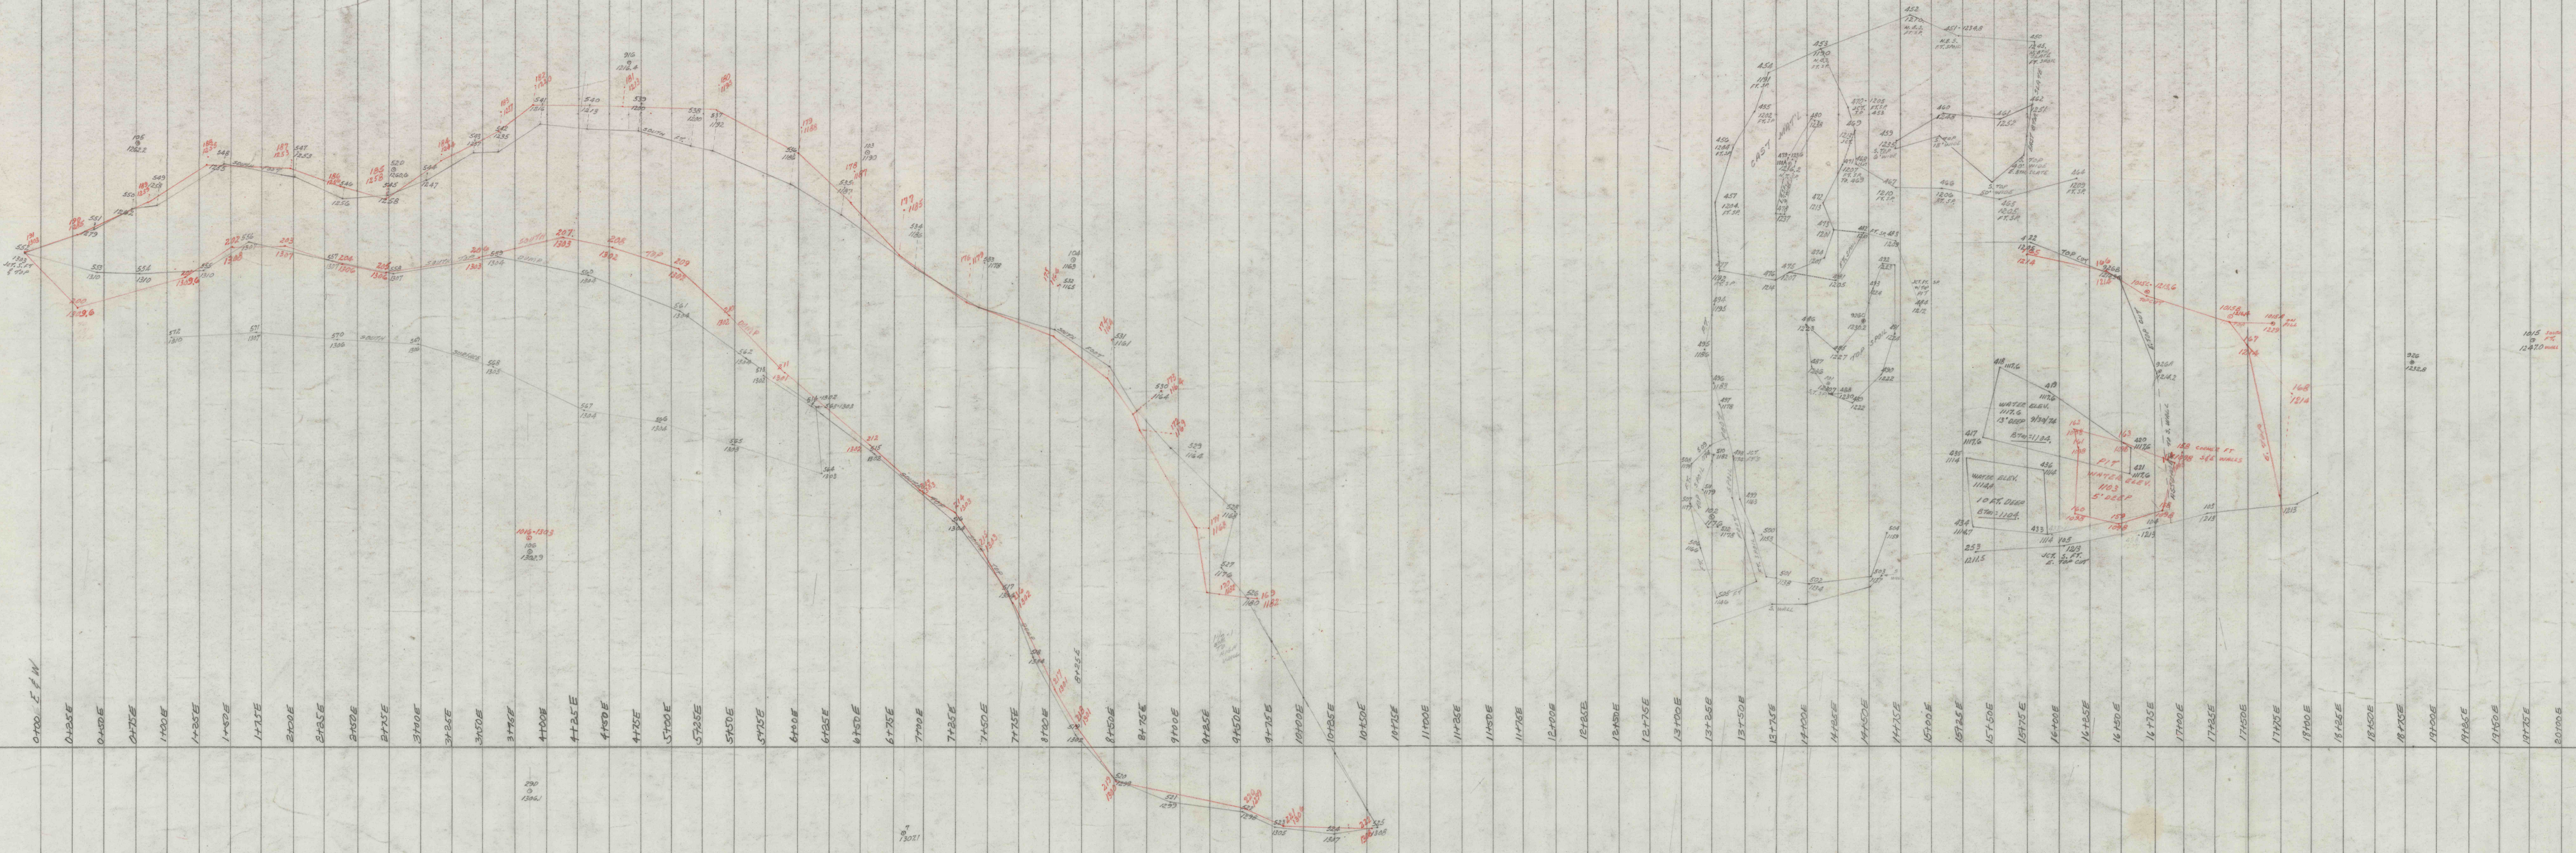

KEHLEY RUN SL 309
 SCALE 1" = 50'
 SEPT. 1974
 (200' DIST. IS 1974 LAST BARRIAL DATE)
 NO BARRIAL THRU 10/31/74