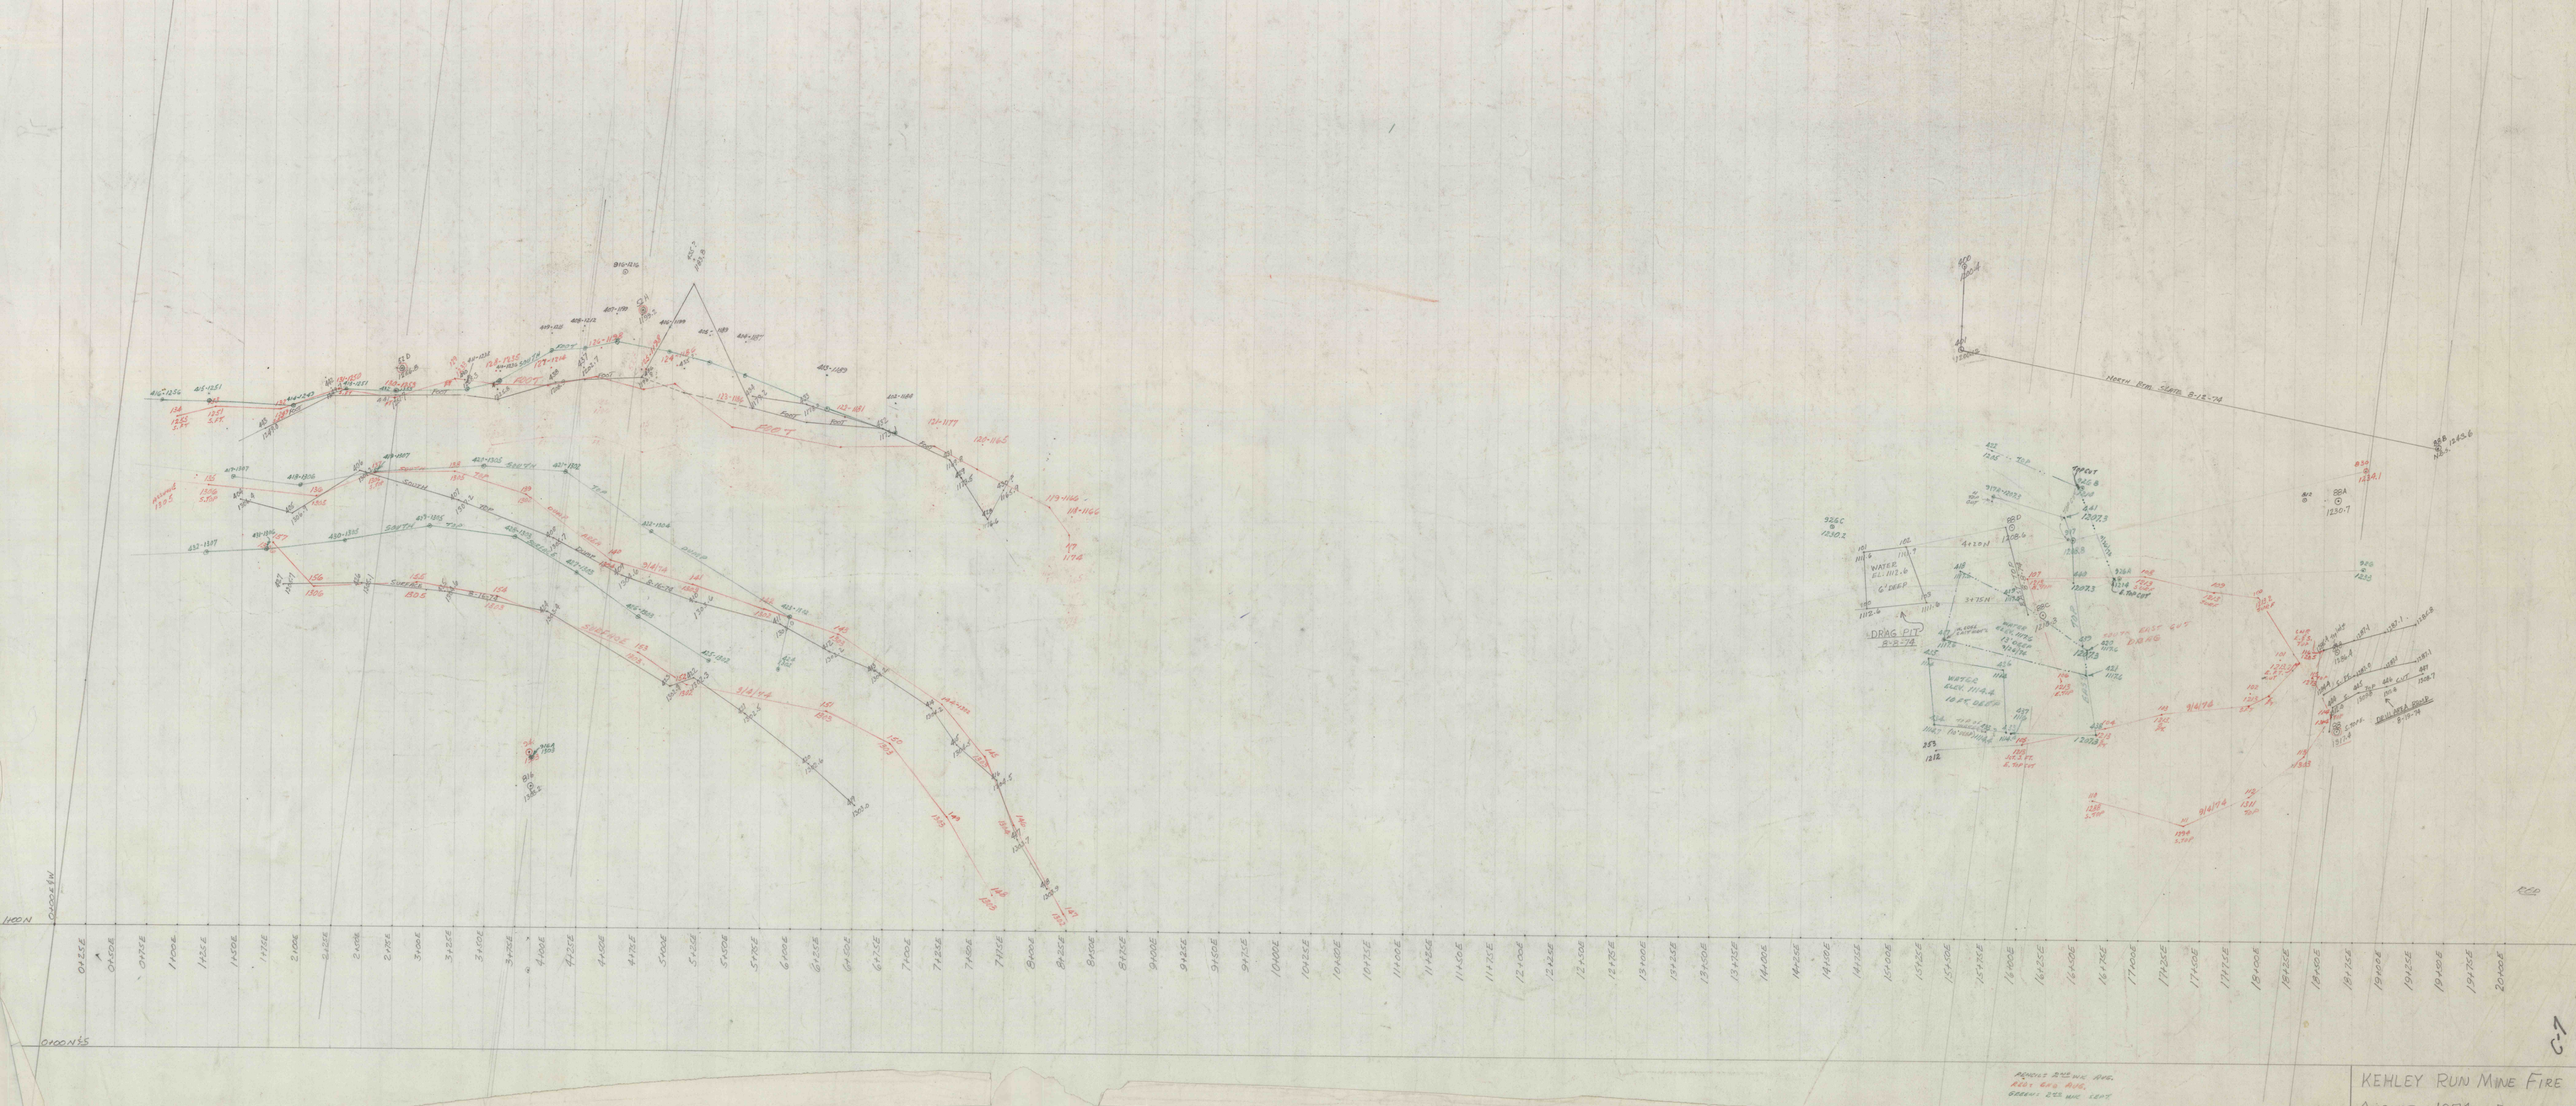

KEHLEY RUN MINE FIRE
AUGUST, 1974 ESTIMATE
SCALE: 1" = 50'

C-1