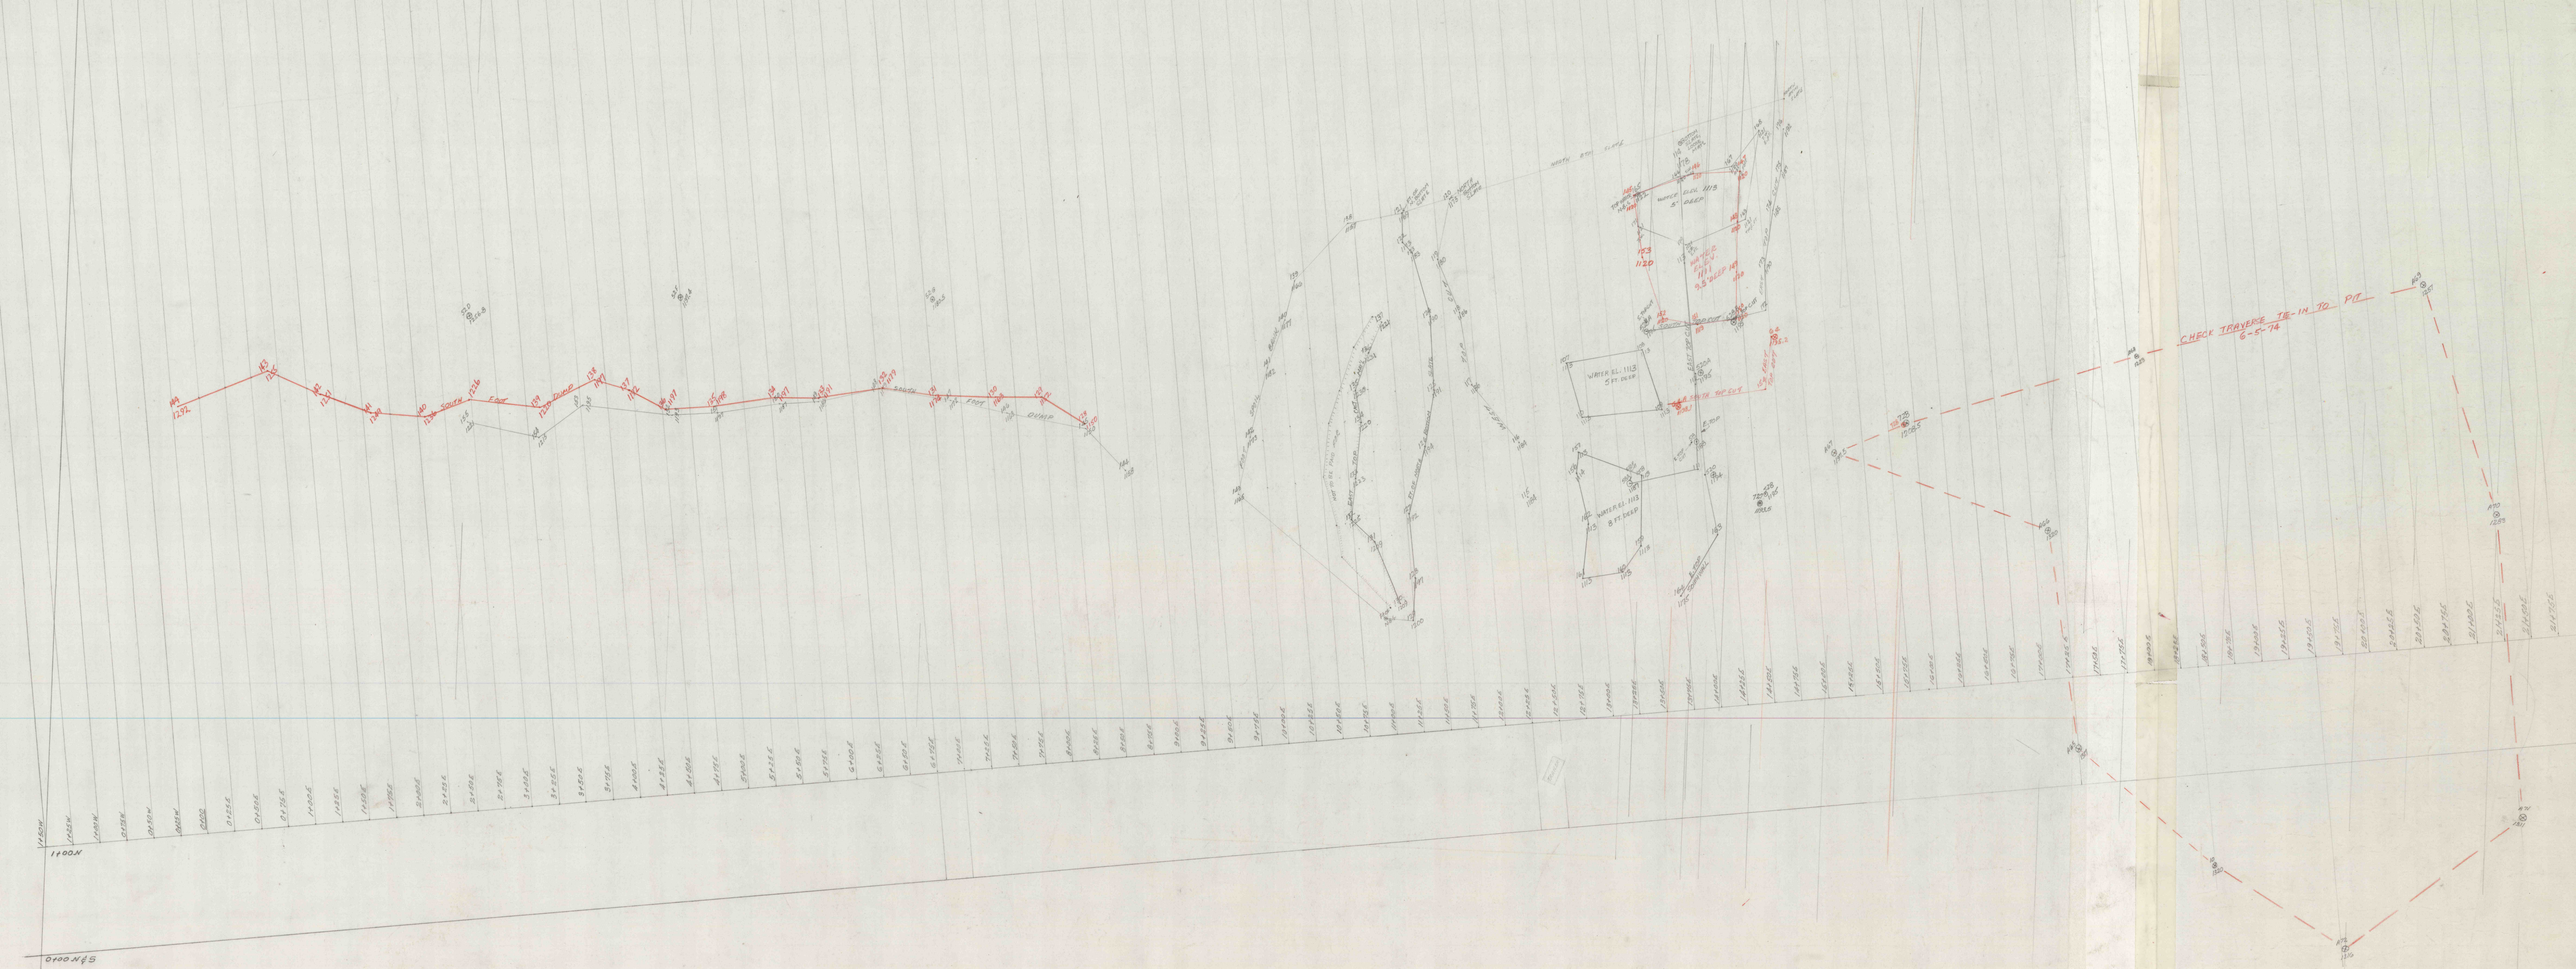

KIEHLEY RUN MINE FIRE
PROJECT # SL-309
SCALE: 1" = 50'

DATE: MAY 8, 1974 to