
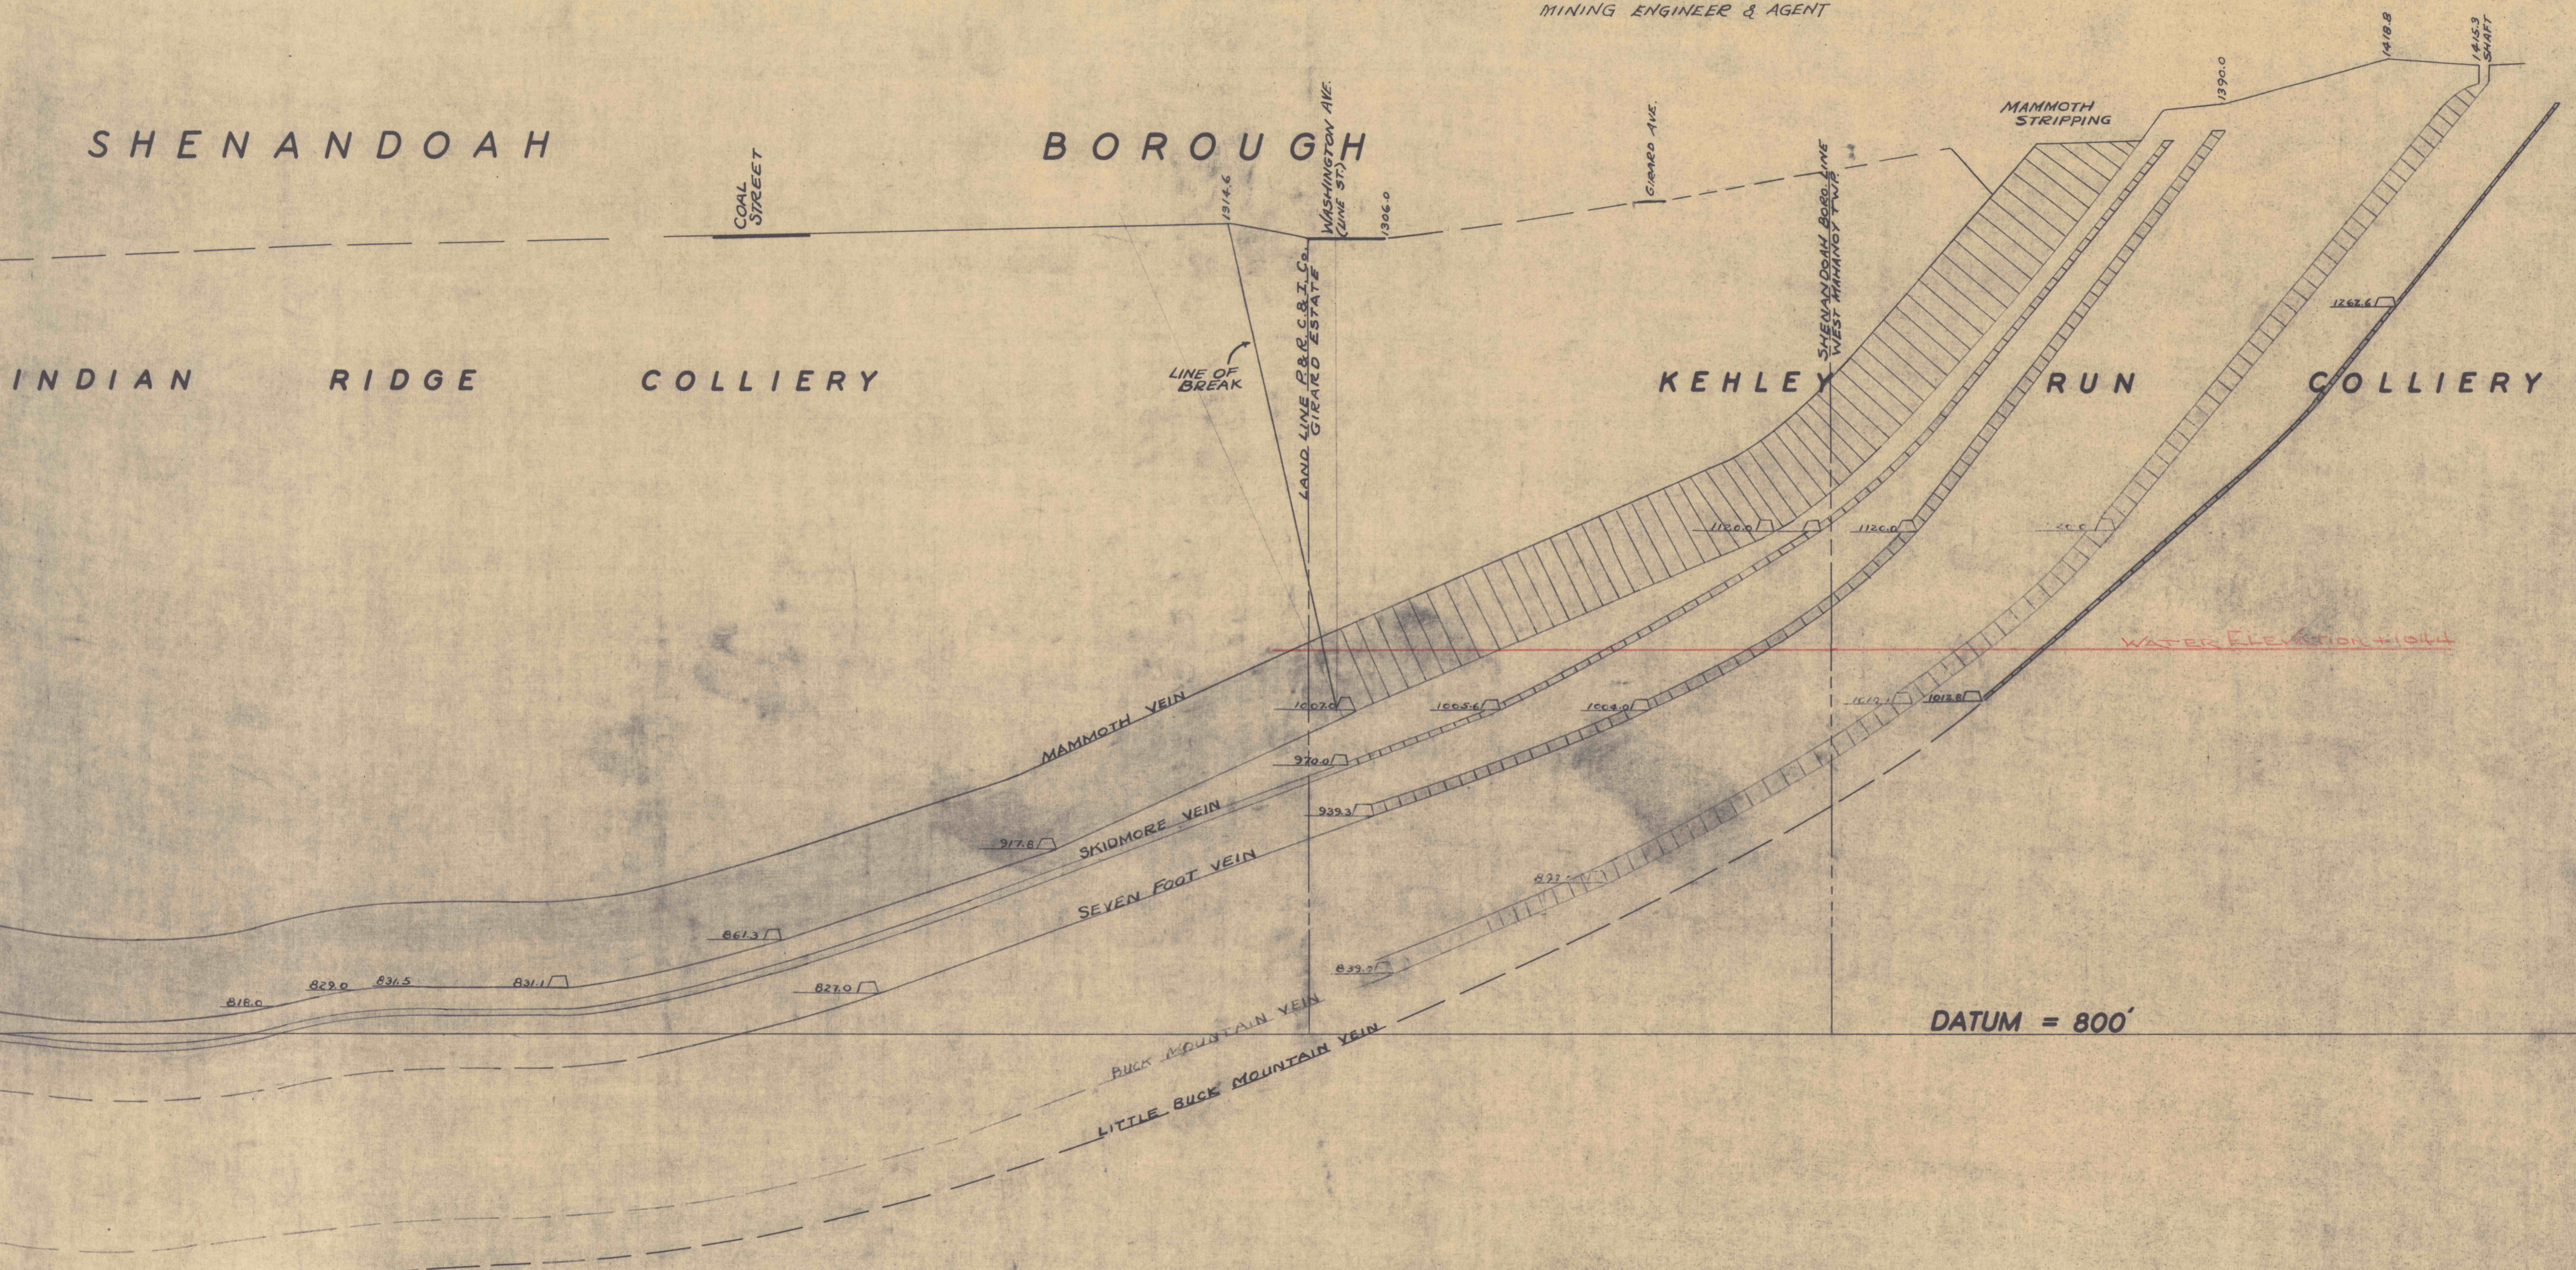


KEHLEY RUN COLLIERY
 CROSS SECTION 1800 FEET WEST OF MAIN
 SLOPE AND THRU JARDIN STREET SHOWING COAL
 VEINS IN RELATION TO SHENANDOAH BOROUGH
 SCALE 1" = 50' "H"
 W.P. MILLINGTON
 MINING ENGINEER & AGENT

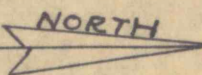

SECTION "H"