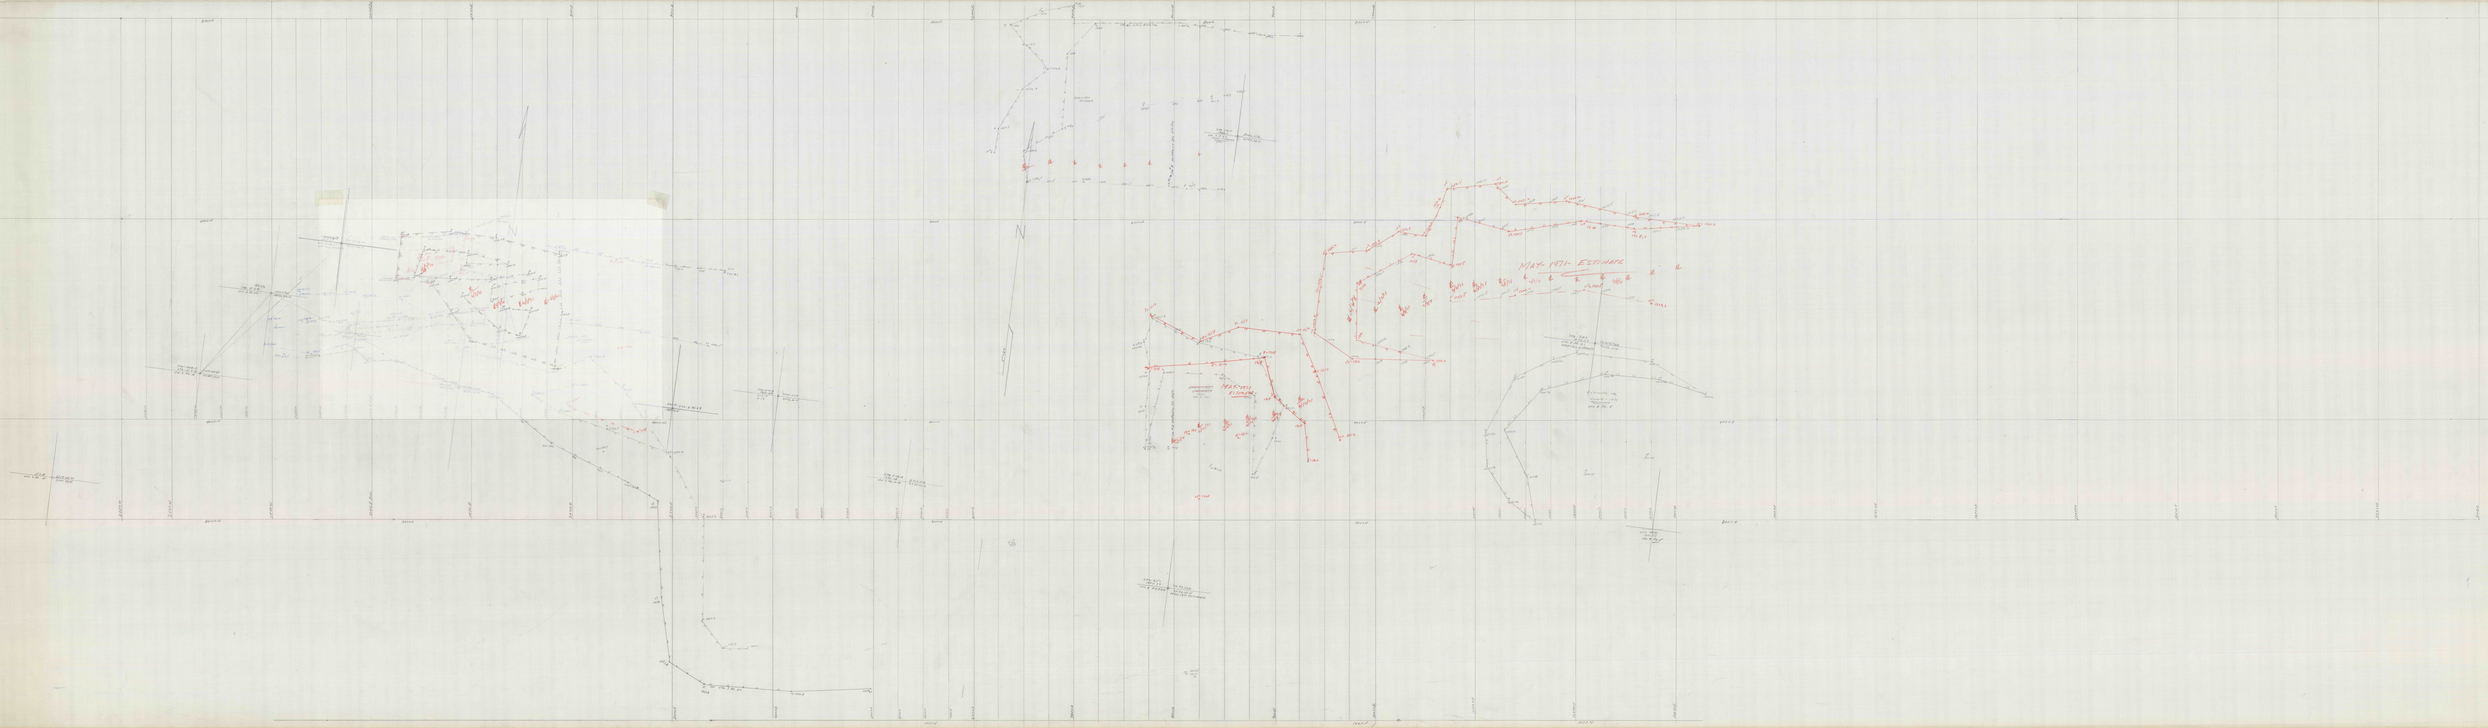
N
N
MAY 1971 ESTIMATE
MAY 1971 FLOWS