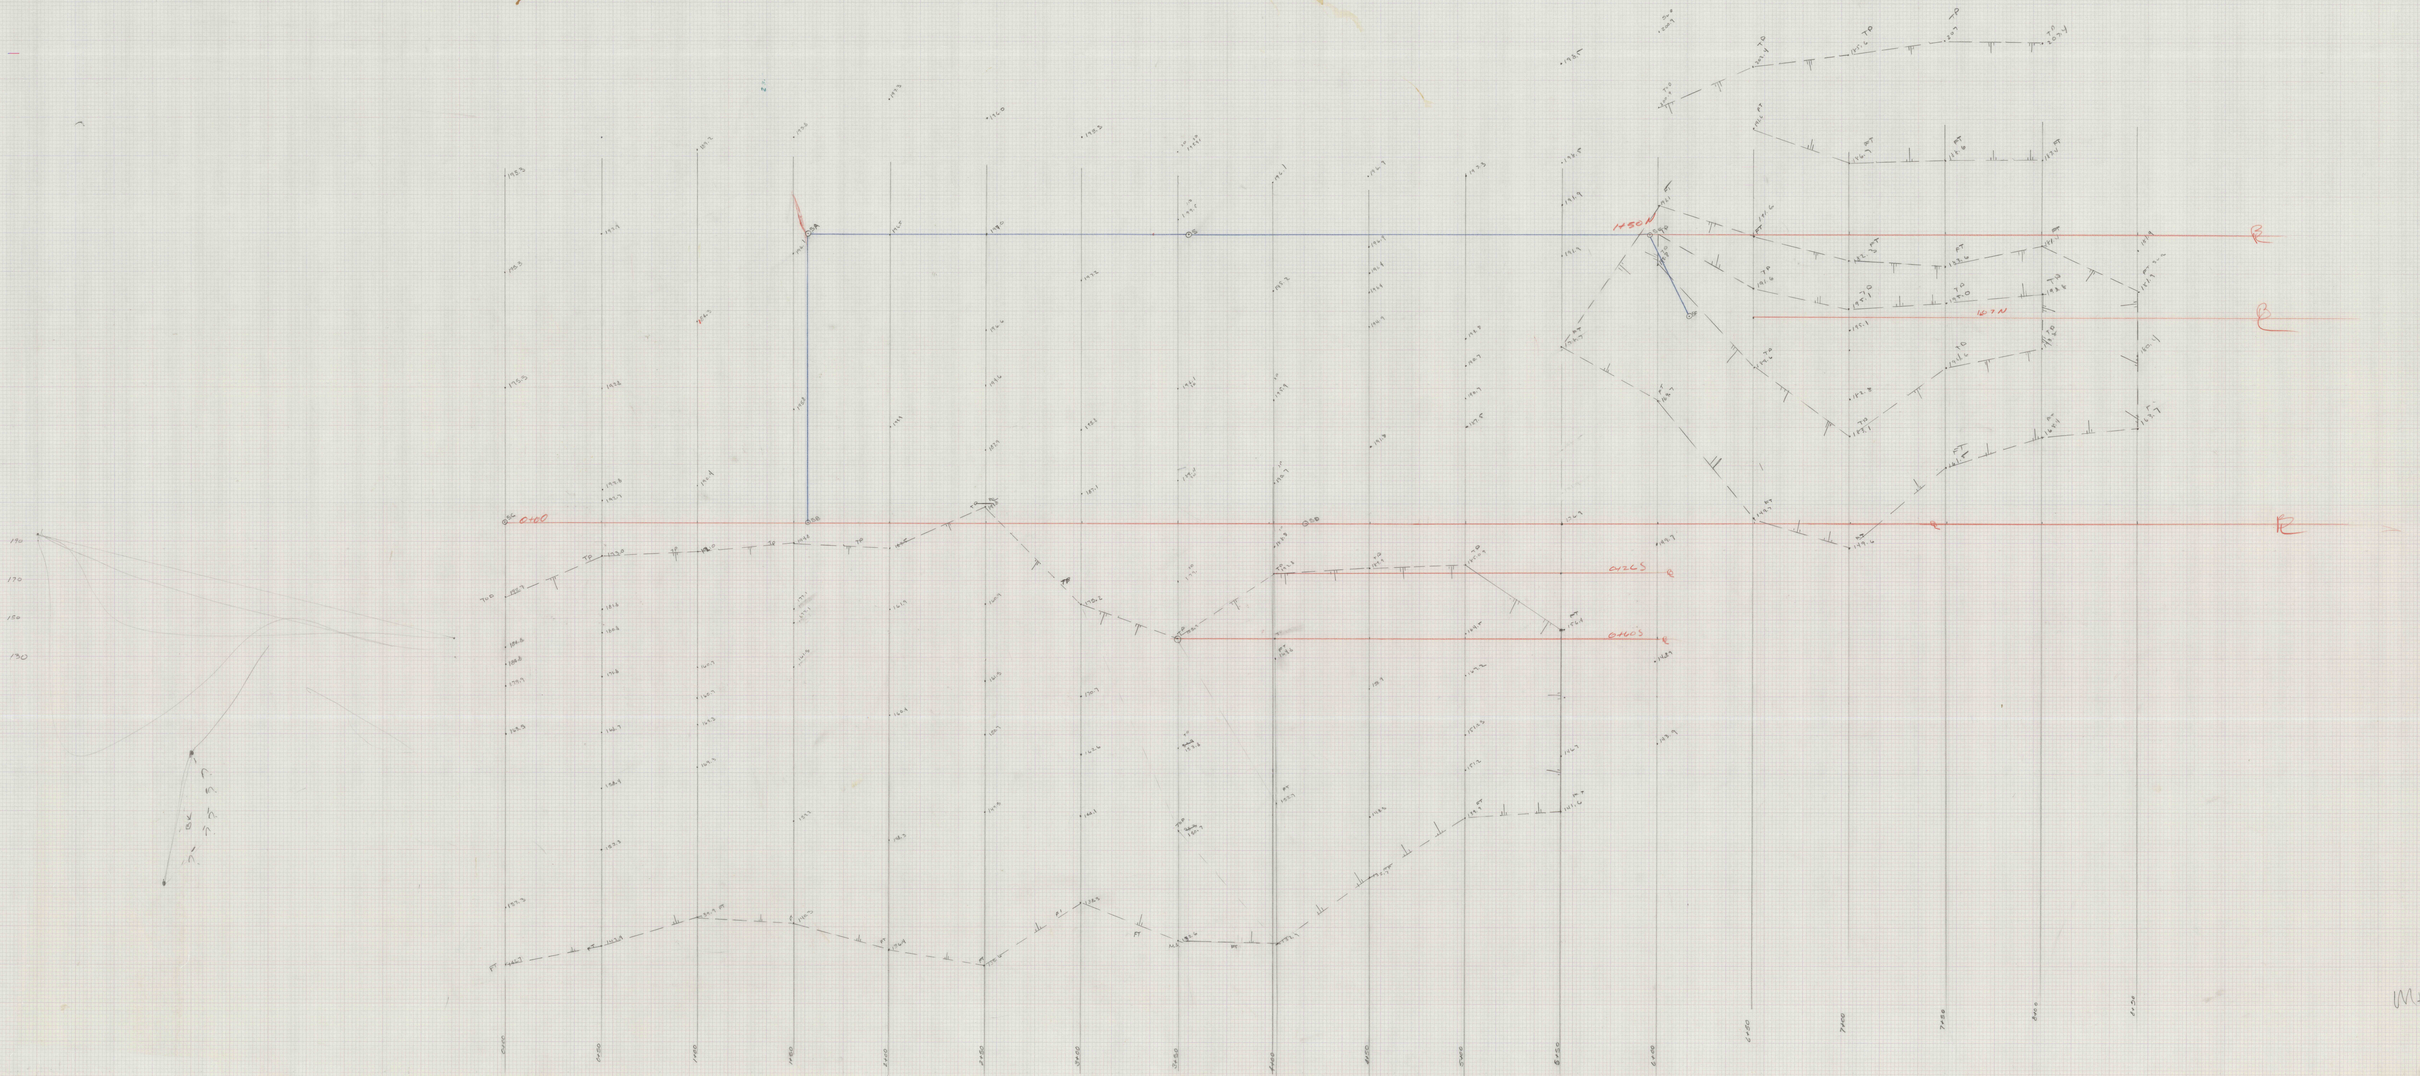
PLAN
SCB
MARION Heights
Gallowgate
1" = 20'
4/10/78