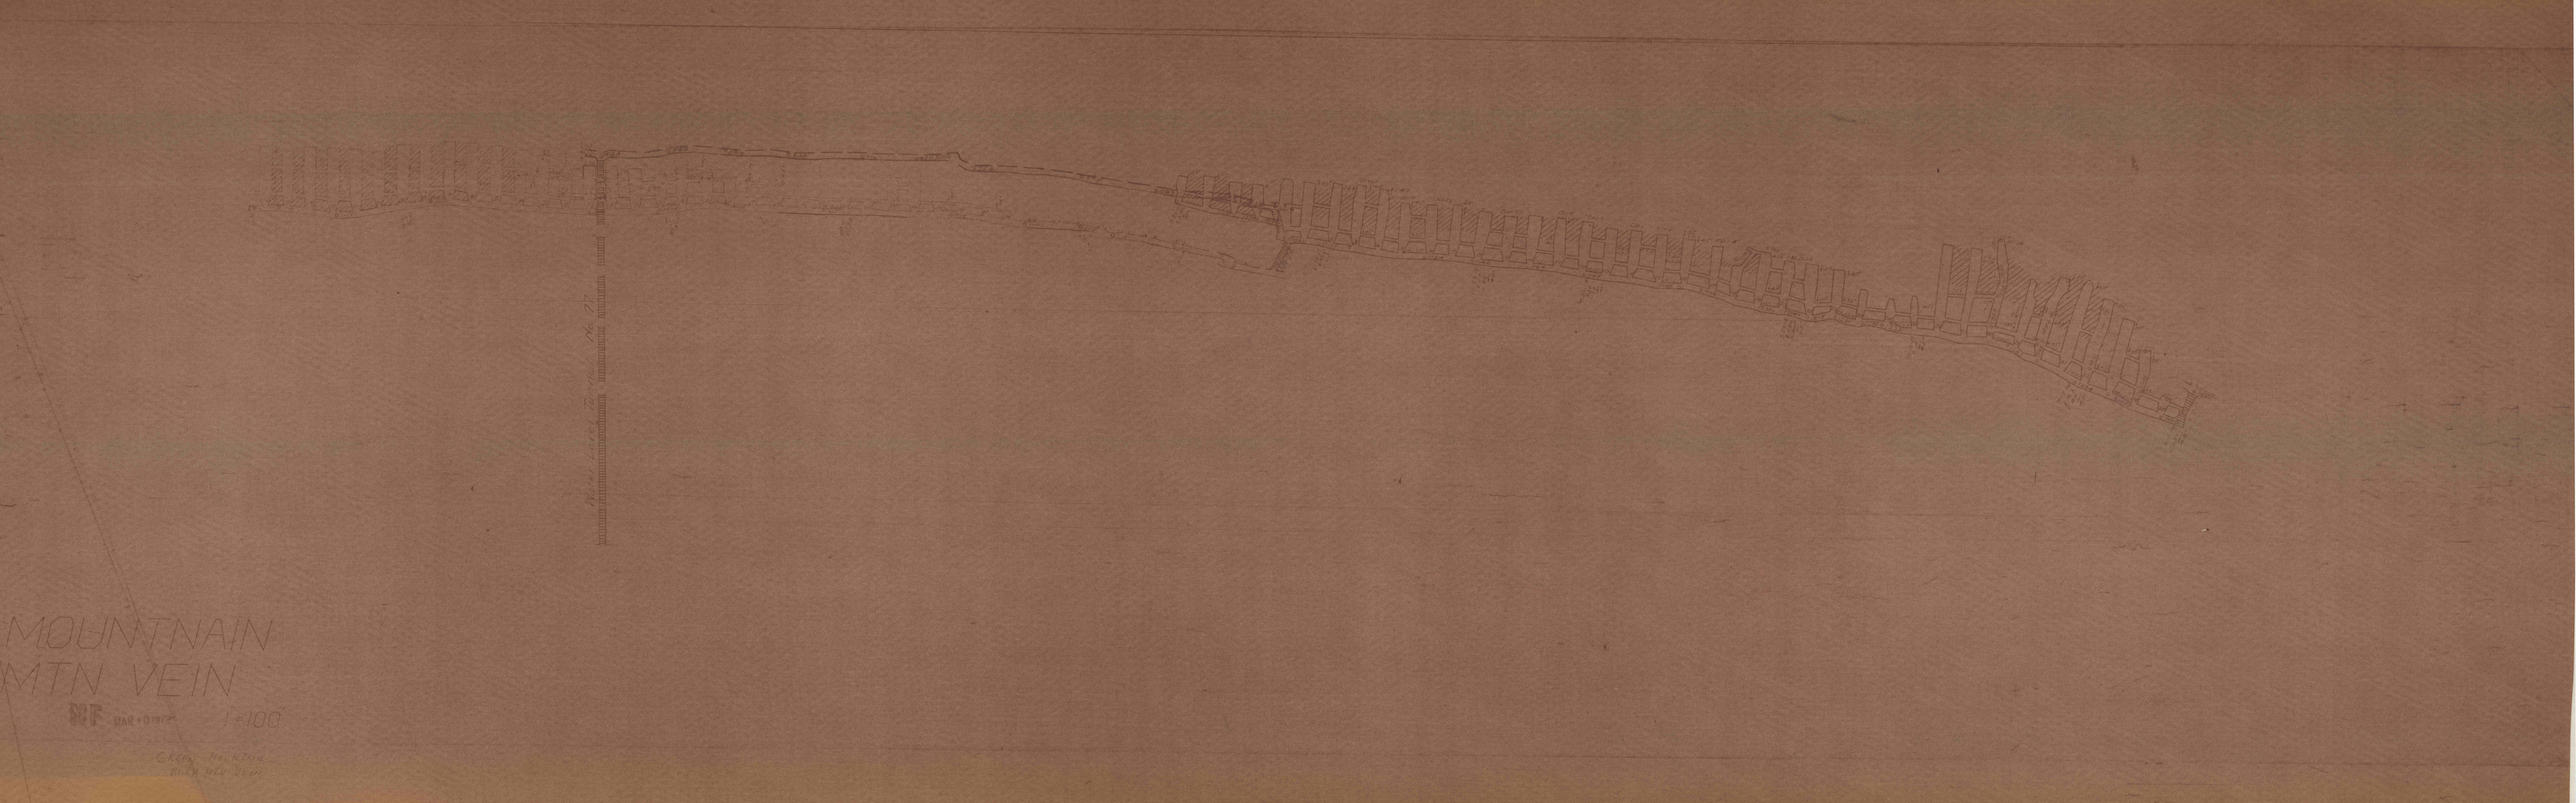
MOUNTNAIN
MTN VEIN