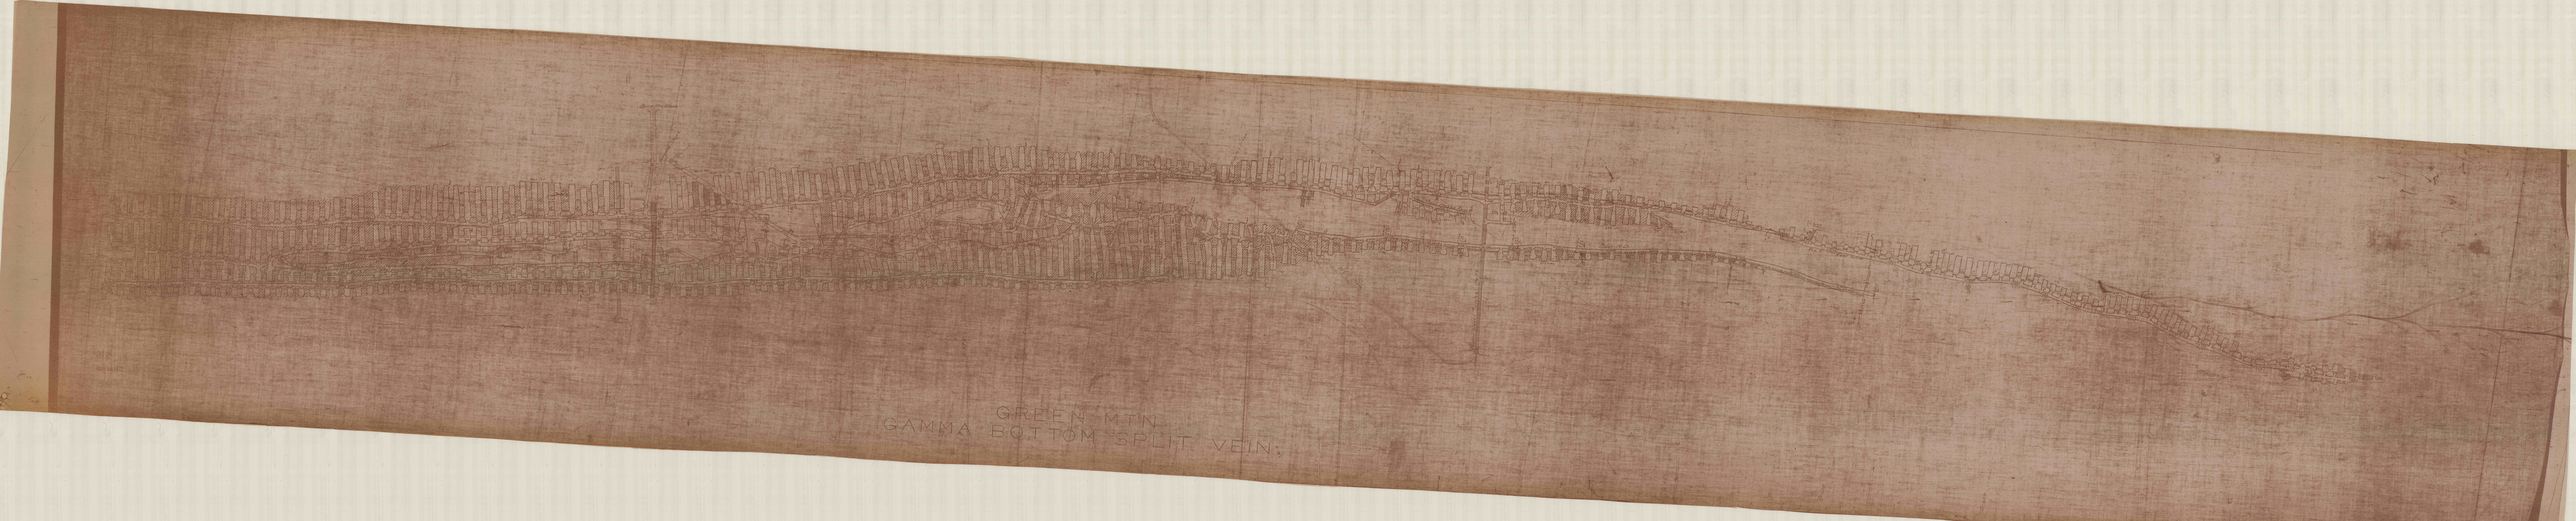
GREEN MTN.
GAMMA BOTTOM SPLIT VEIN.