
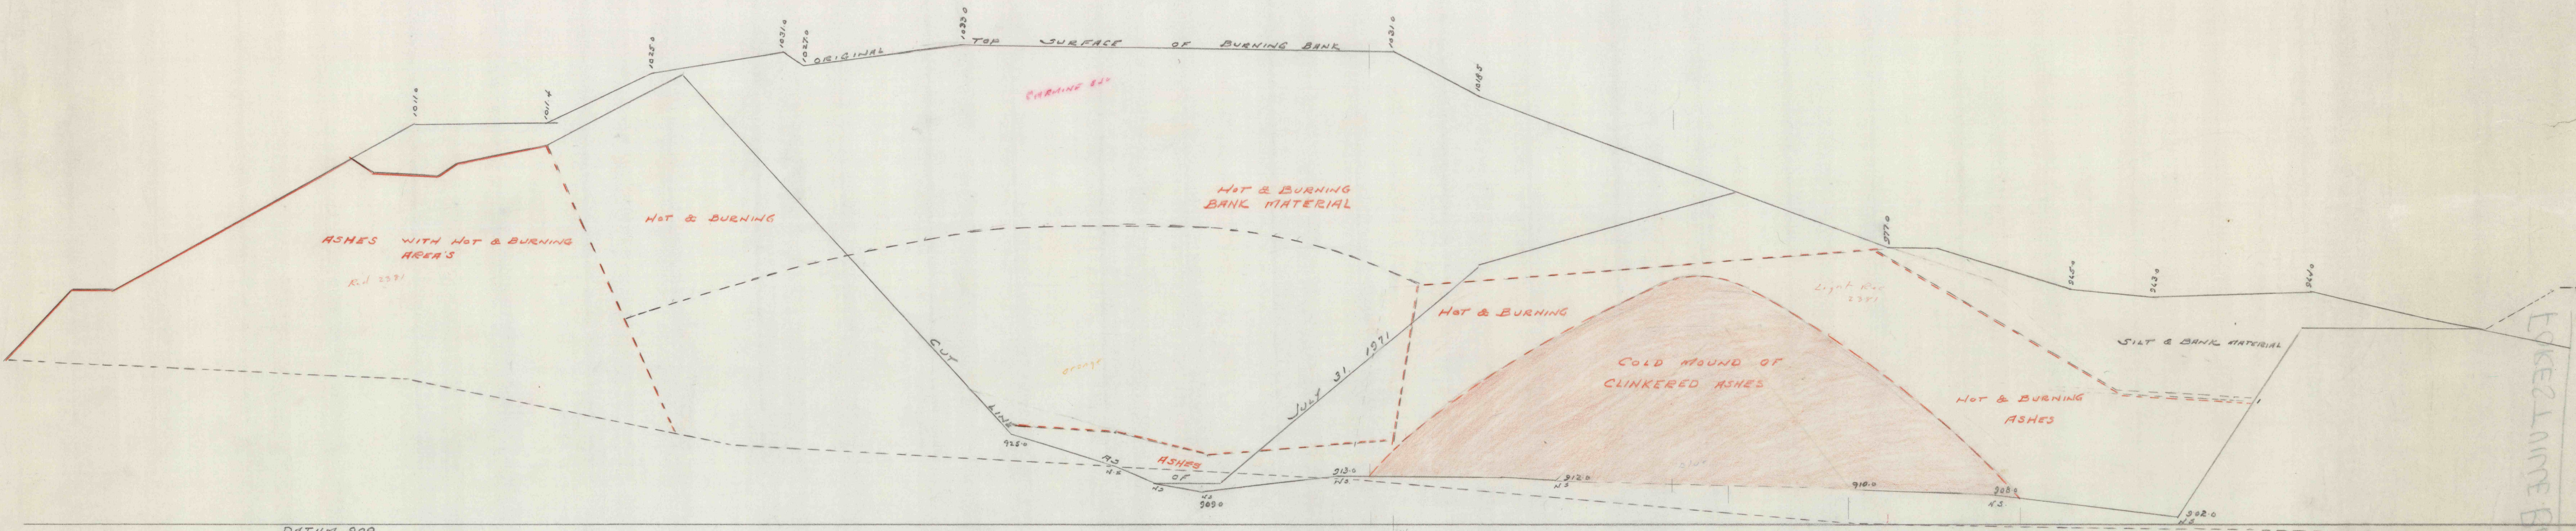


FORESTVILLE BANK FIRE

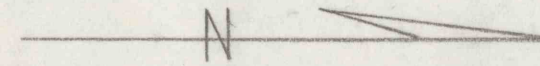

DATUM 900

SECTION 13+00
SCALE 1" = 20'

FORESTVILLE BANK FIRE