


FORESTVILLE
1" = 50'

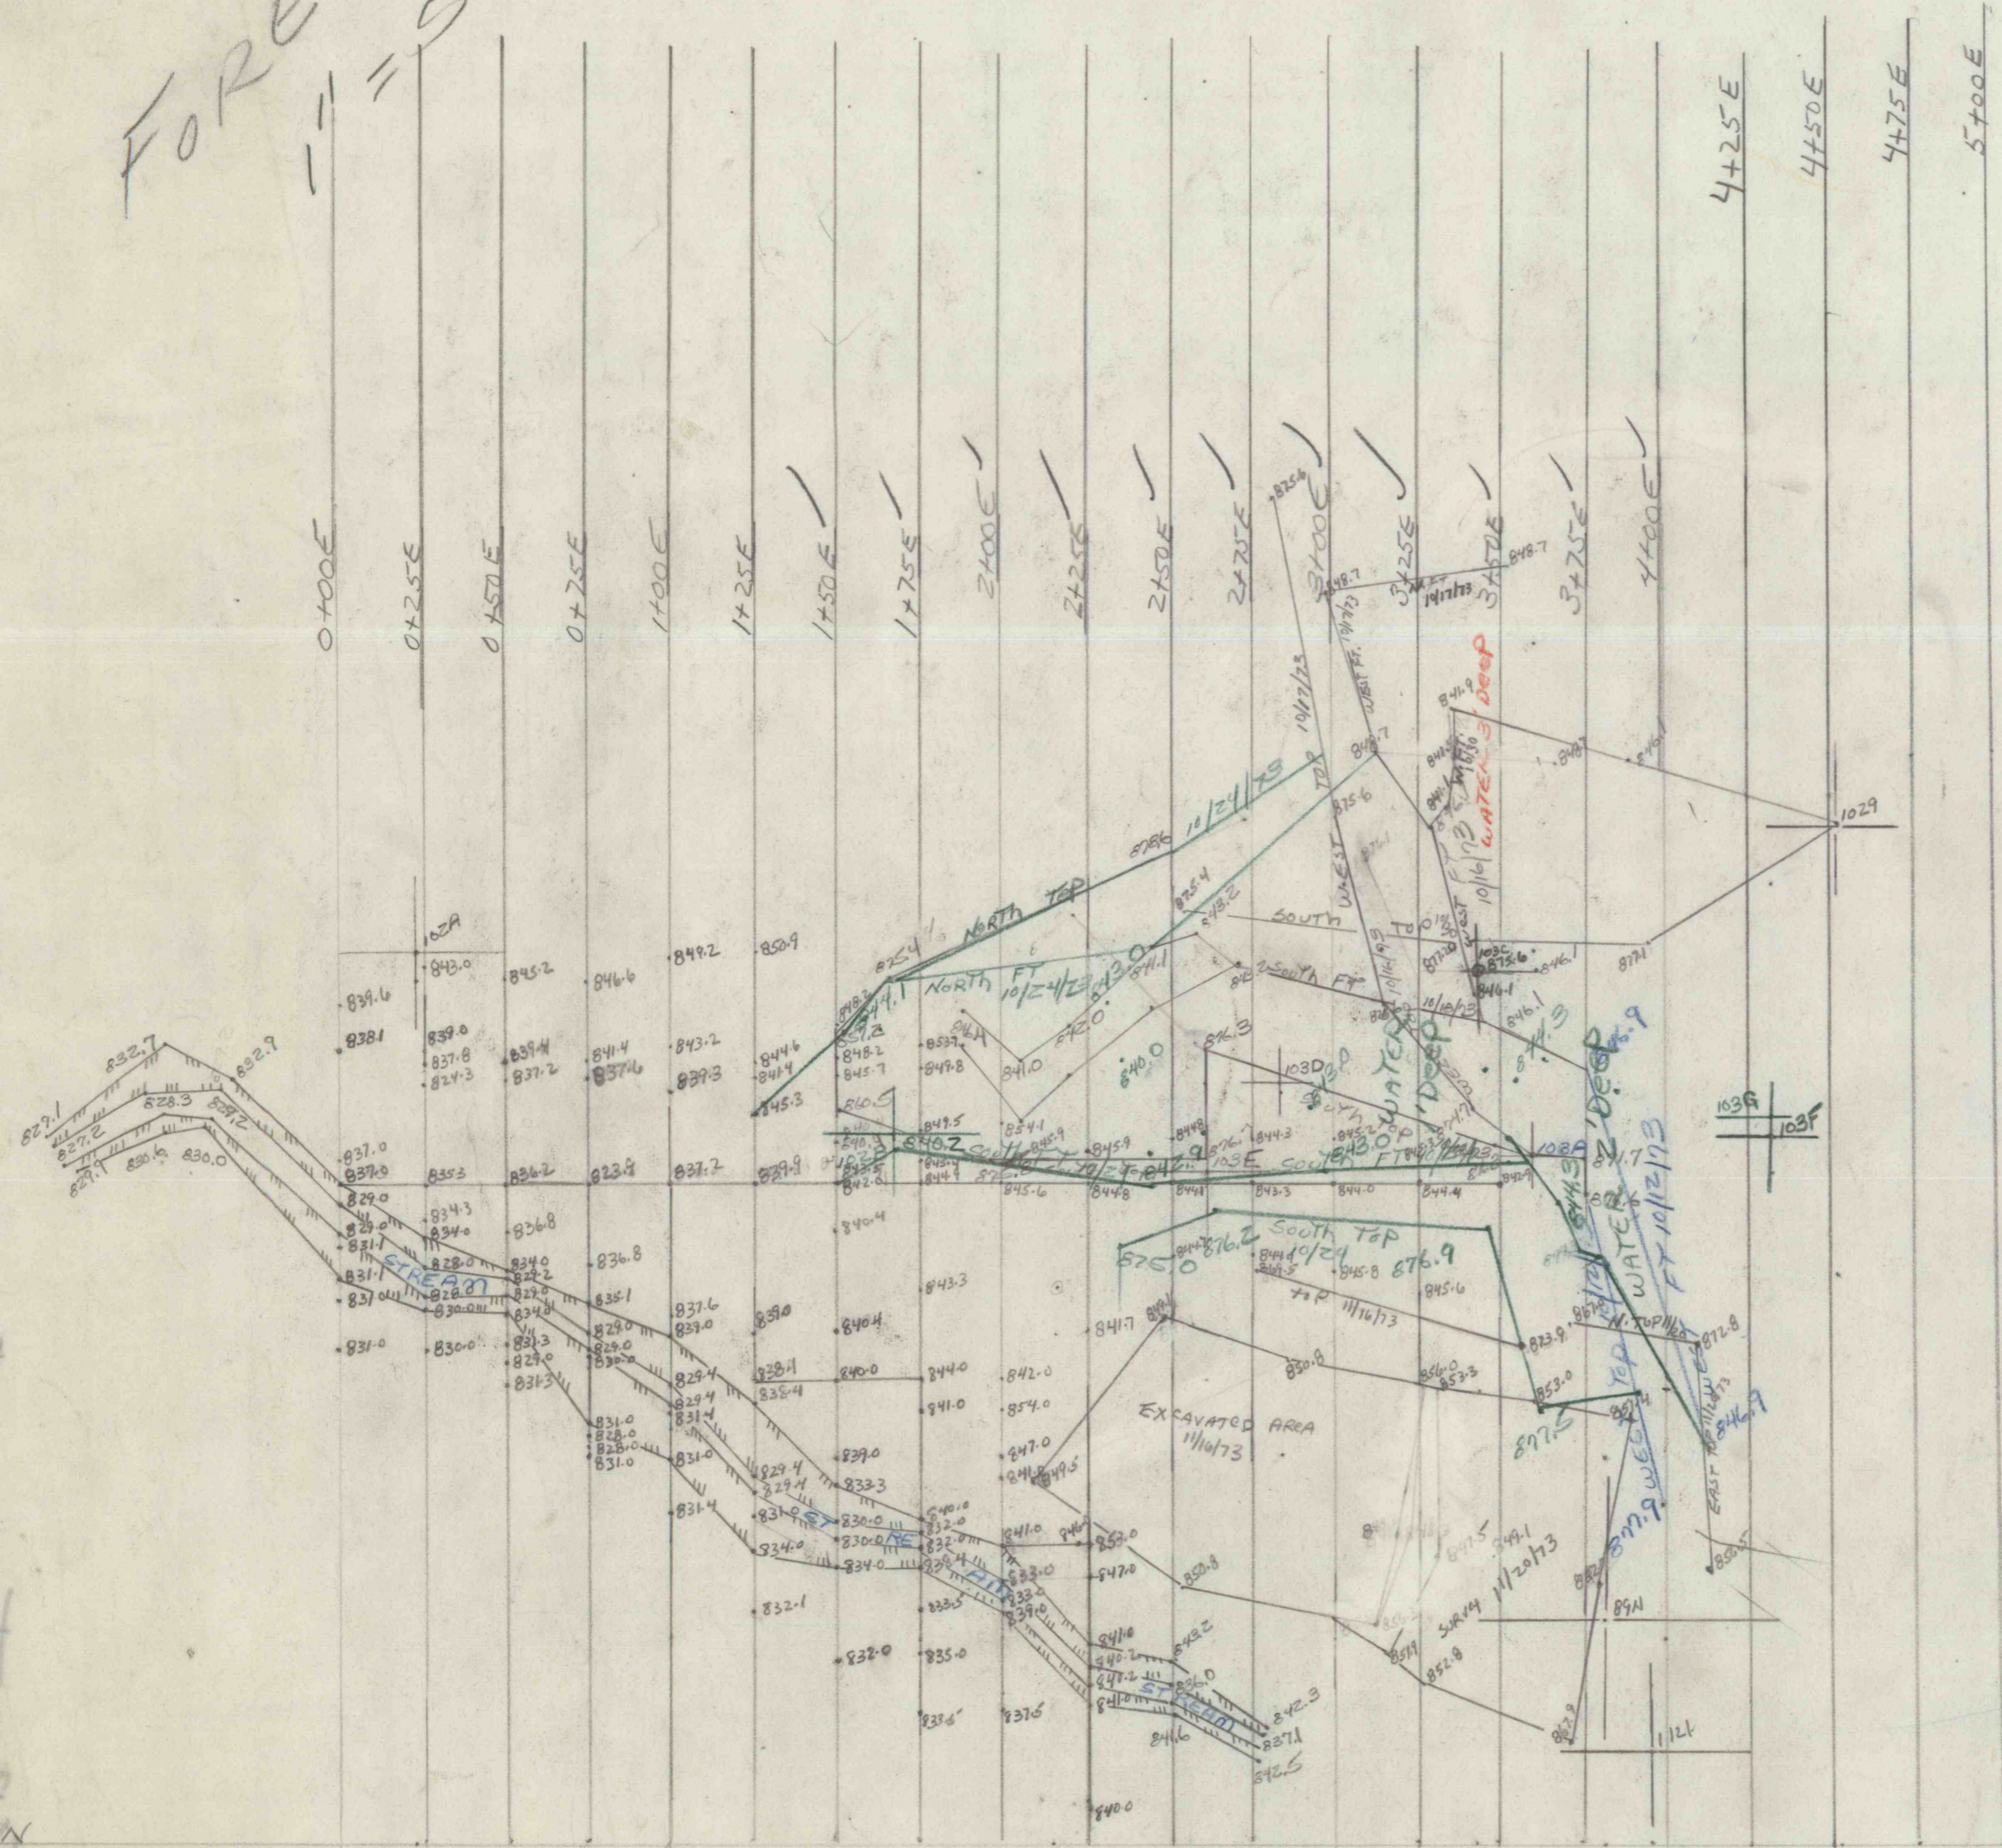

Oct. 15 ECT