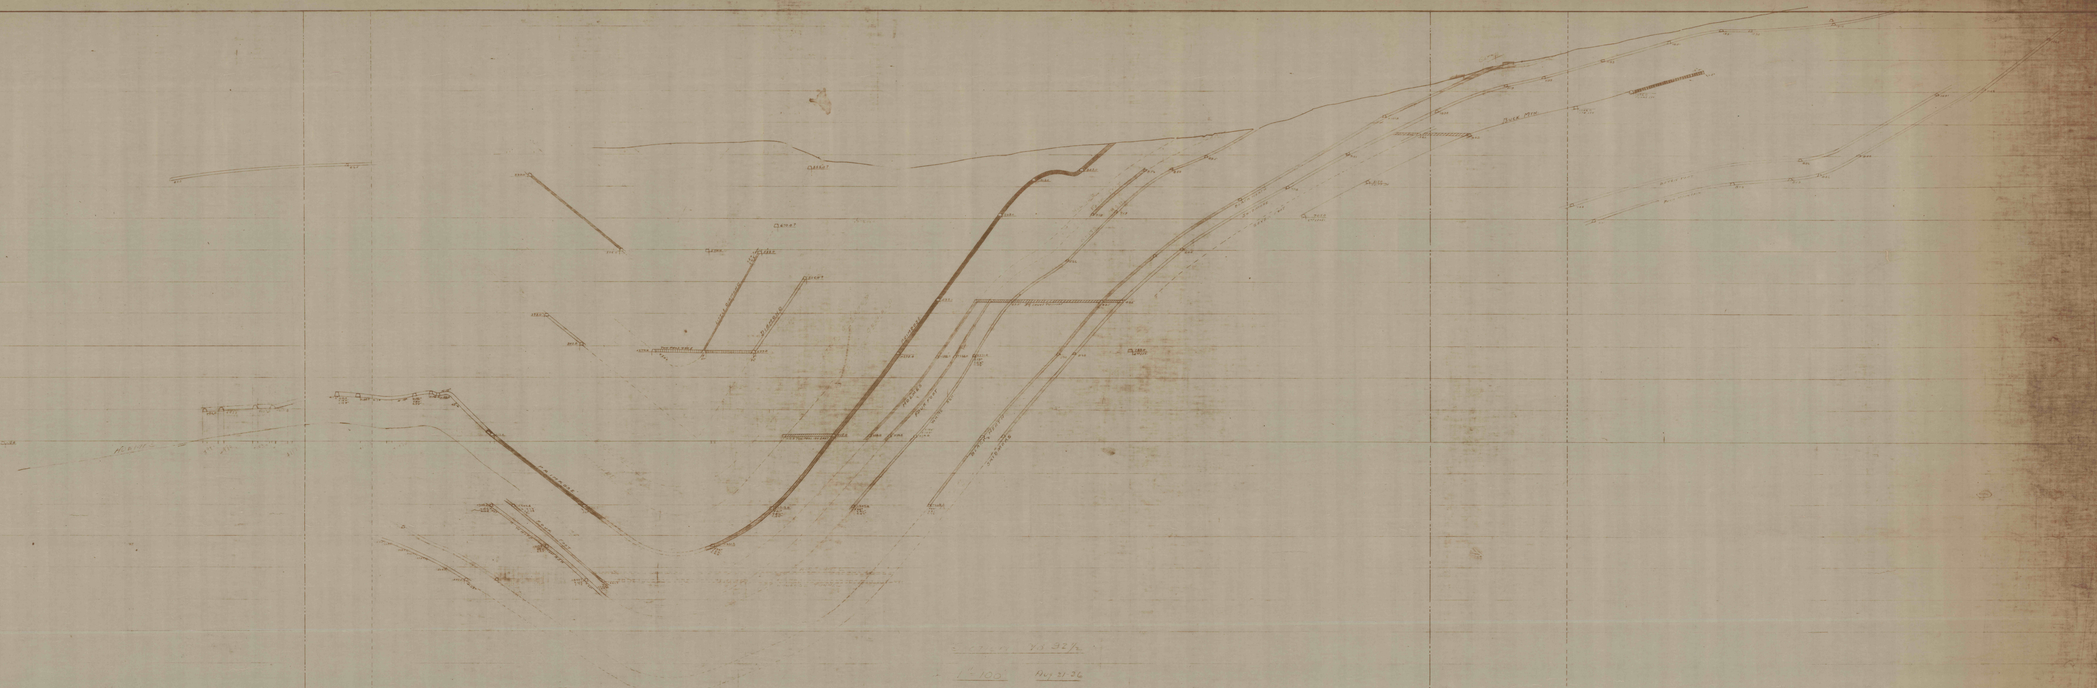

SOUTHERN COAL FIELD
LYTLE Colliery.. 1"=100' AUG. 21, 1936.
"X" SECTION. No. 92½. S. CASS TWP.
SCHUYLKILL COUNTY, PA.
SUSQUEHANNA COL'R'S.