


C O A L I R O Z C O

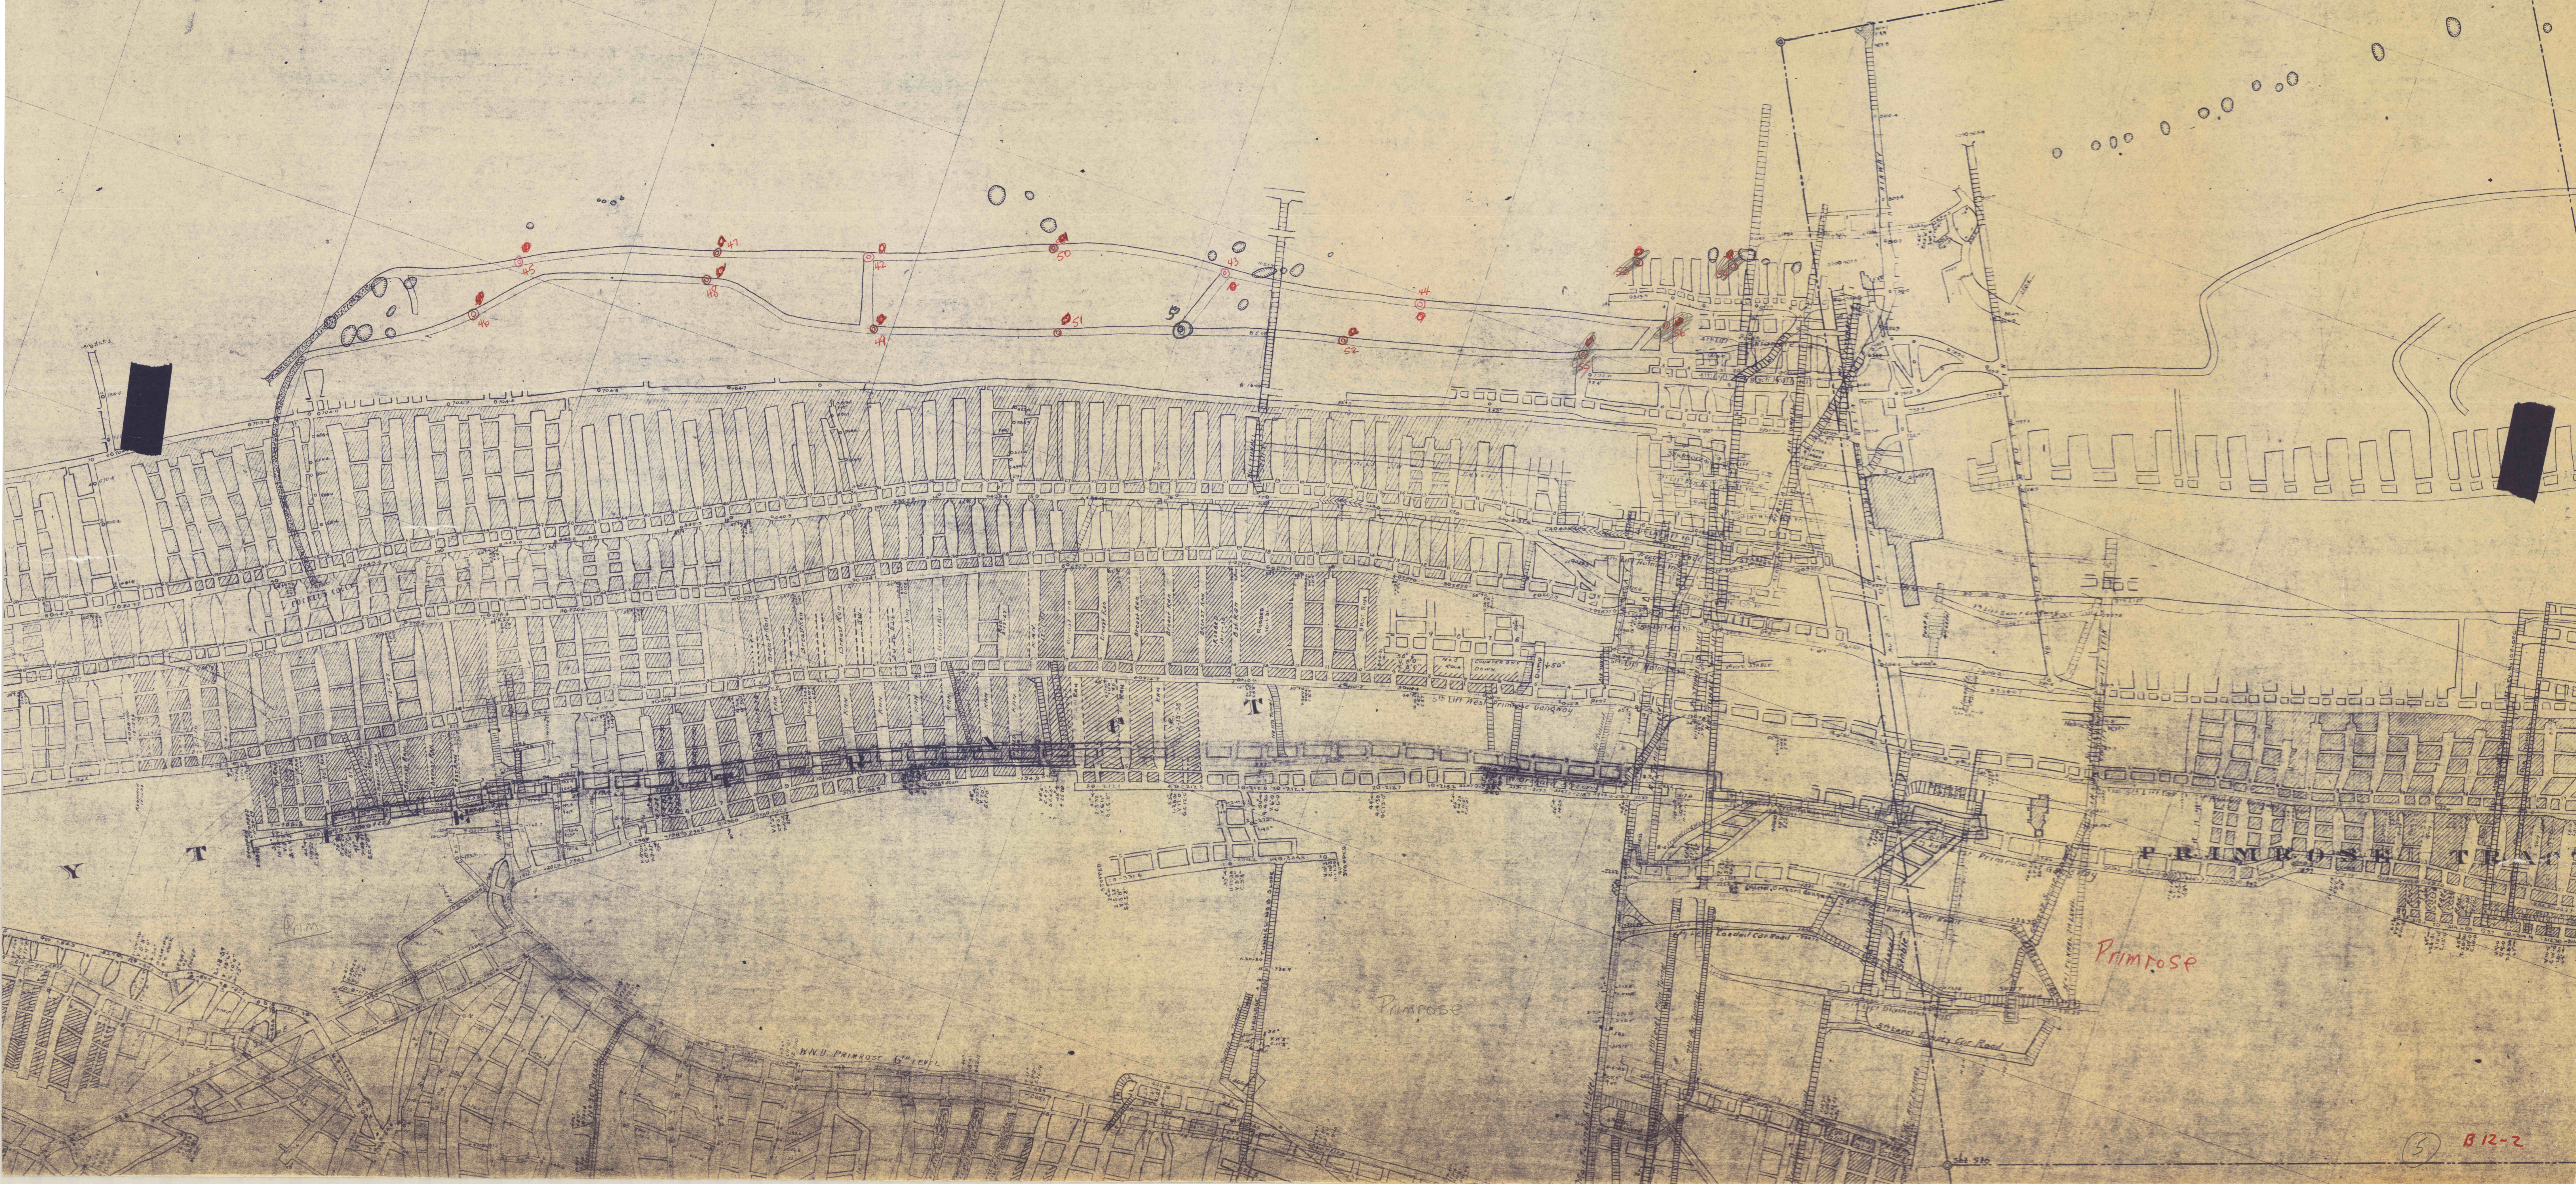

Primrose

Primrose