


L
2
L
R
O
T
C
O

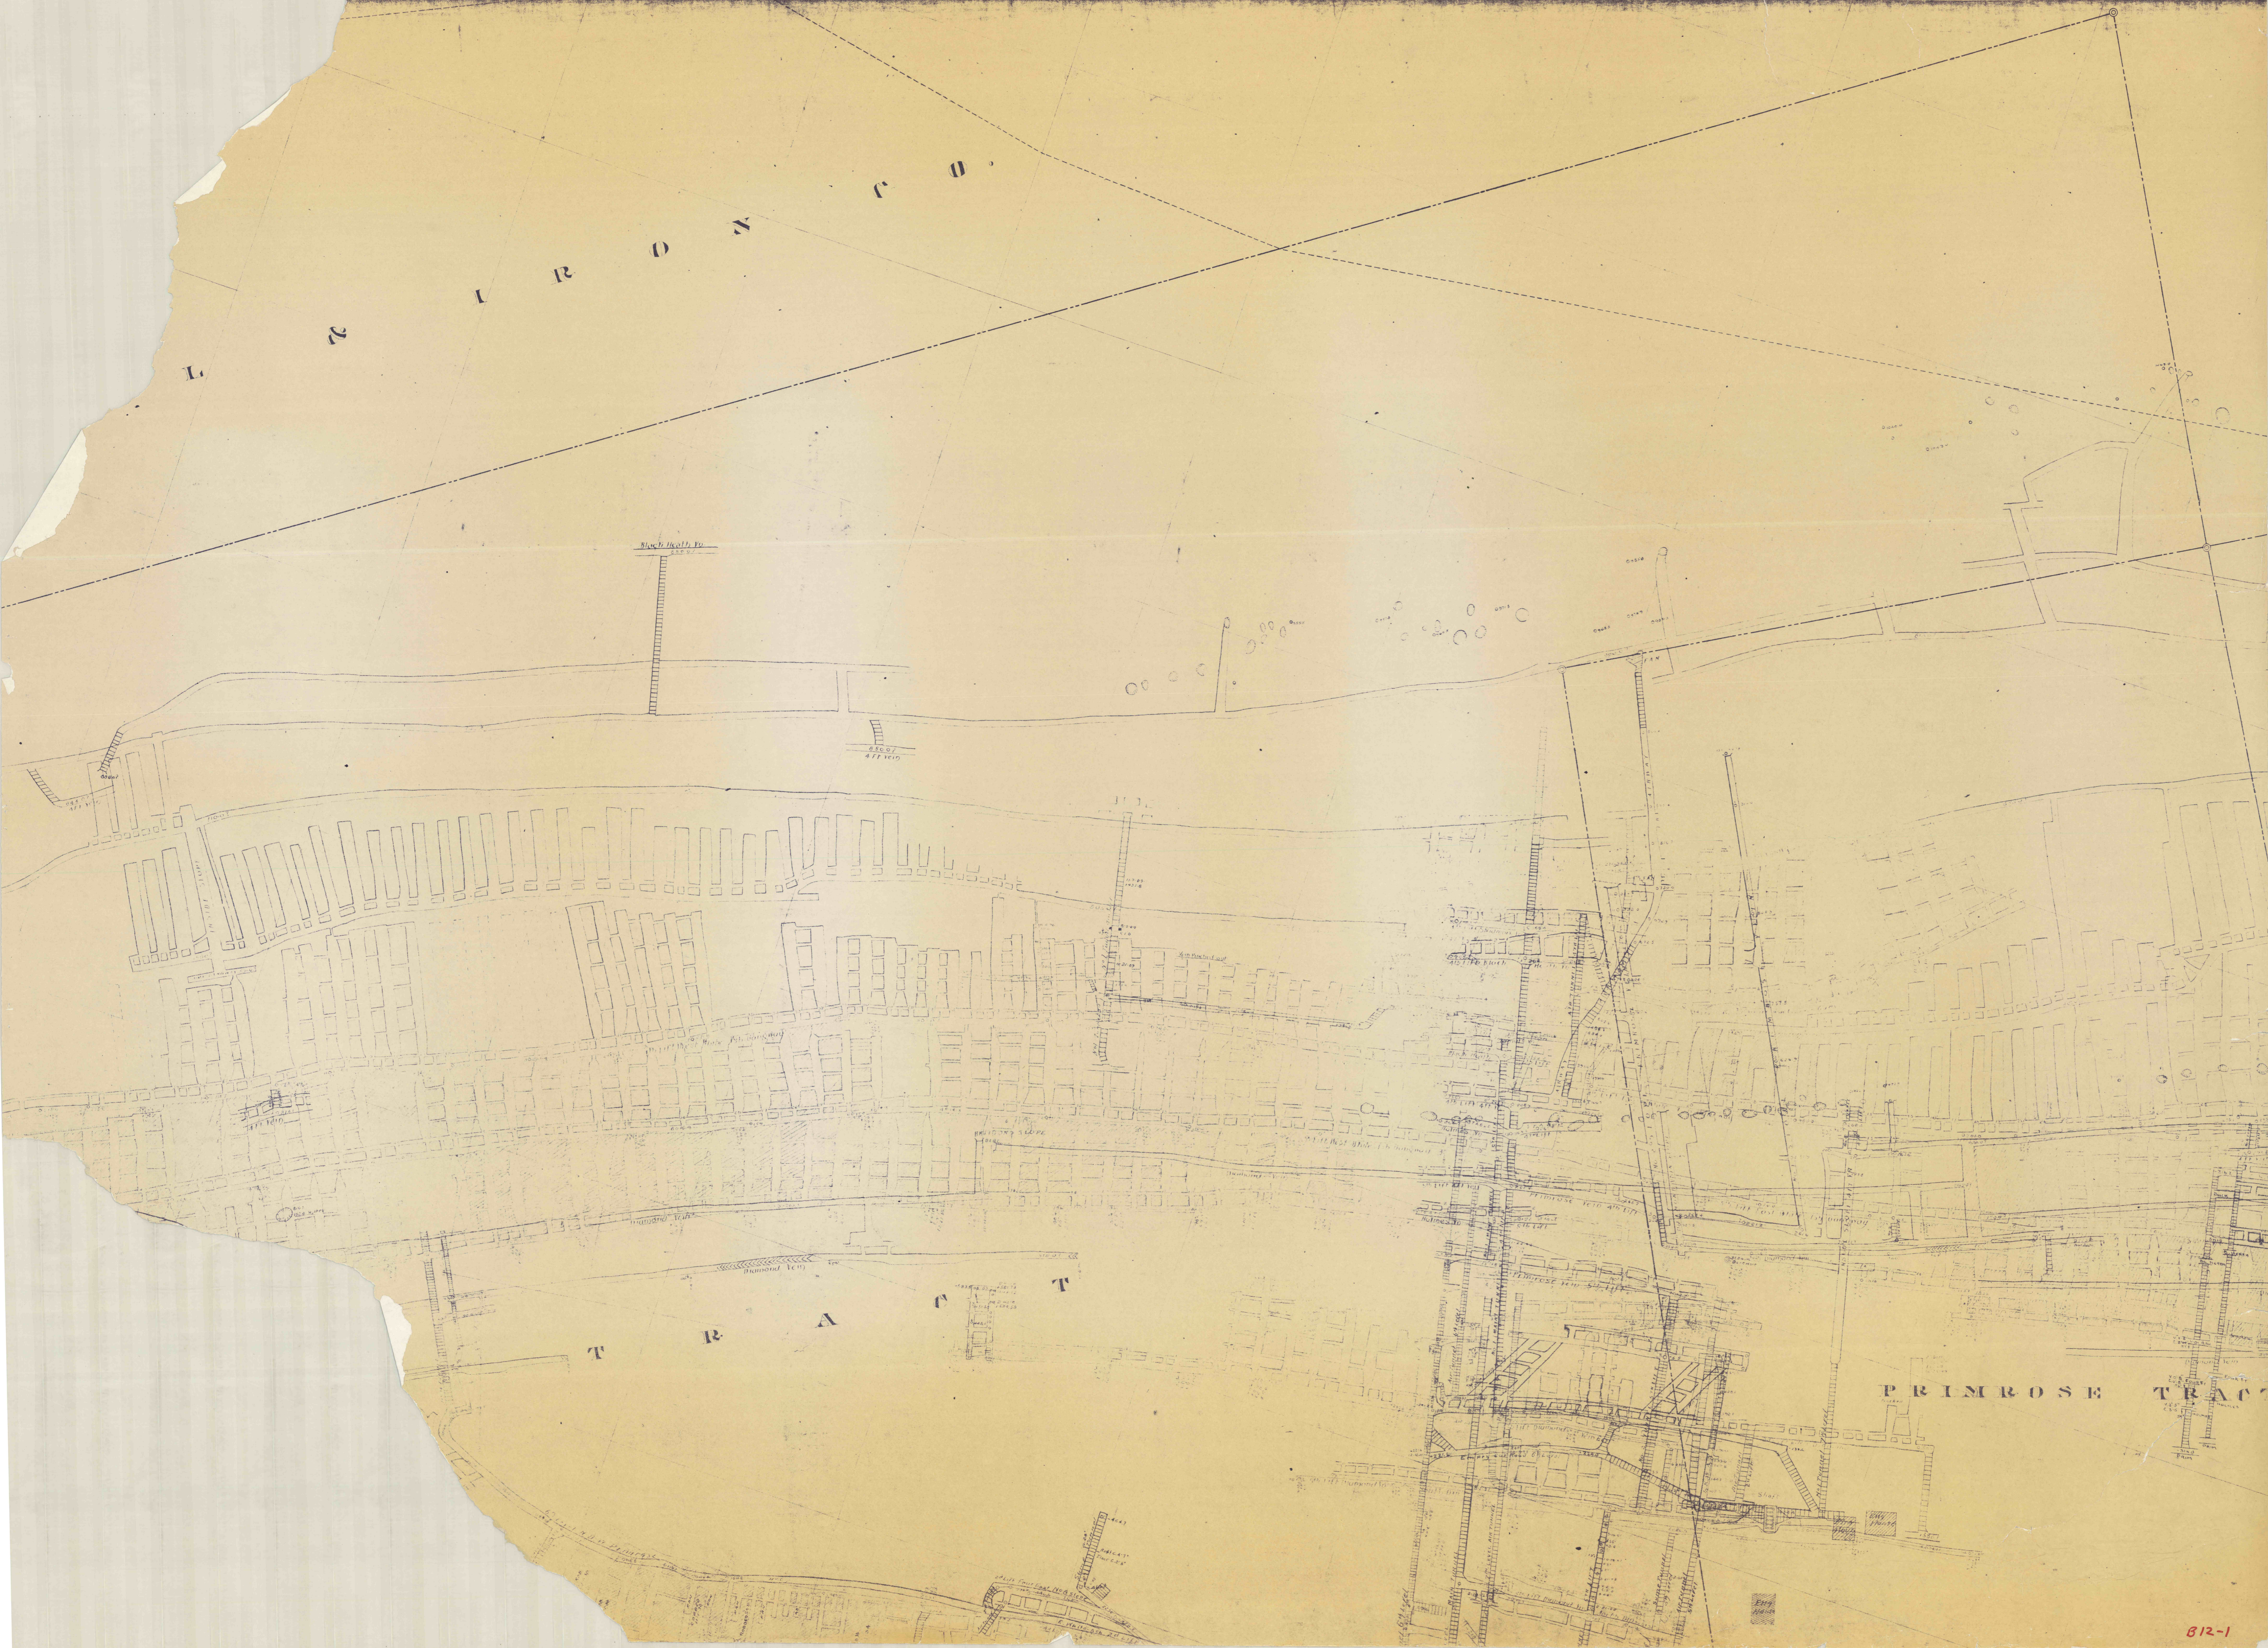

PRIMROSE TRAC