


16-11
16-7

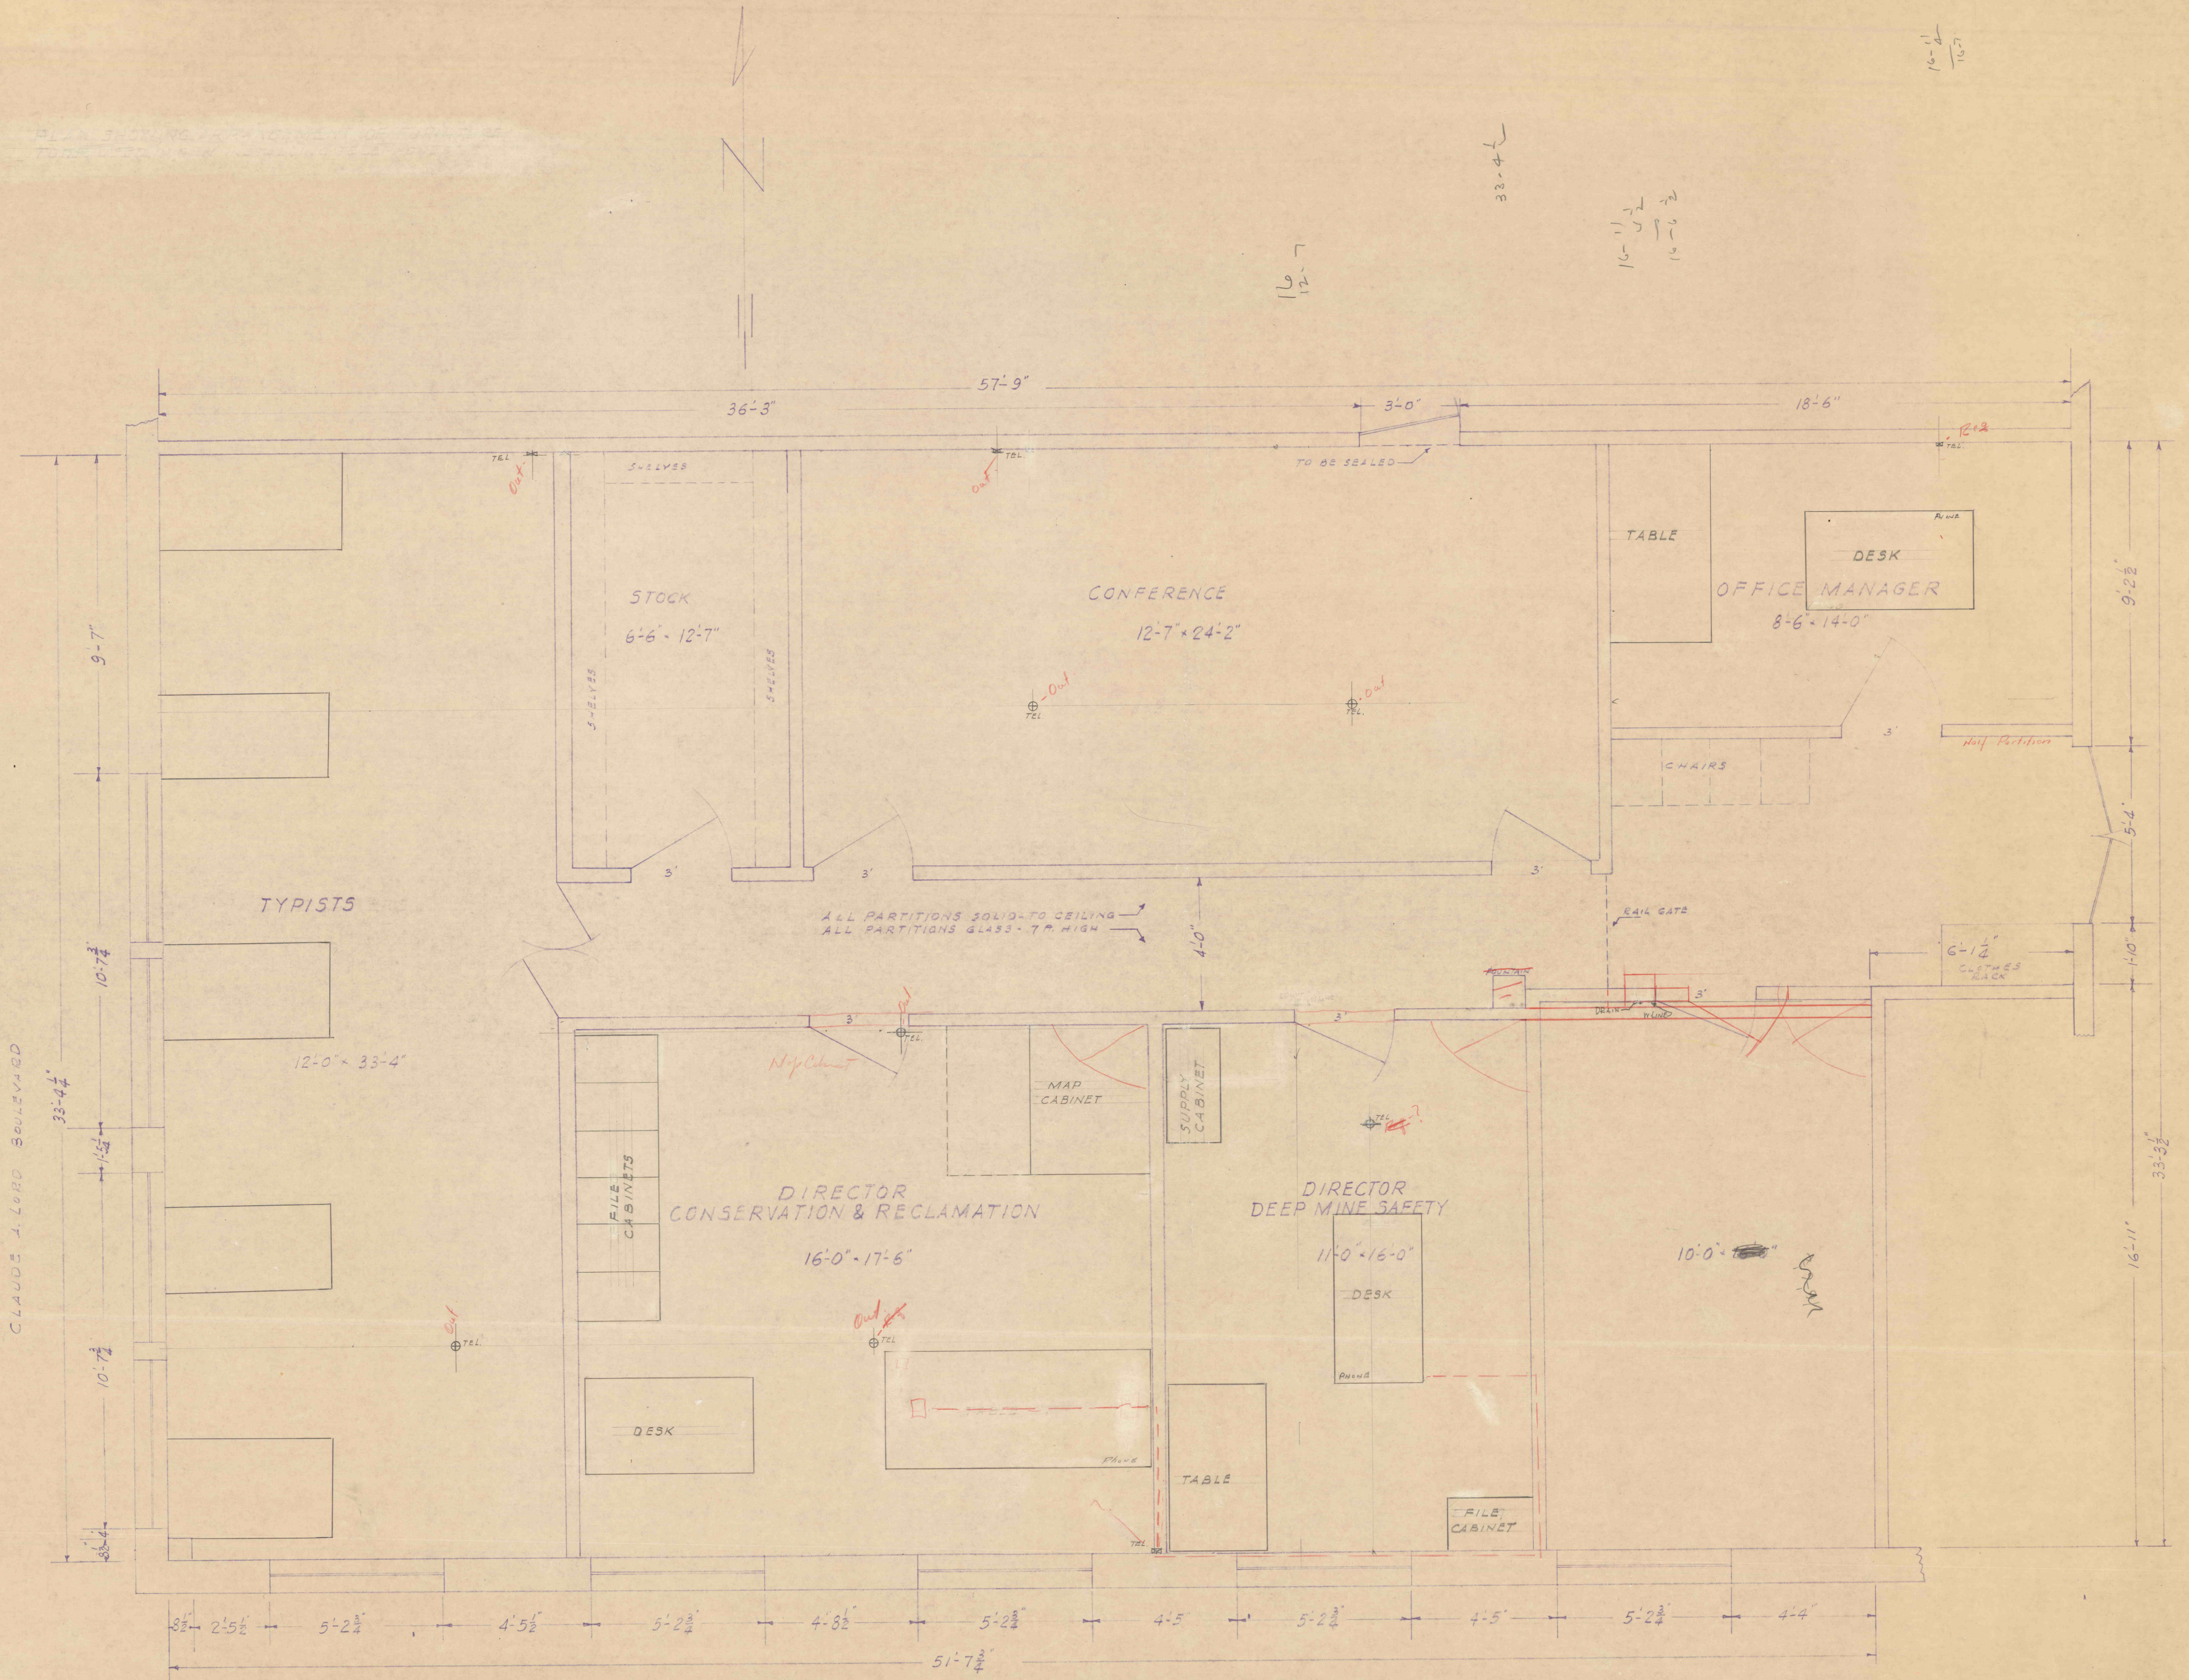

CLAUDE A. LORD BOULEVARD

ROOM 3
OFFICE SPACE
POTTSVILLE
SCALE 1/2" = 1'-0" NOV. 1968