


CLAUDE A. LORE BOULEVARD

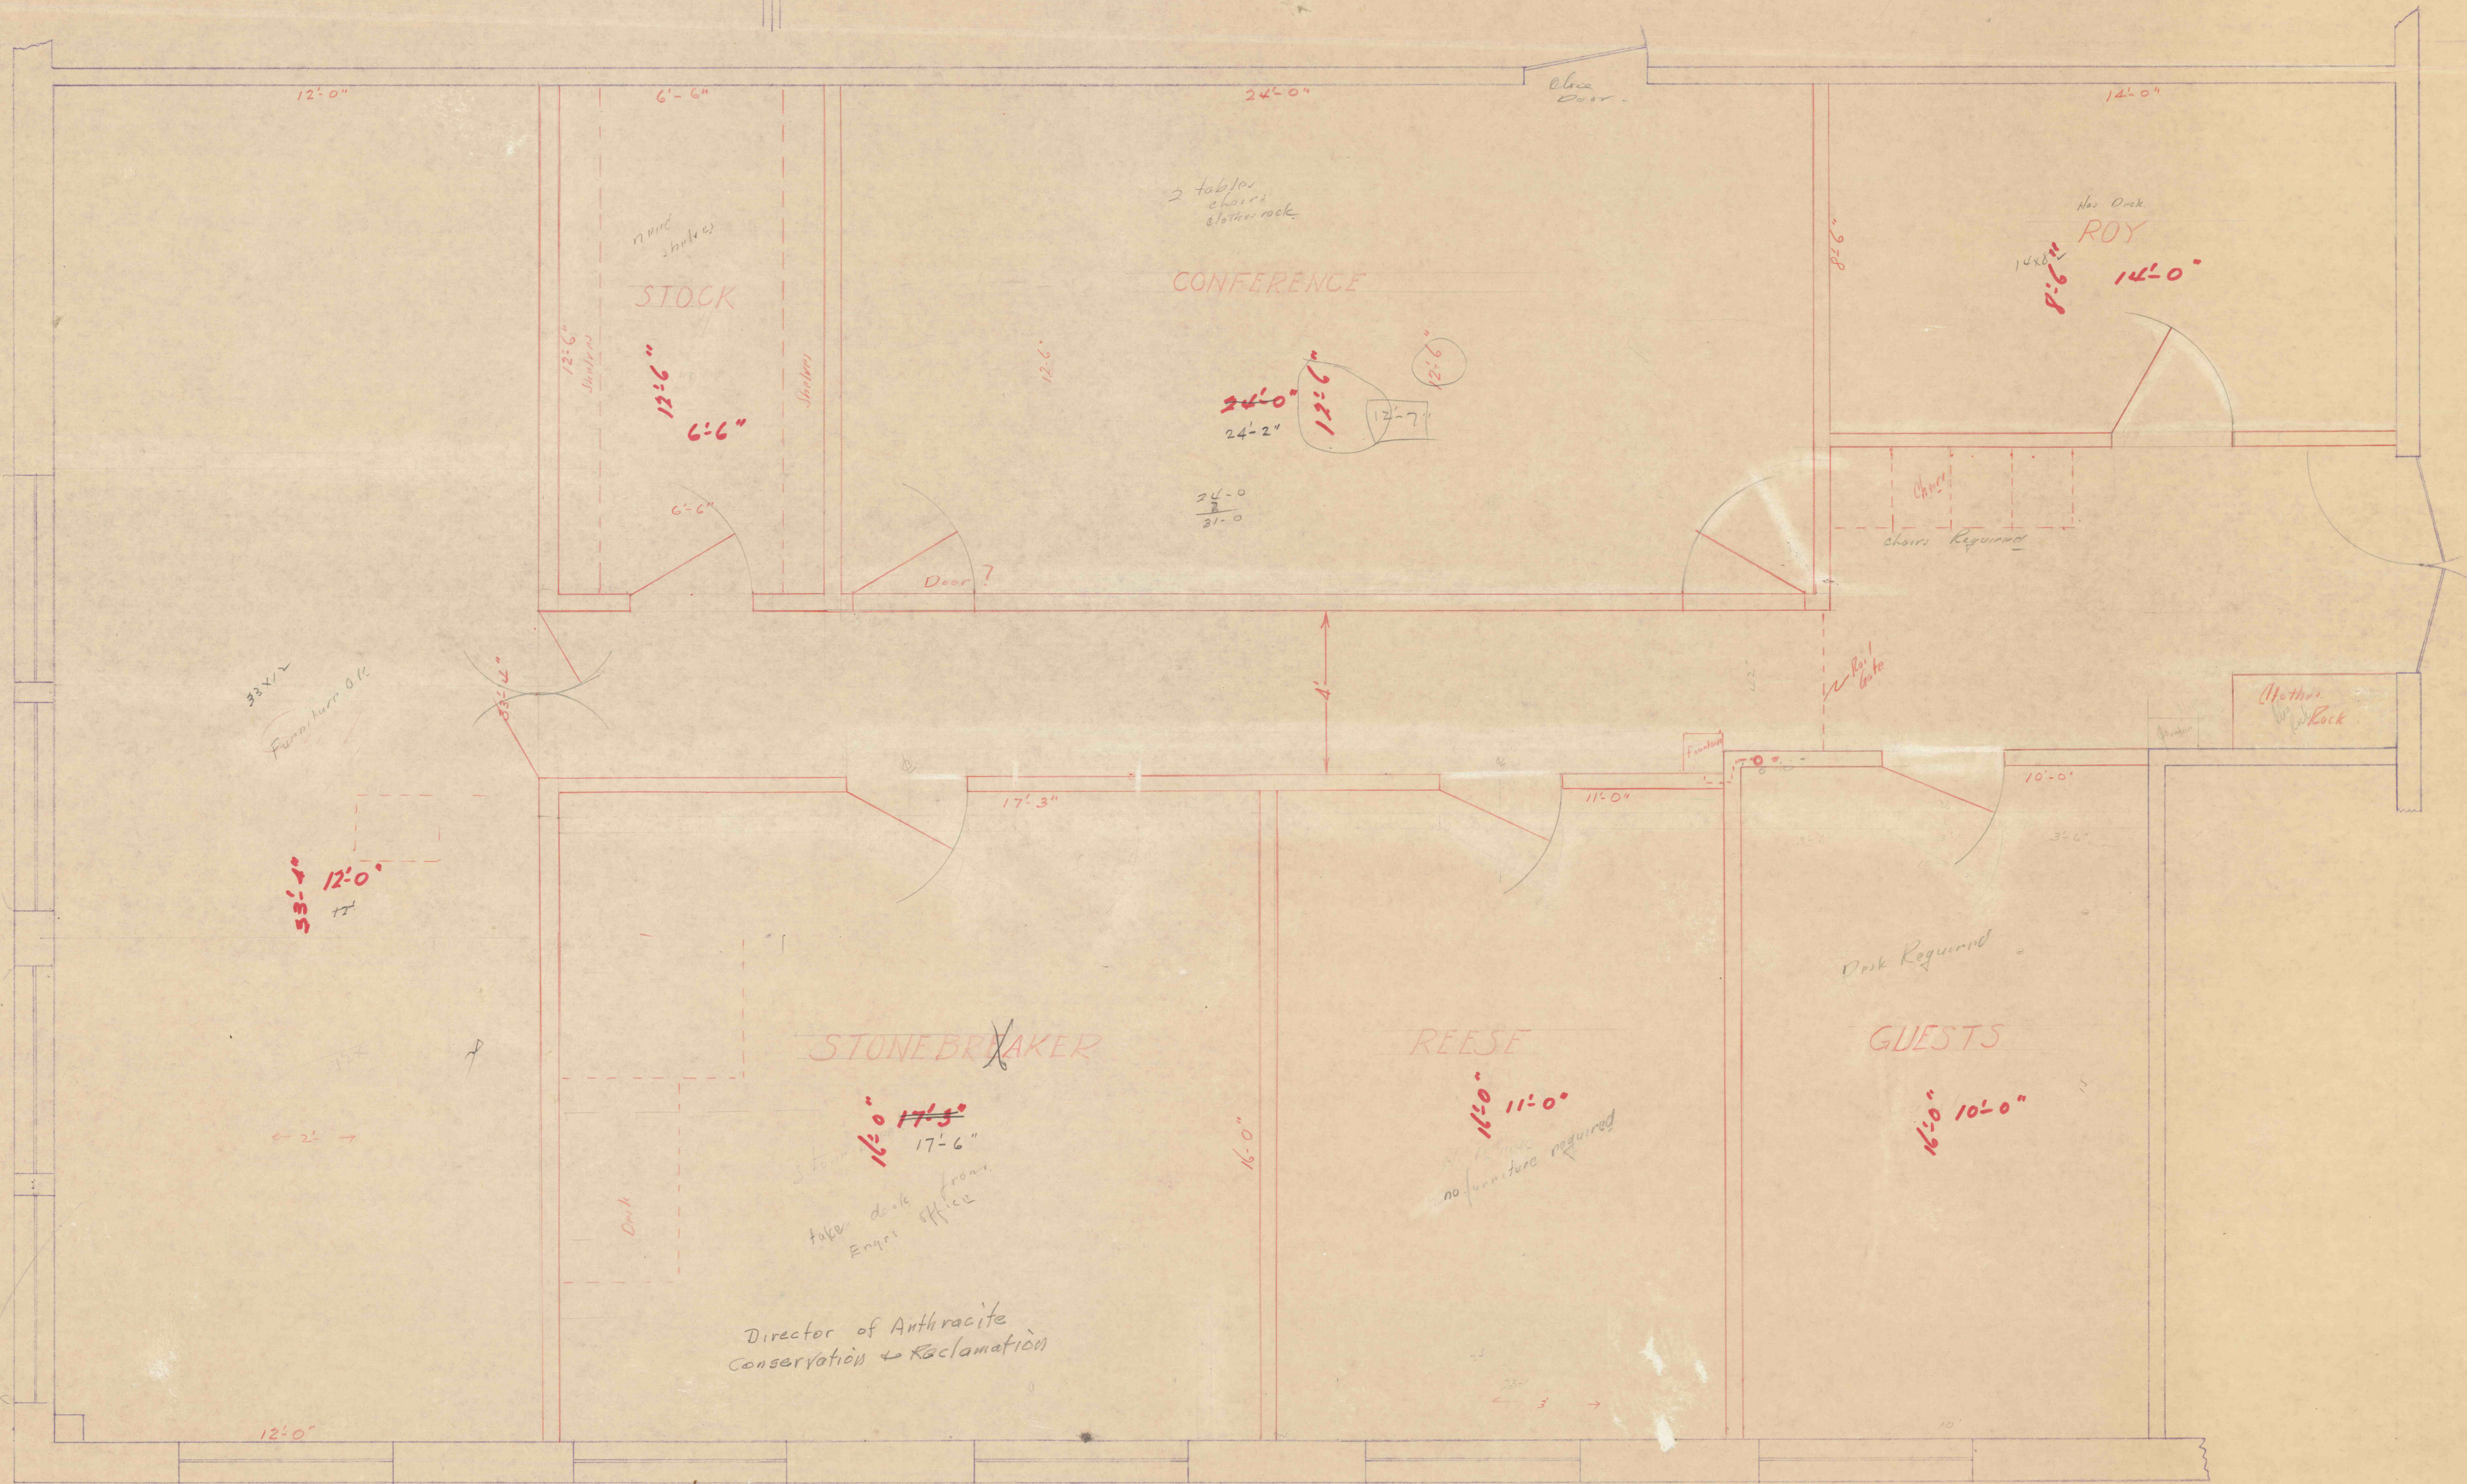

SCALE 3/4" = 1'-0"

16
12
32
14
32
24

579