

1600

1600

1500


1500

1400

1400

1300

1300

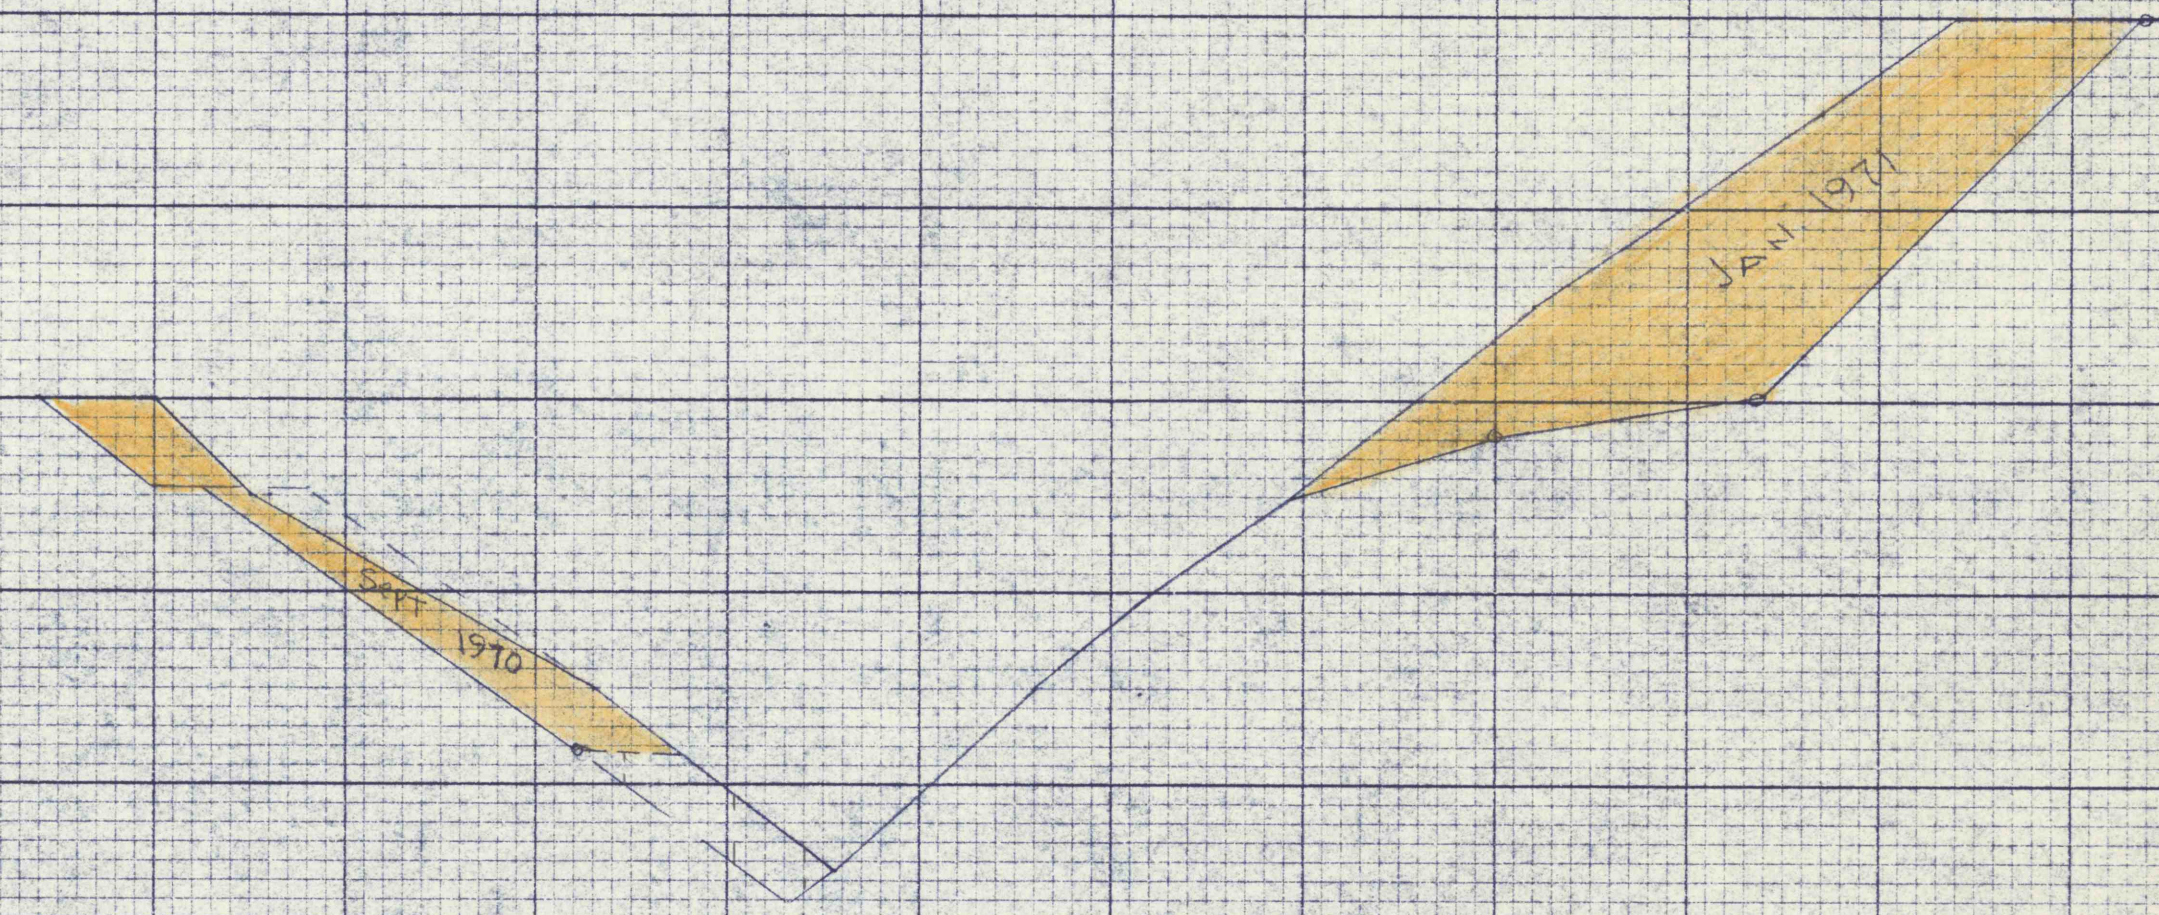

BEE 10X10

3+0
BEE 10X10

BEE 10X10

HAZLETON
BEE 10X10