

1600

1600

1500


1500

1400

1400

1300

1300

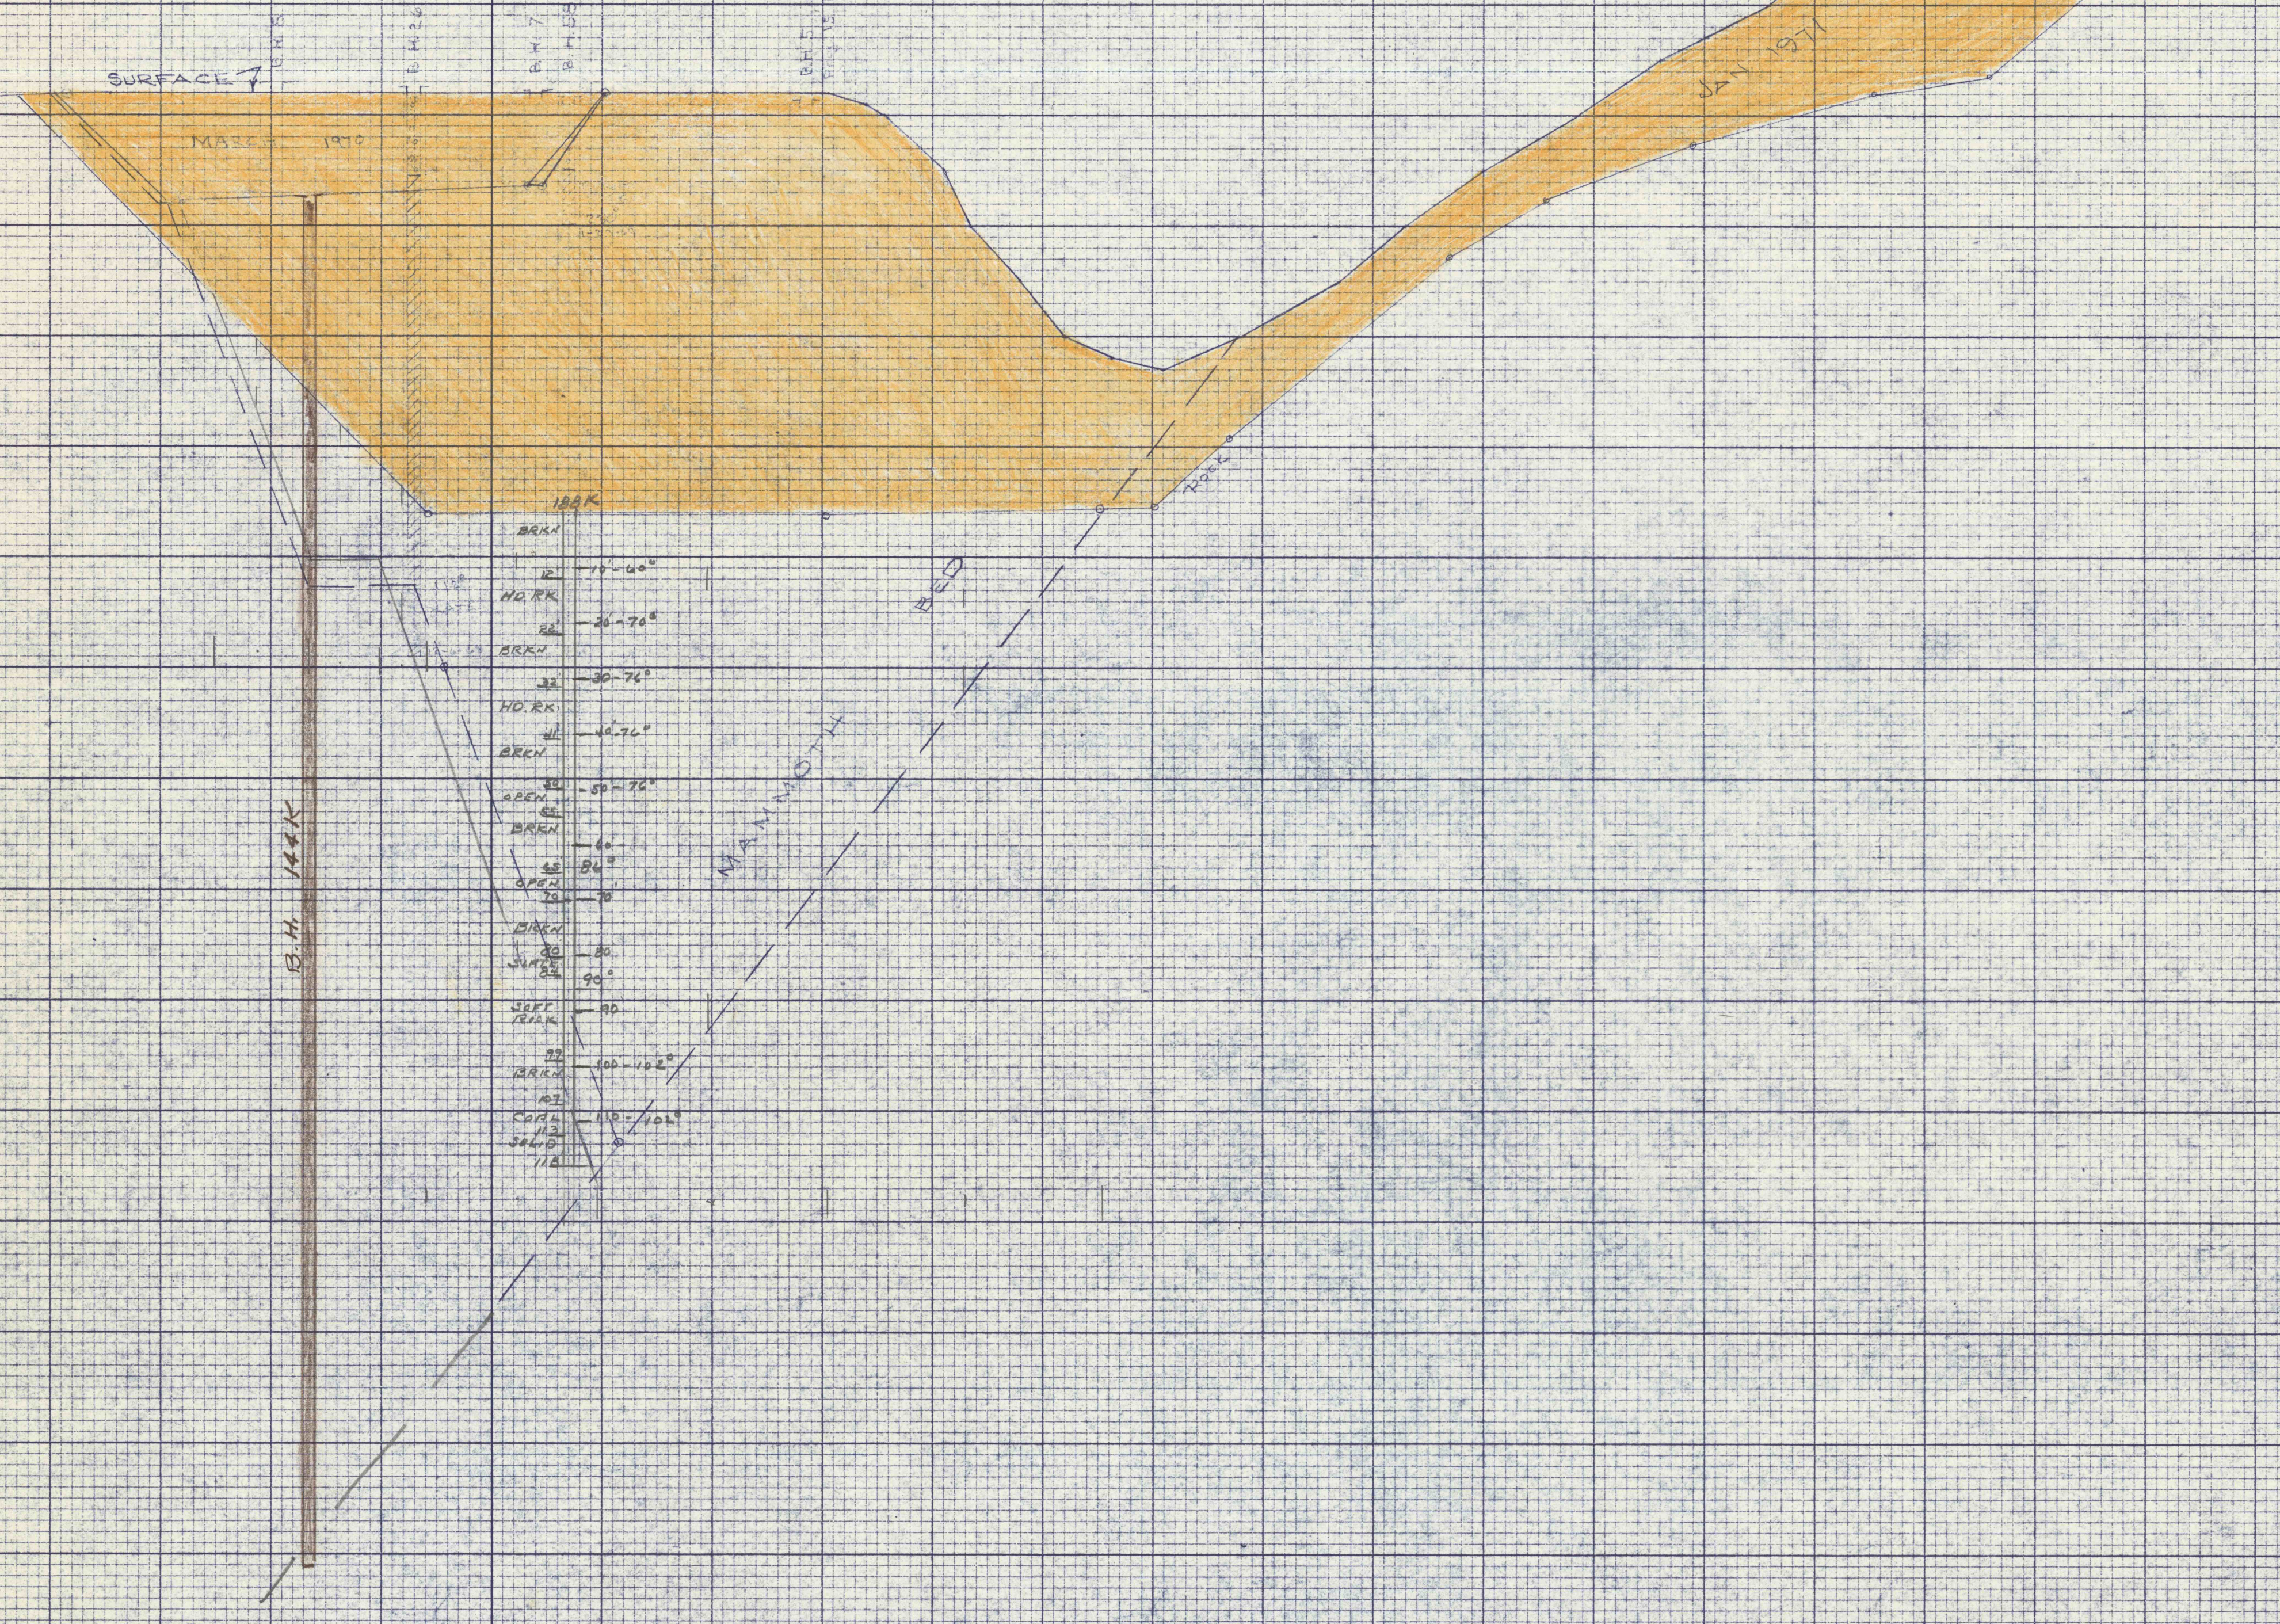

5+50

SCALE 1"=20'

HAZLETON