

1600

1600

1500


1500

1400

1400

1300

1300

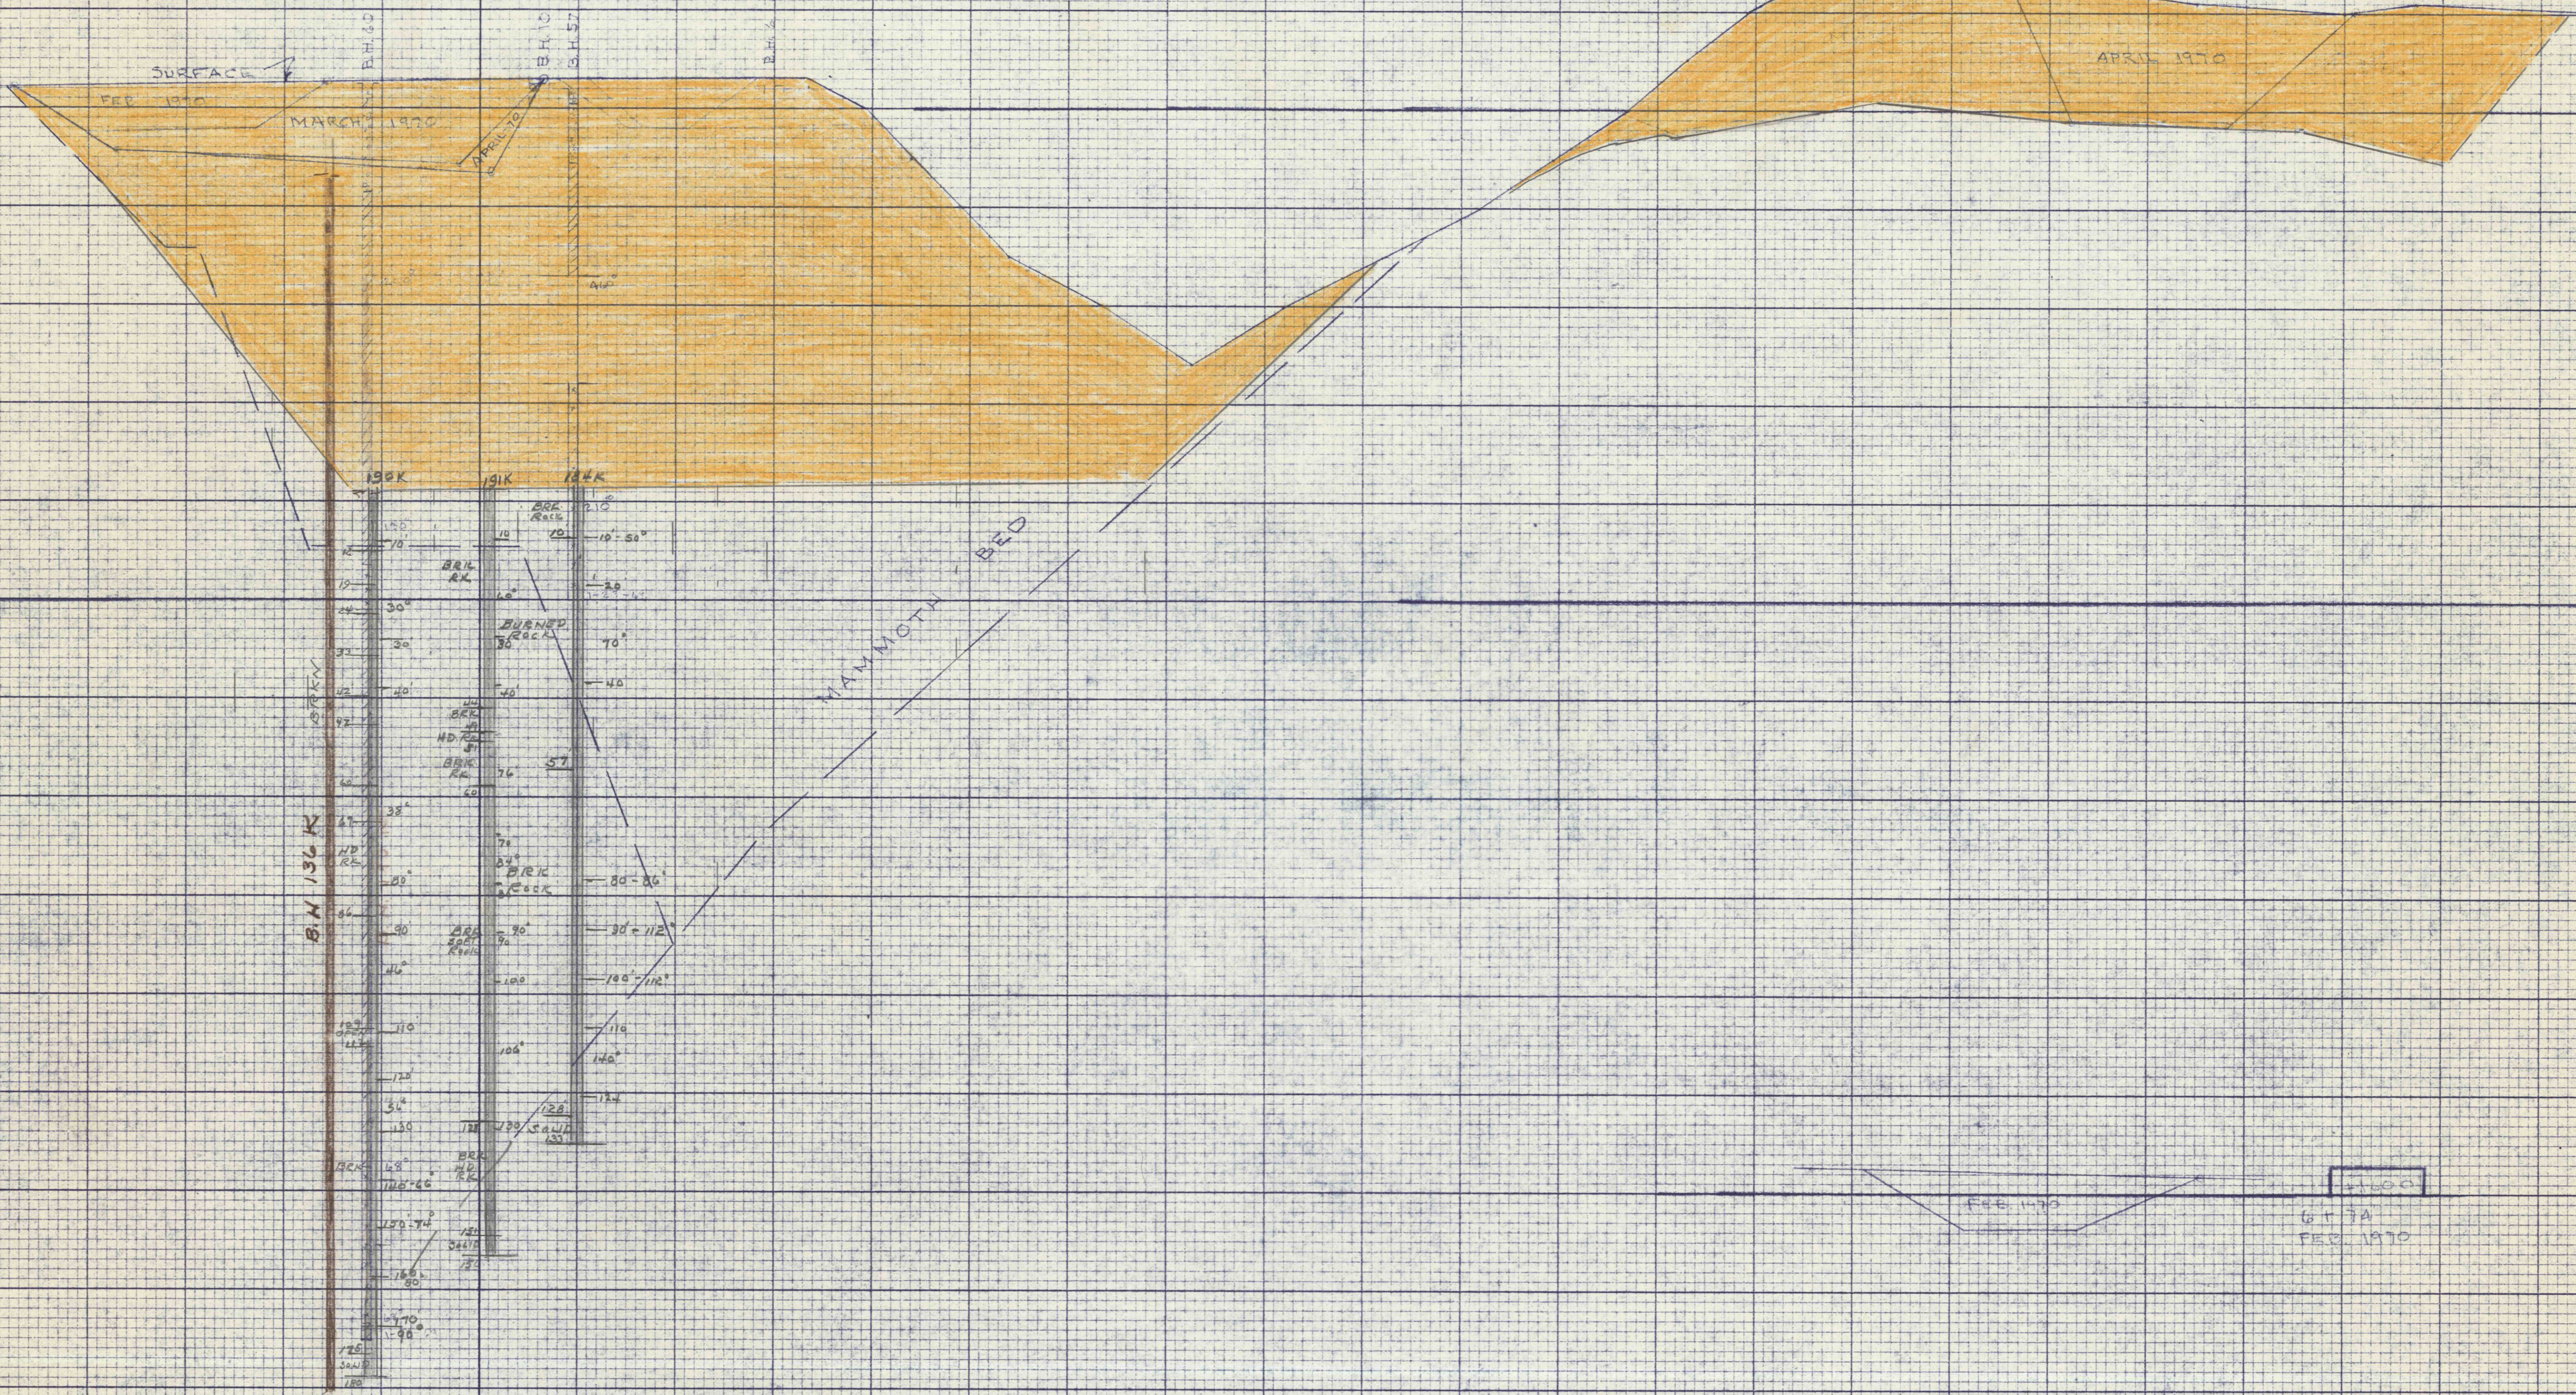

6+50

SCALE 1"=50'