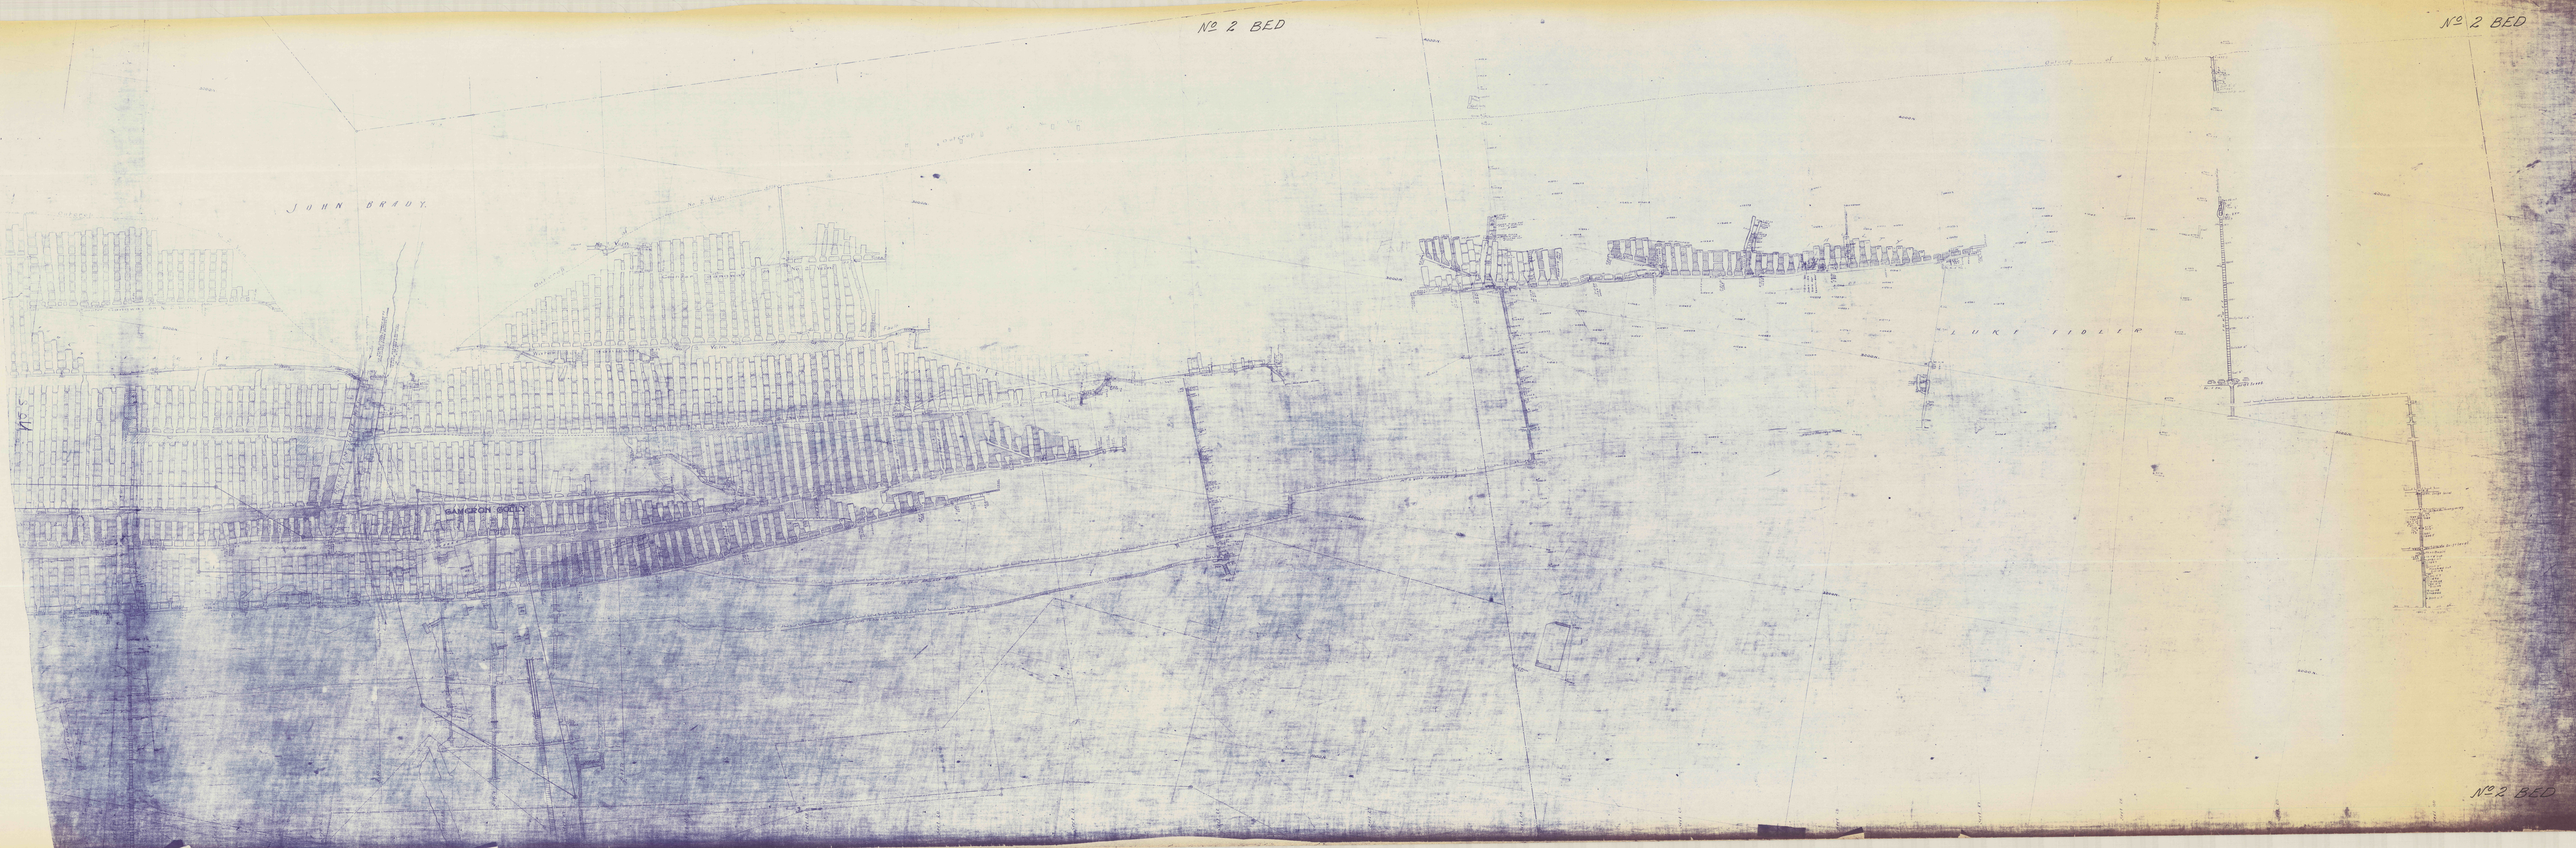
Nº 2 BED
JOHN BRADY
LUKE FIDLER
Nº 2 BED
Nº 2 BED