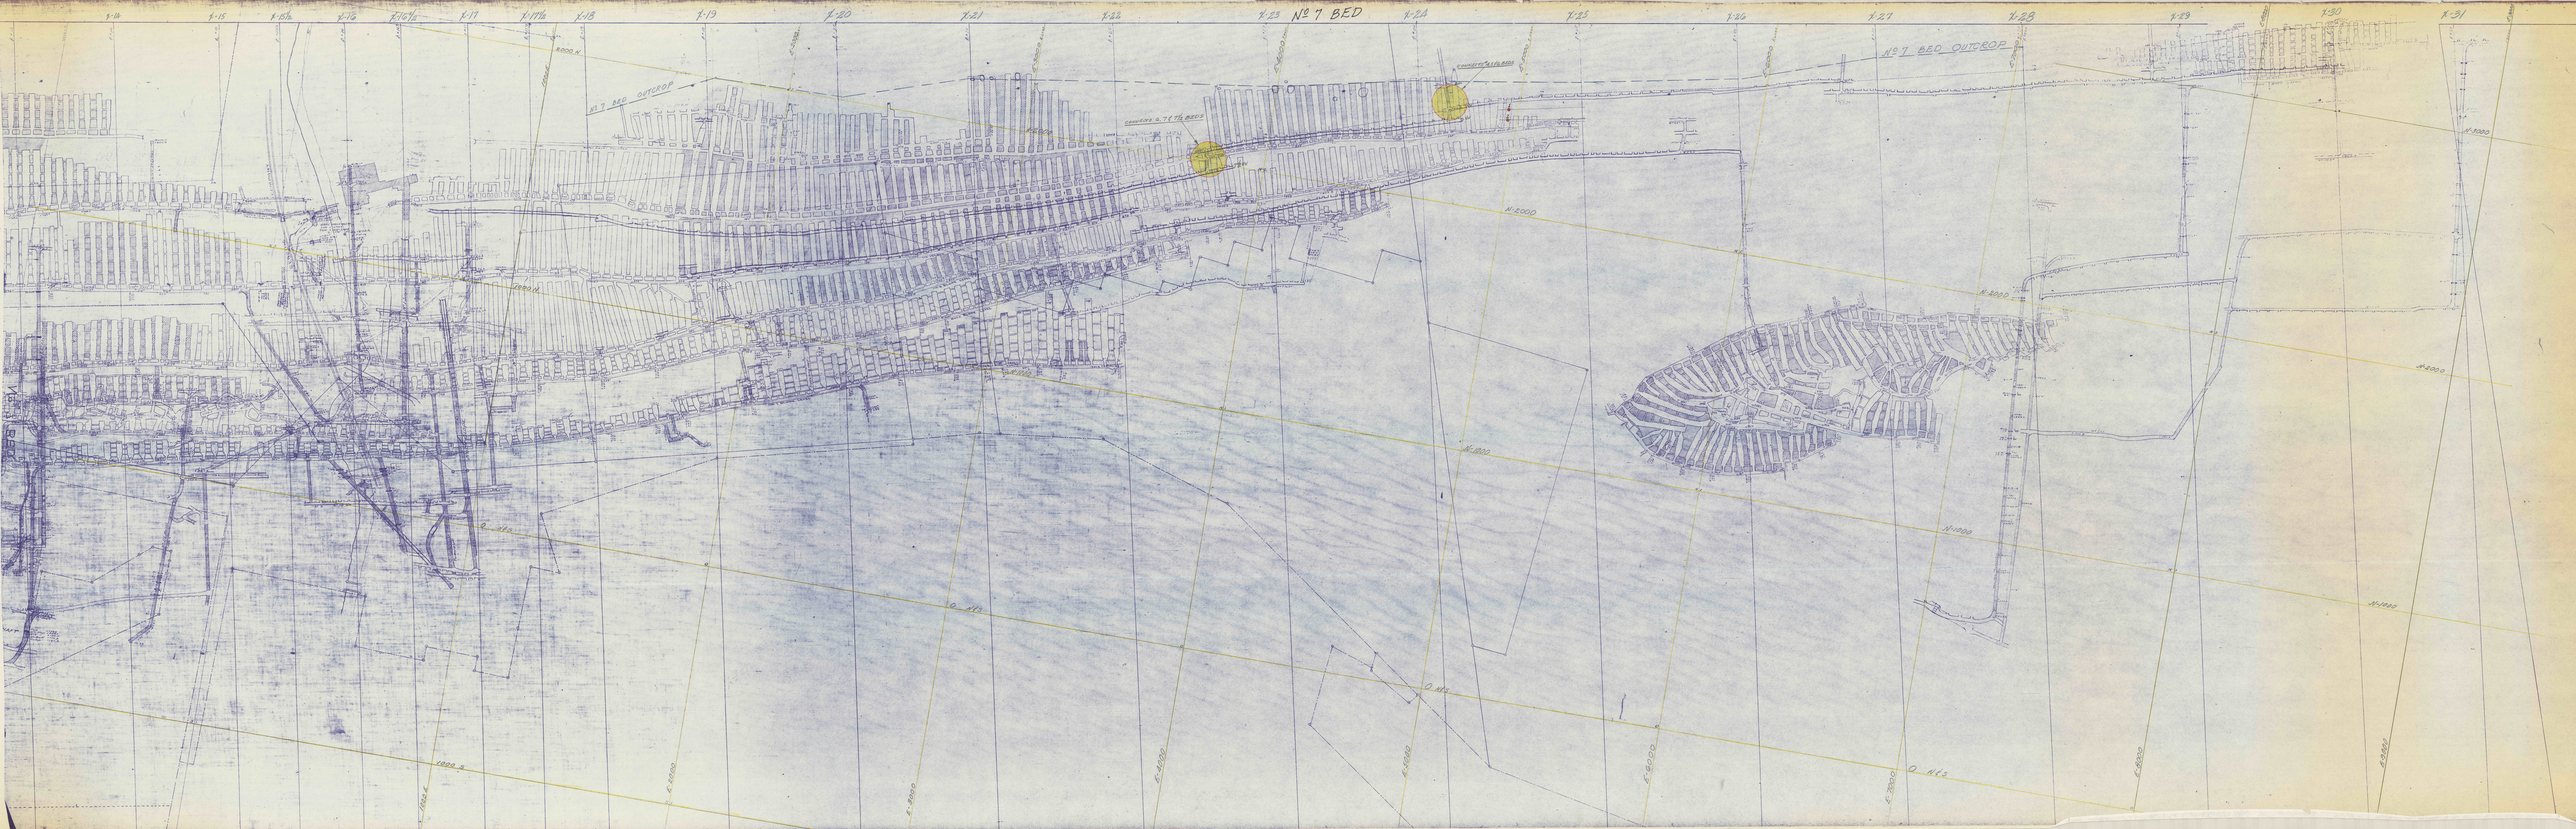

Nº 7 BED
X-14
X-15
X-15½
X-16
X-16½
X-17
X-17½
X-18
X-19
X-20
X-21
X-22
X-23
X-24
X-25
X-26
X-27
X-28
X-29
X-30
X-31
2000 N
Nº 7 BED OUTCROP
Nº 7 BED OUTCROP
CONNECTS 6, 7 & 7½ BEDS
CONNECTS 4.5 & 6 BEDS
N-2000
N-2000
N-2000
N-3000
N-1000
N-1000
N-1000
0 N&S
0 N&S
0 N&S
0 N&S
1000 S
E-2000
E-3000
E-4000
E-5000
E-6000
E-7000
E-8000
E-9000
1000 E