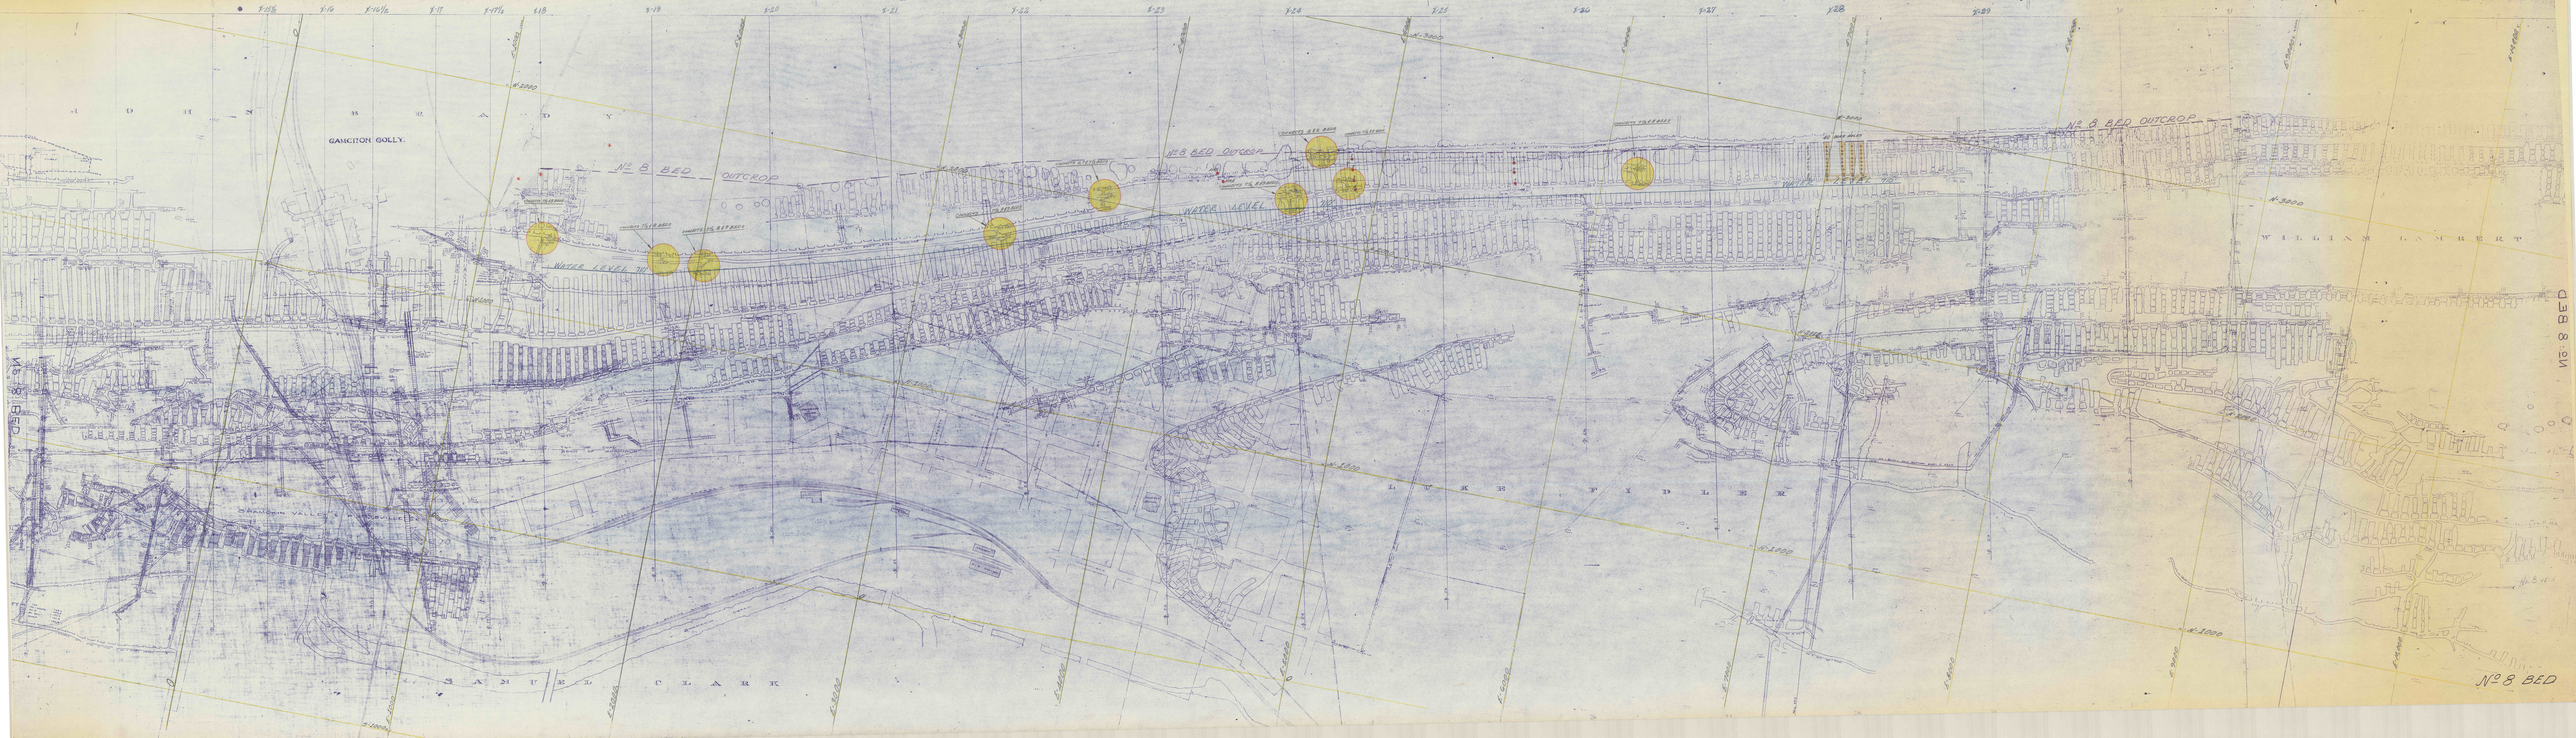
GAMCTON COLLY.
Nº 8 BED OUTCROP
WATER LEVEL
Nº 8 BED OUTCROP
WATER LEVEL
Nº 8 BED OUTCROP
WATER LEVEL
WILLIAM LAMBERT
SAMUEL CLARK
Nº 8 BED
Nº 8 BED
Nº 8 BED