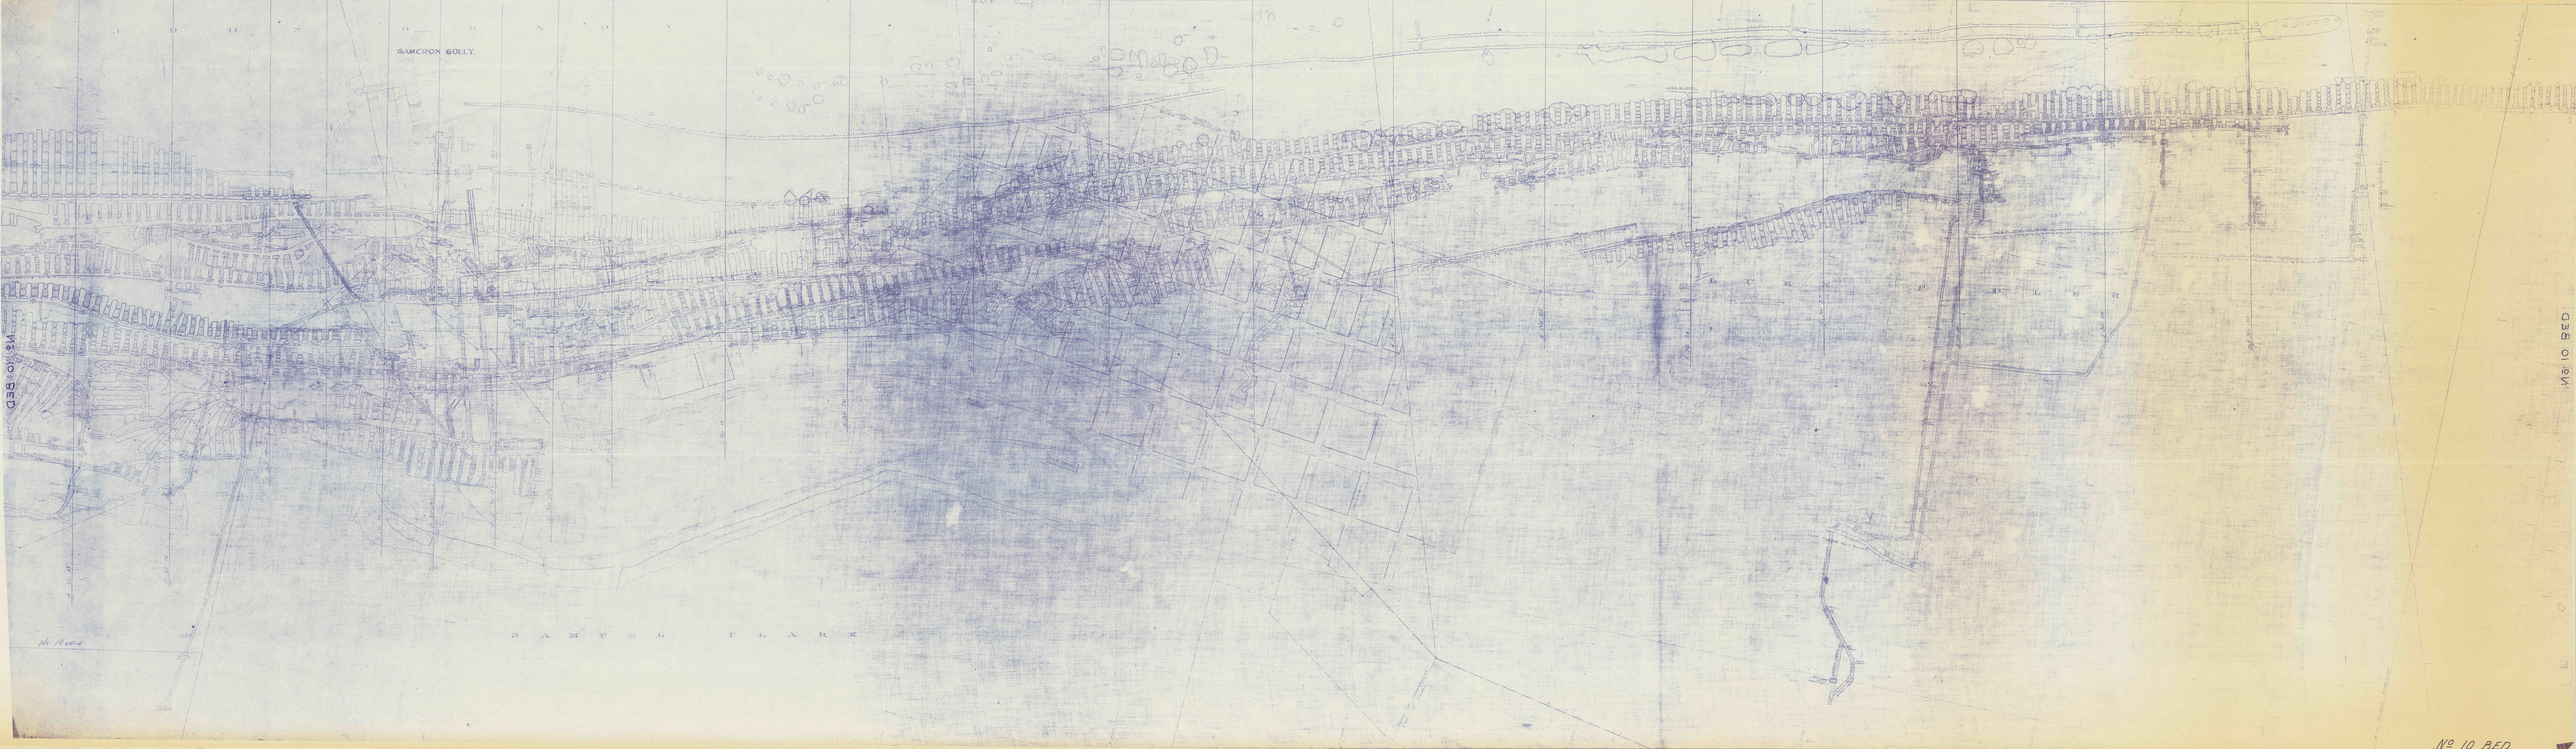
CAMERON GOLLY
No 10 BED
No 10 BED
No 10 BED