


No. 11 BED

TRACT

No. 11 BED

SAMUEL CLARK TRACT

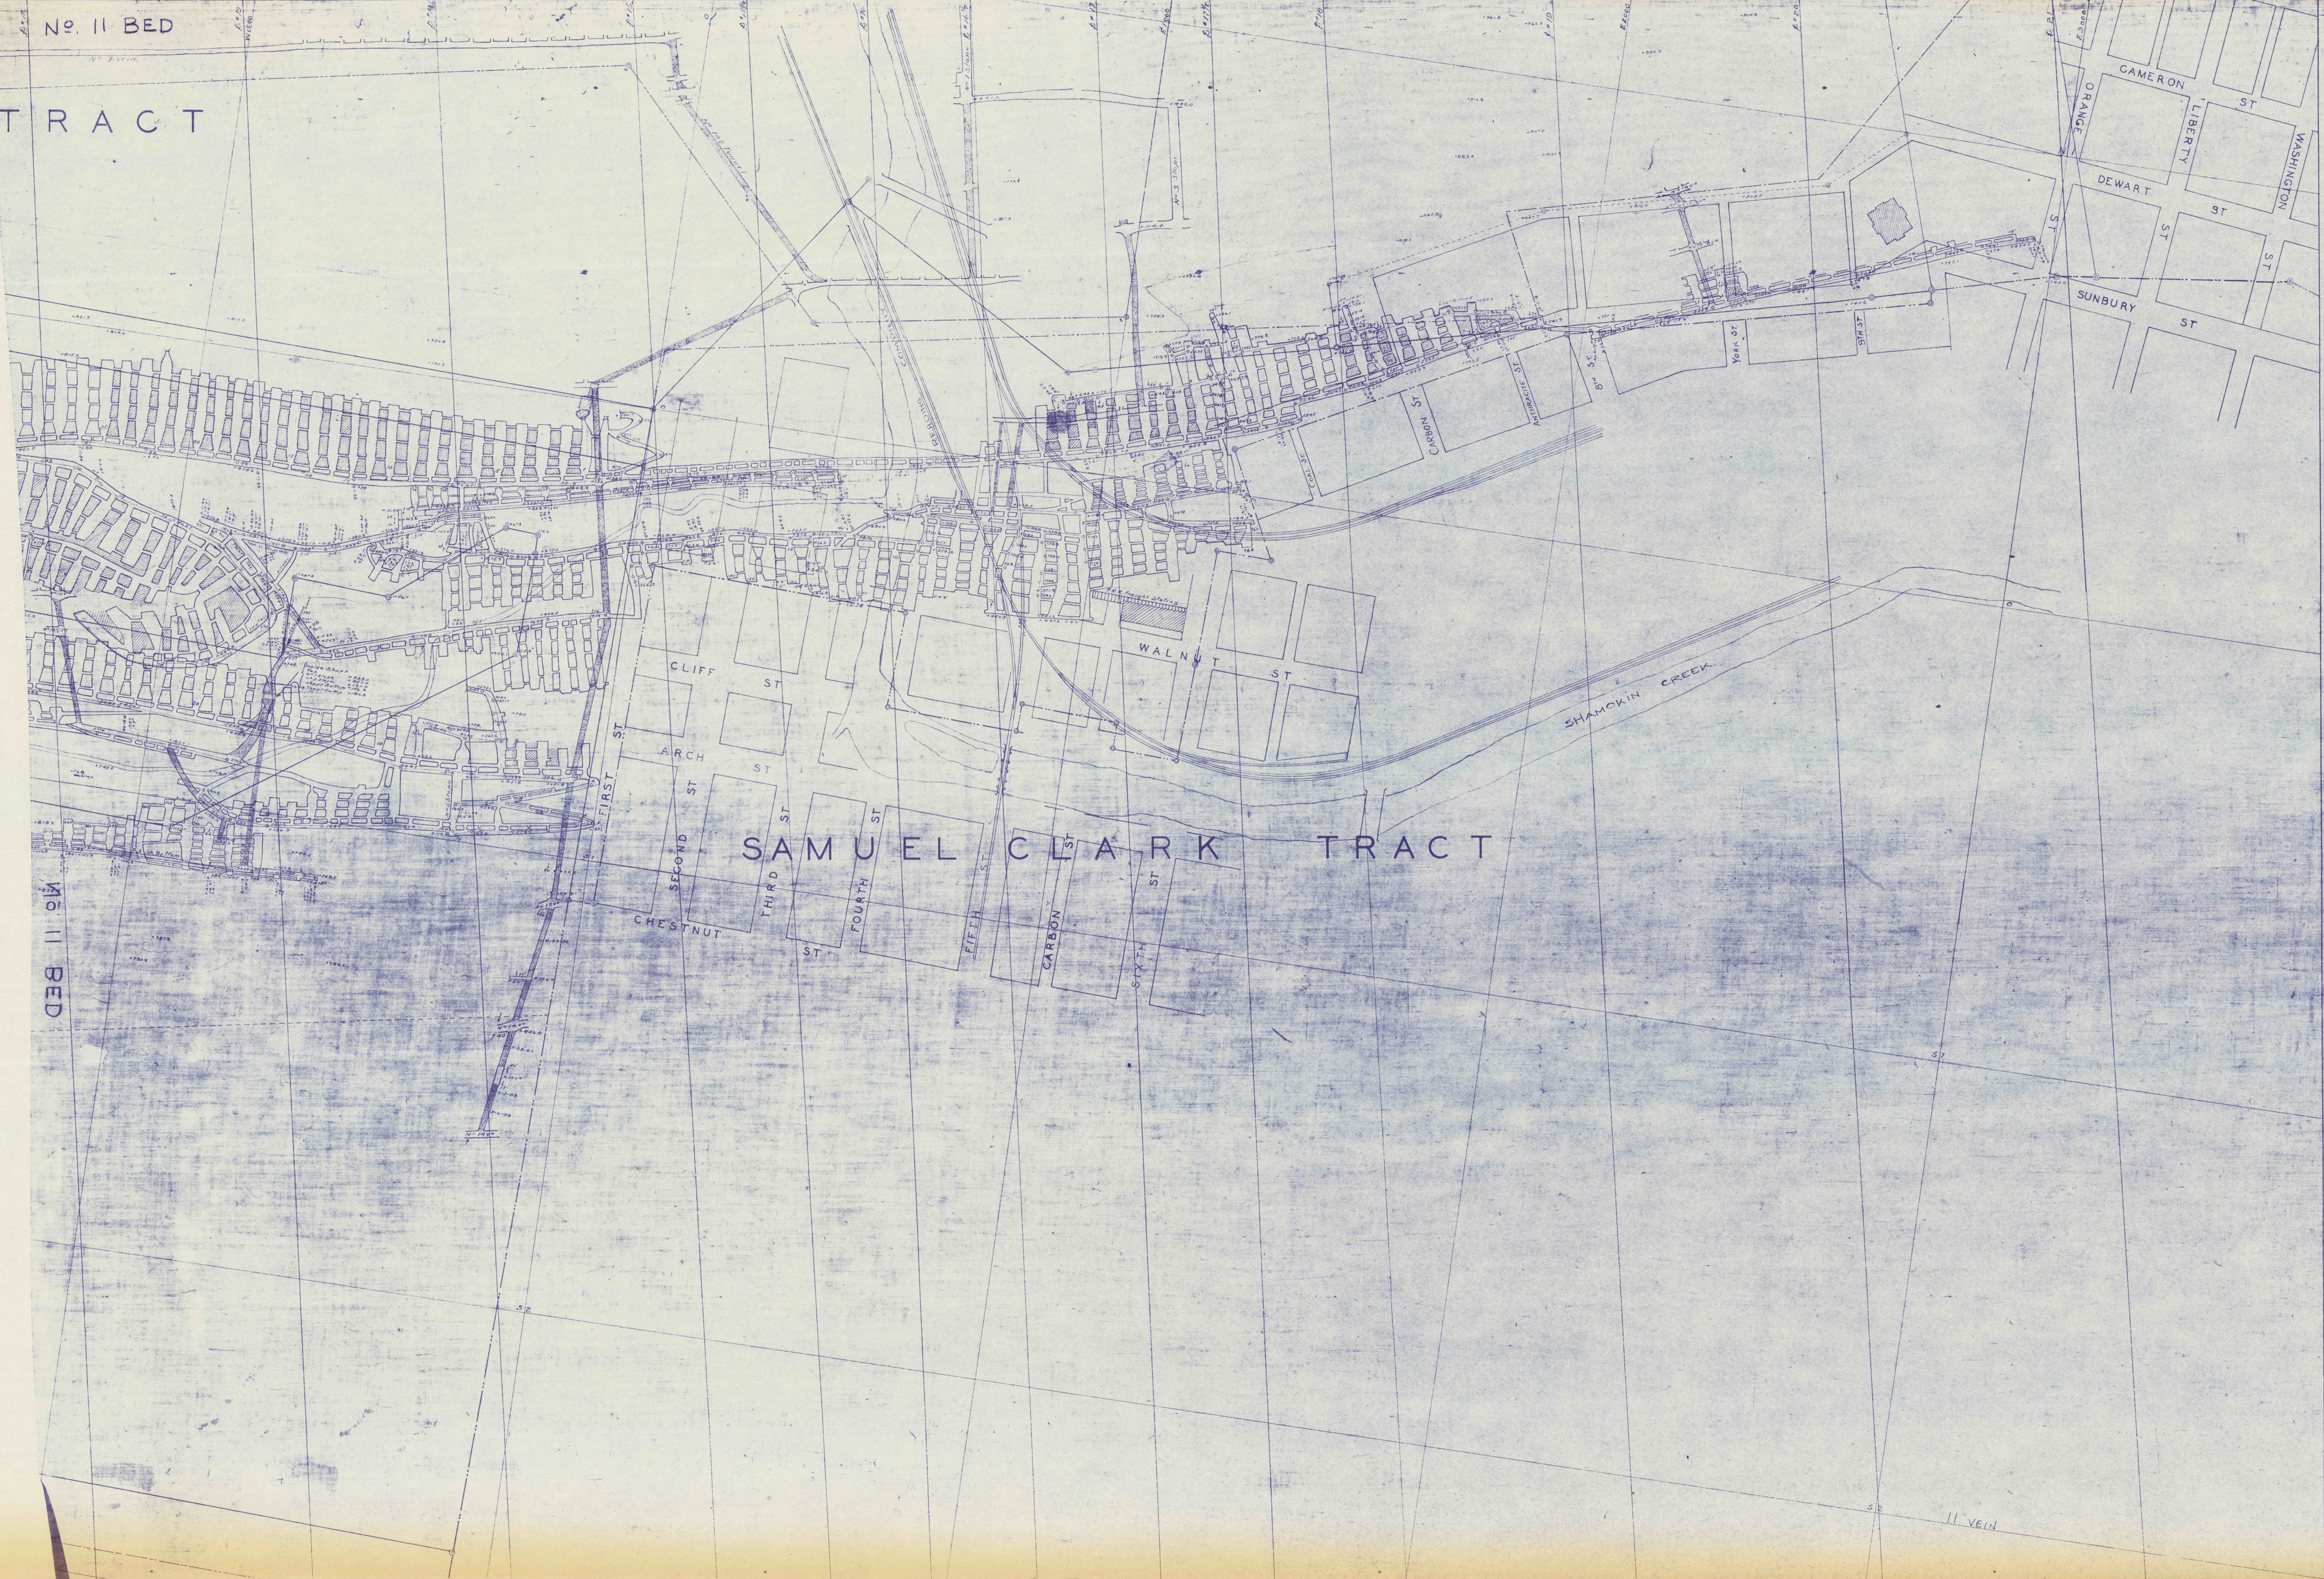

11 VEIN