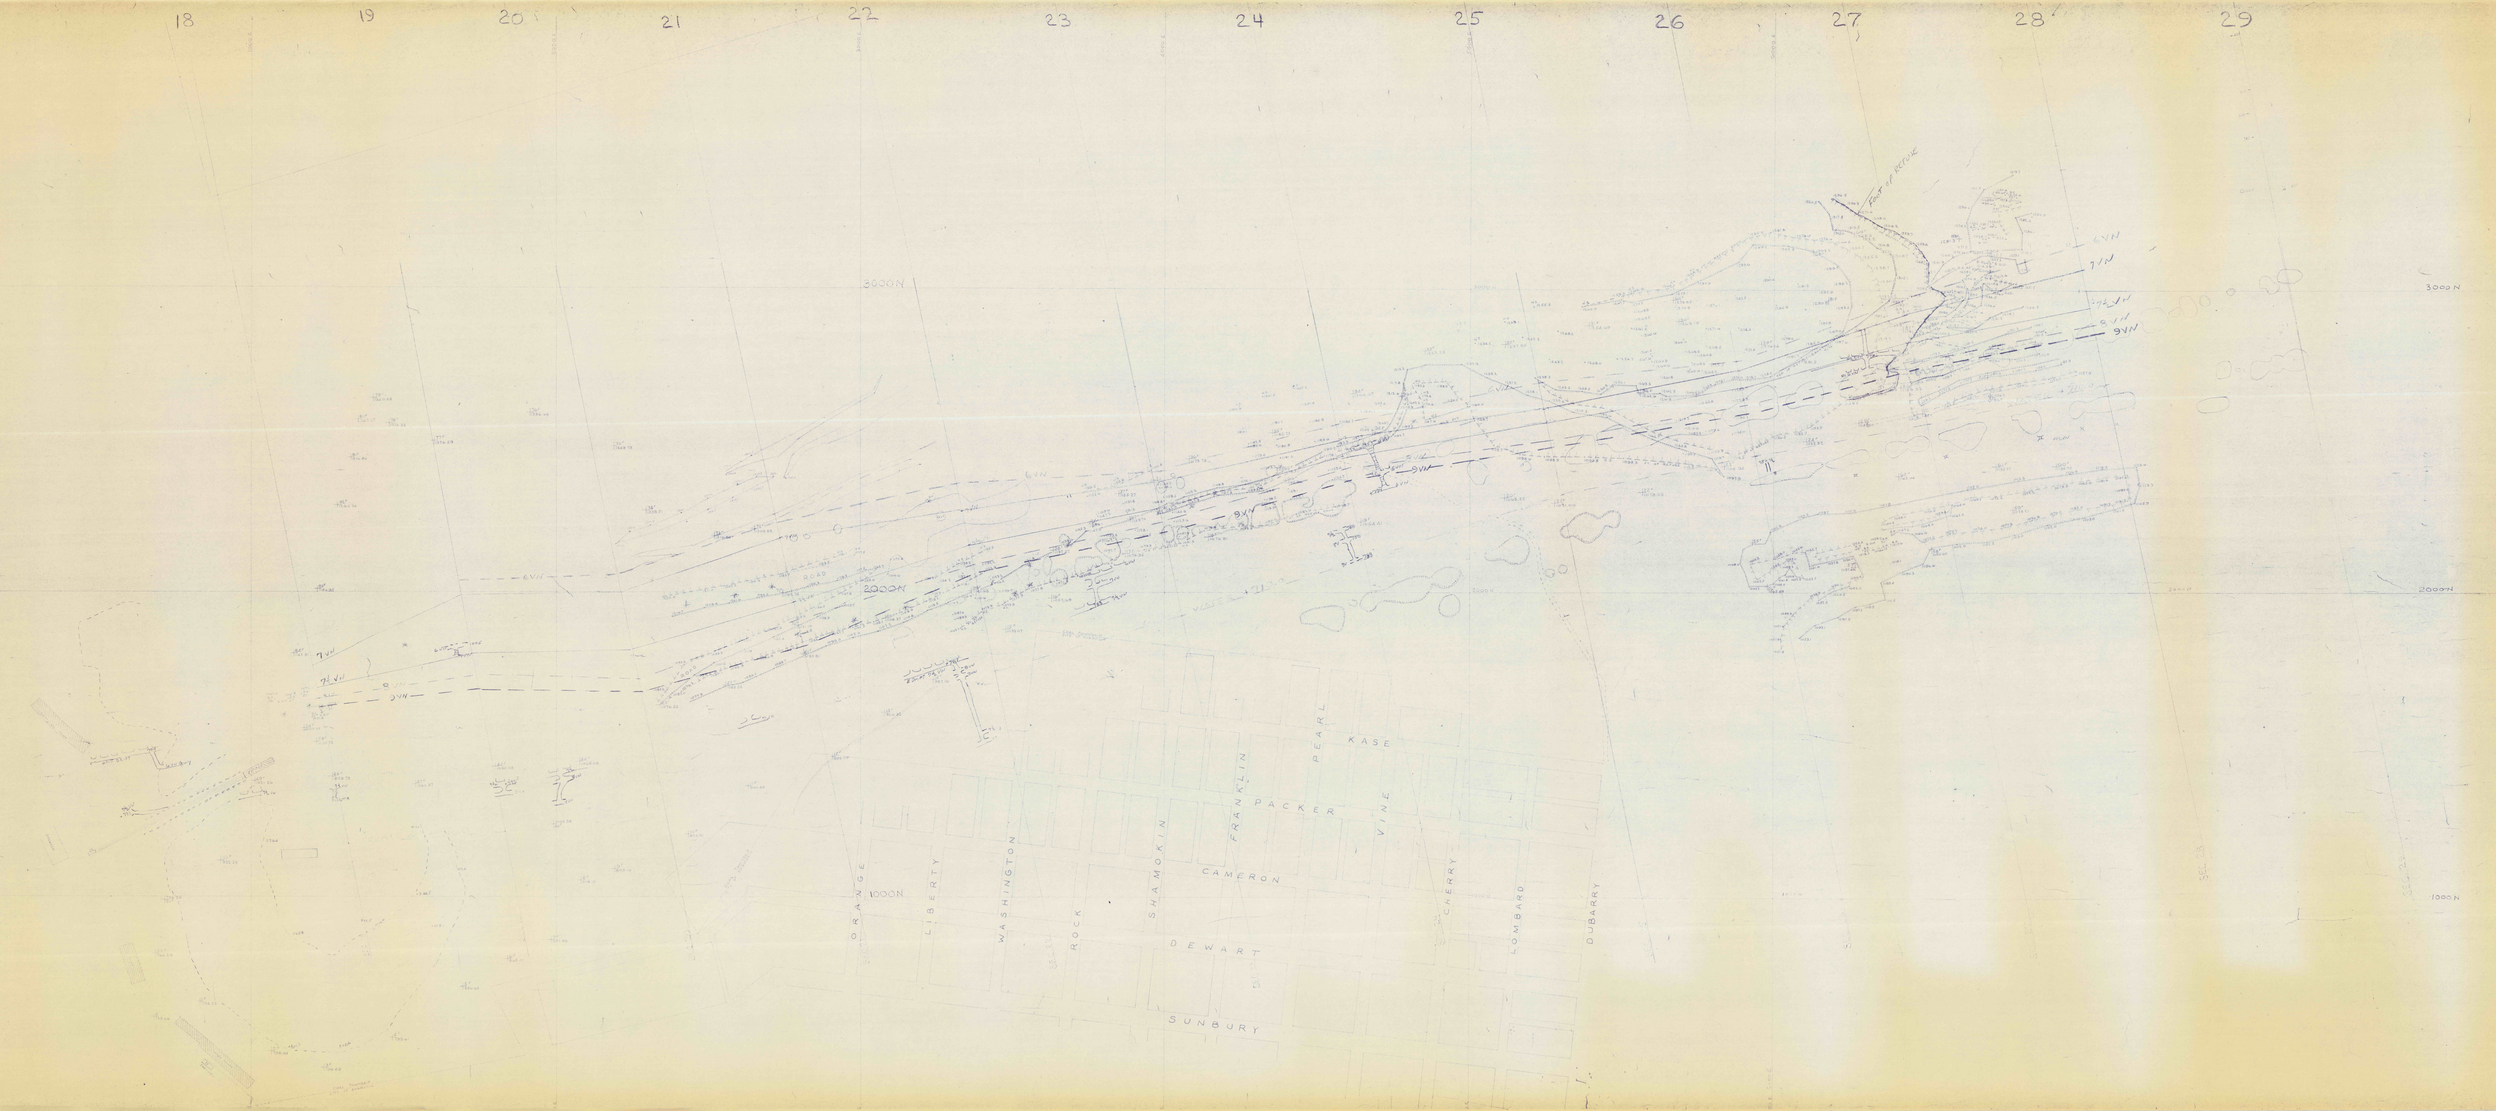
18
19
20
21
22
23
24
25
26
27
28
29
3000N
2000N
1000N
6VN
7VN
8VN
9VN
ORANGE
LIBERTY
WASHINGTON
ROCK
SHAMOKIN
FRANKLIN
PACKER
PEARL
KASE
VINE
CAMERON
CHERRY
LOMBARD
DUBARRY
DEWART
SUNBURY