



GAMERON GOLLY

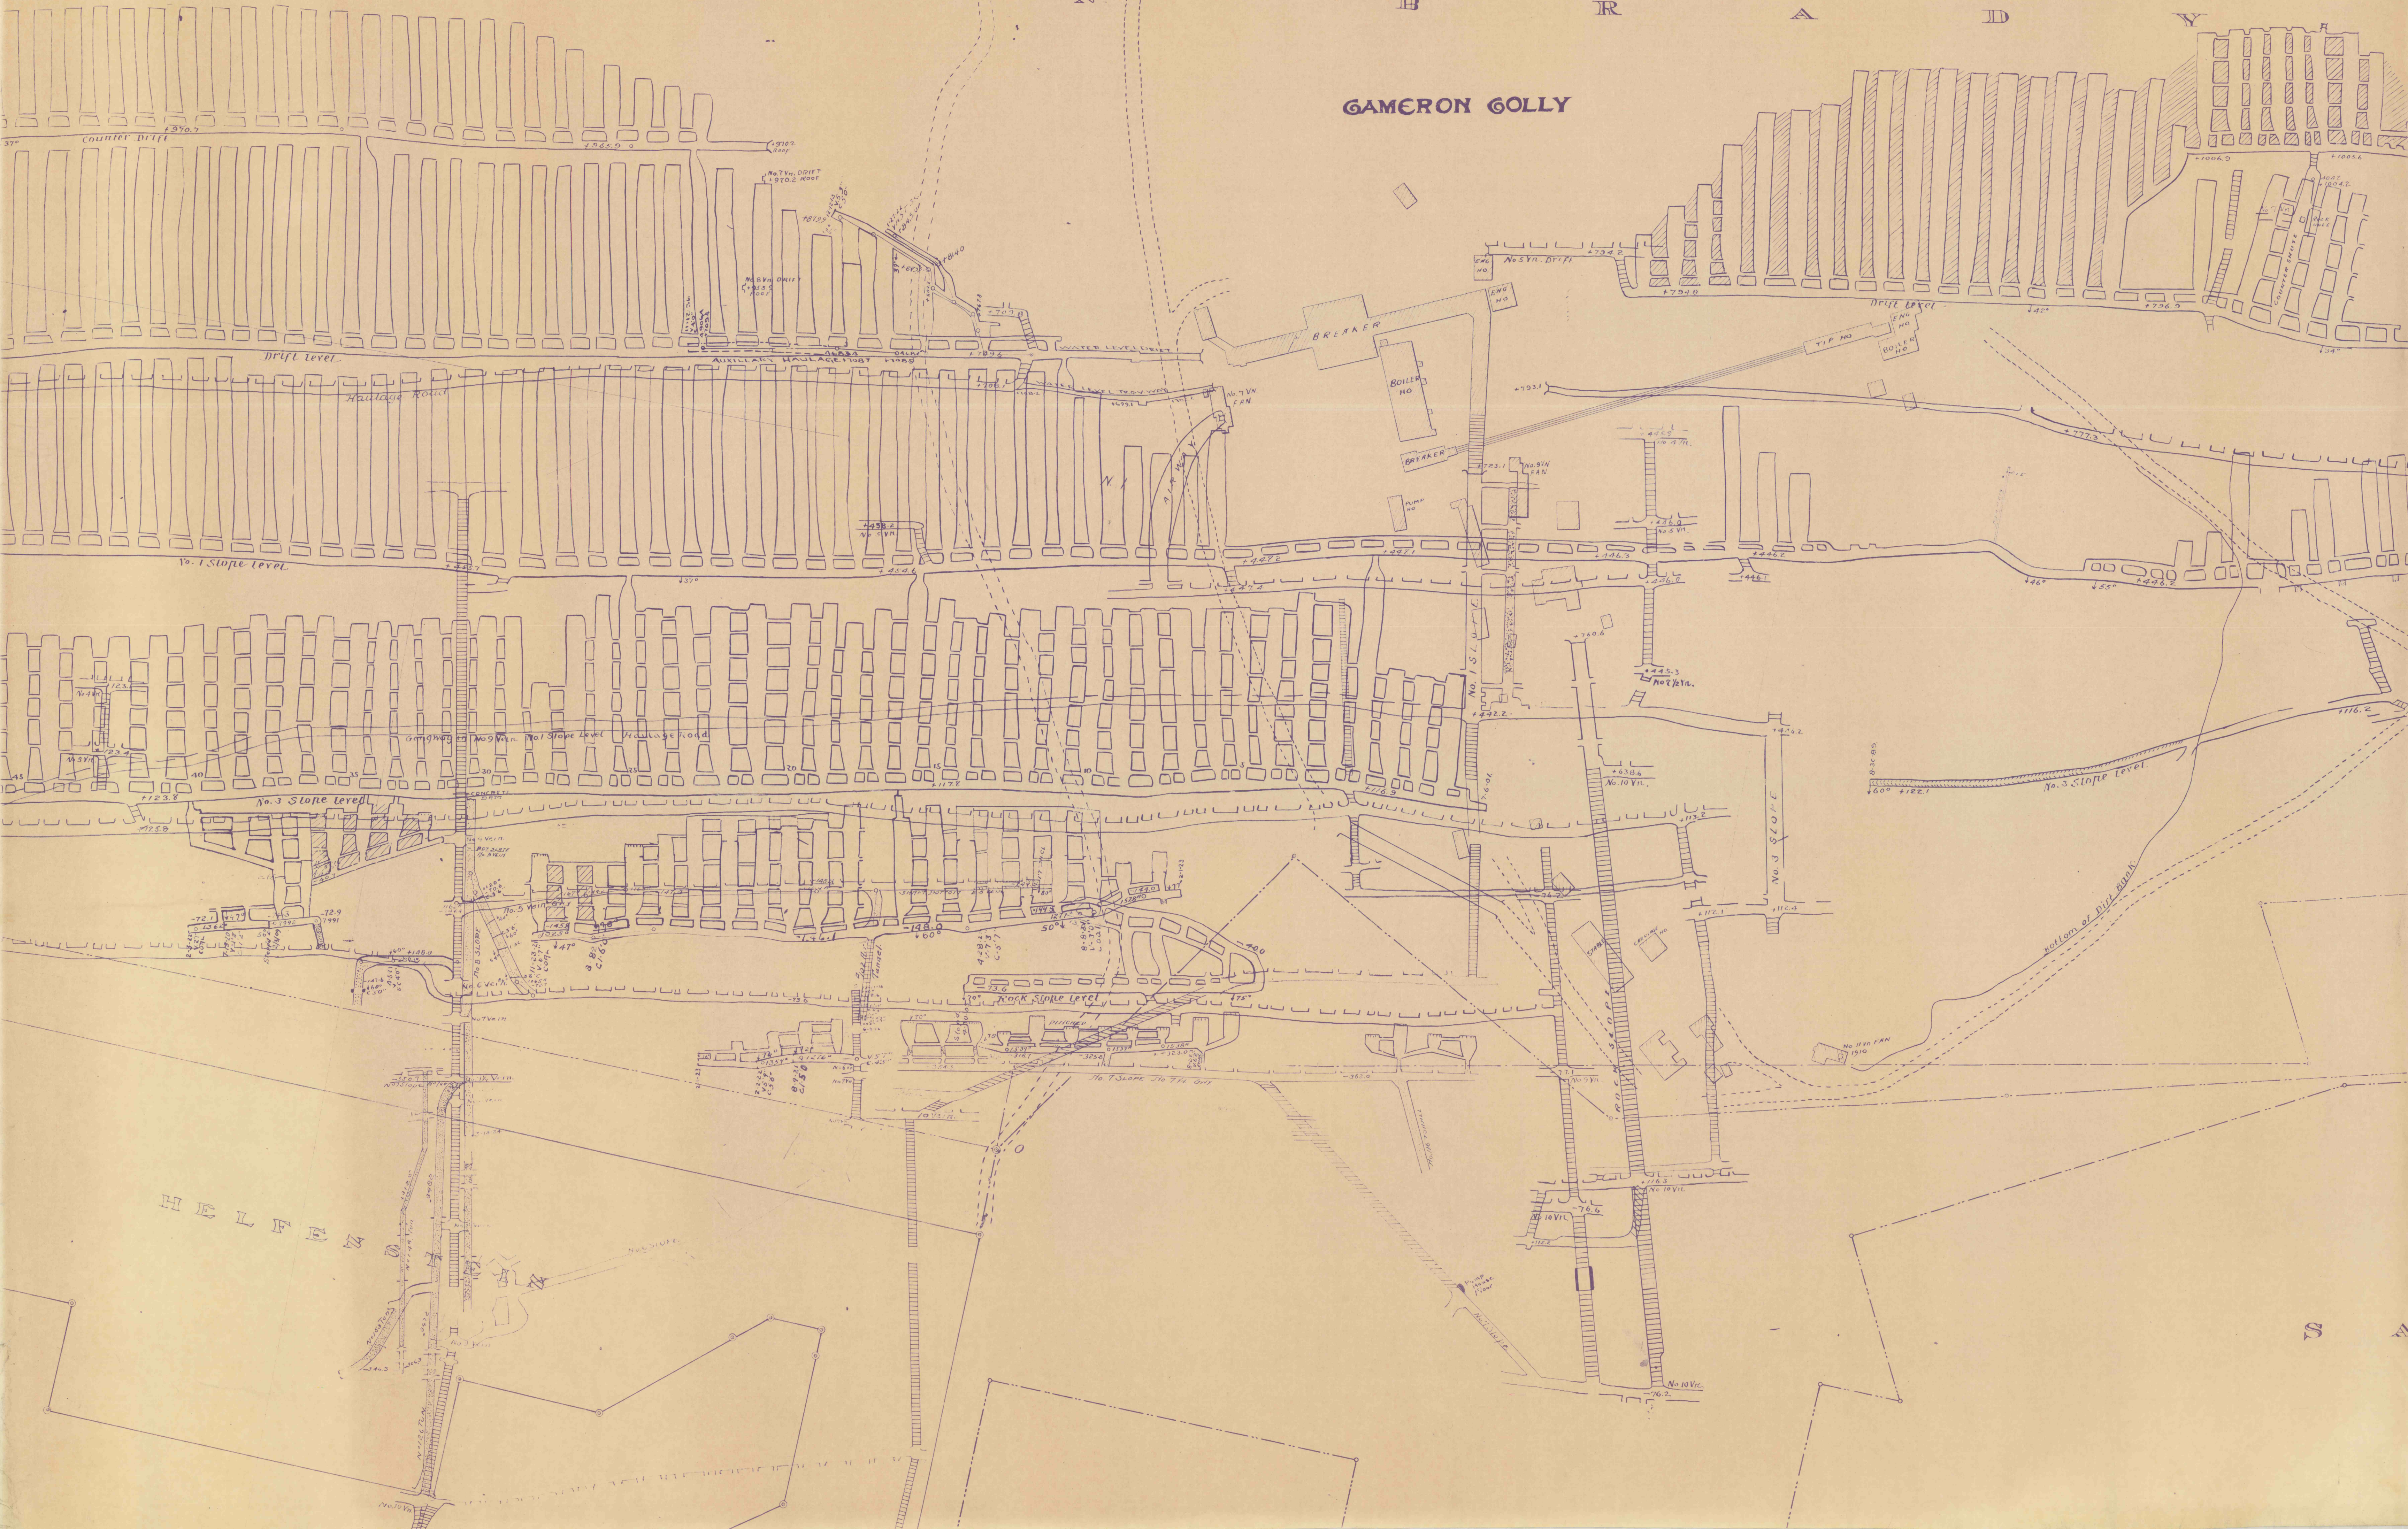

