


CURVE DATA TABLE

Curve No.	P. I. Coordinates		P. I. Station	Δ	D	R	T	L	P. C. Station	P. T. Station
	North	East								
	379,389.02	2,504,045.70	34+59.28	BEGIN CONTROLLED CHANNEL ALIGNMENT						
1	379,516.42	2,503,985.16	36+00.33	13°08'37" RT.	32°44'26"	175.00'	20.16'	40.14'	35+80.17	36+20.31
2	379,735.50	2,503,937.50	38+24.35	14°52'56" LT.	11°27'33"	500.00'	65.30'	129.87'	37+59.05	38+88.92

SURVEY # "A-30"
 3 - 263°13'30"
 IRON PIN
 N 380, 212.55
 E 2,503,759.38

SURVEY # "I-D"
 3 - 77°26'43"
 LEAD PLUG IN ROCK
 N 380, 284.33
 E 2,503,872.40

PLAN
 SCALE: 1" = 50'

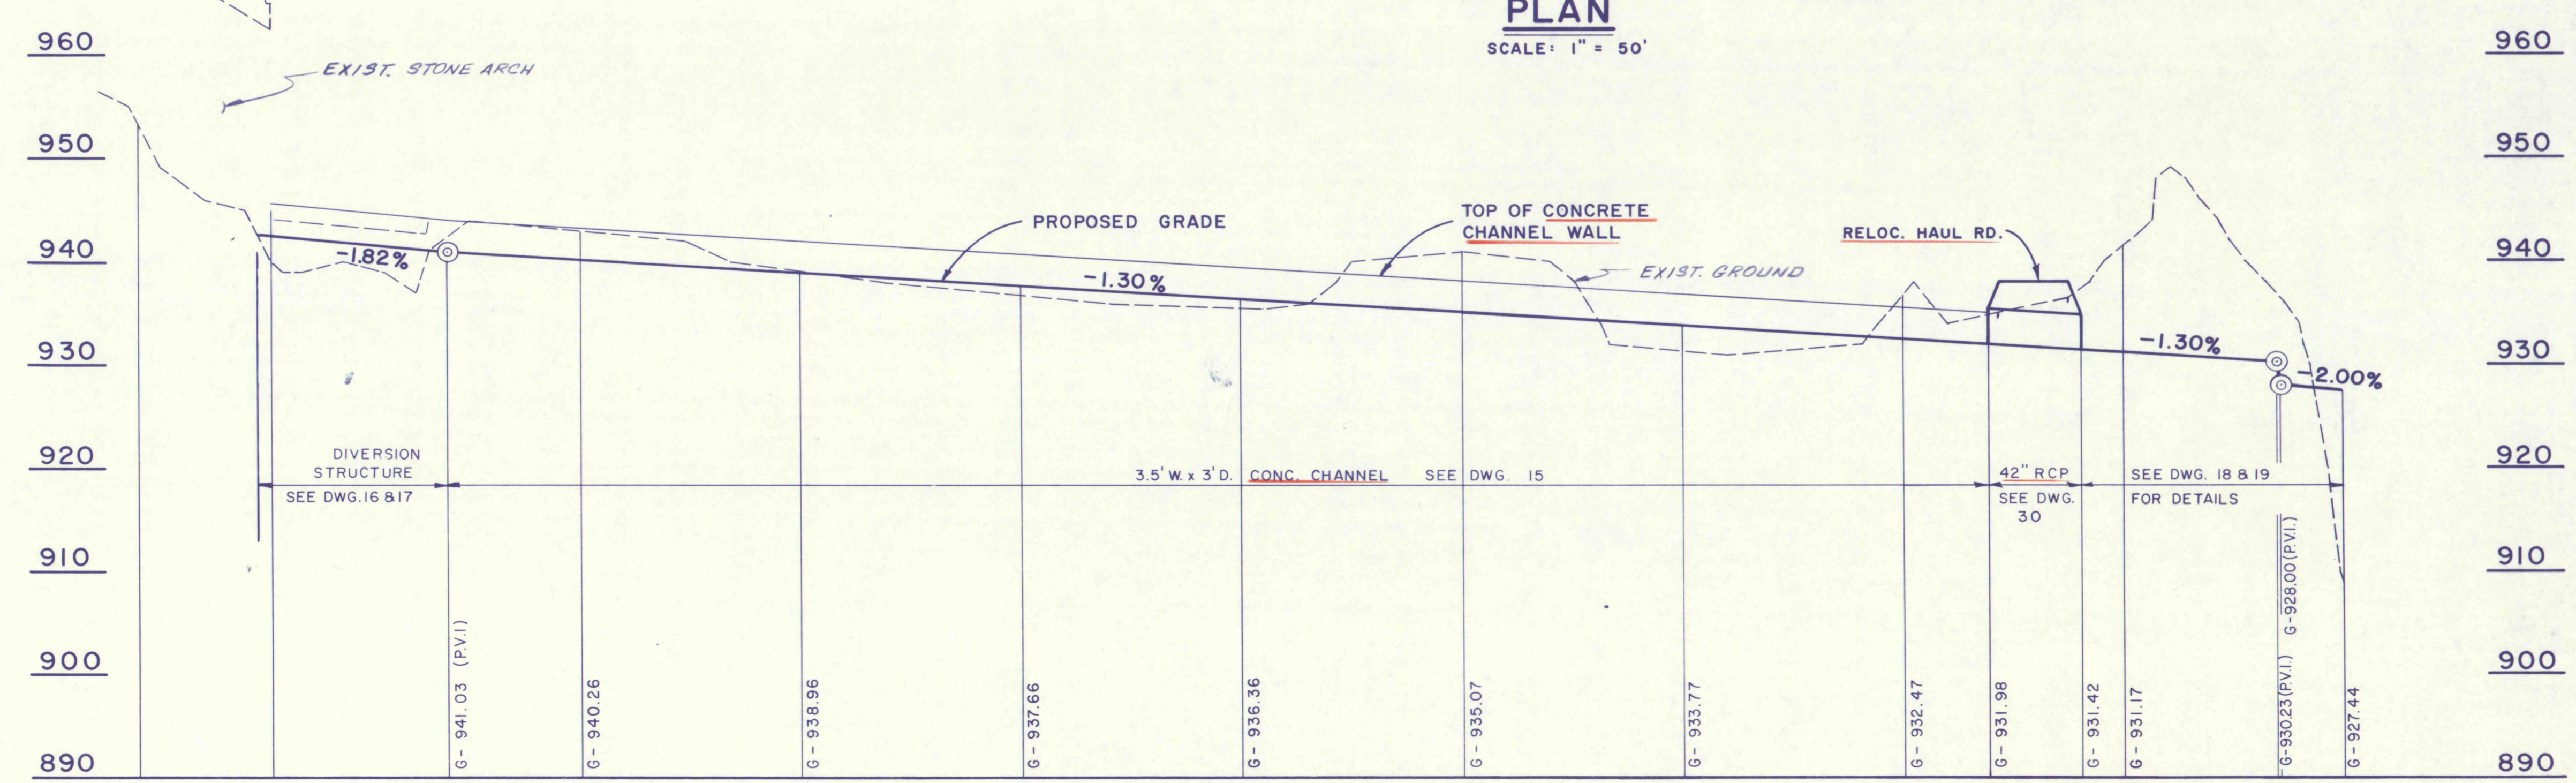

PROFILE

FOR CROSS SECTIONS SEE DWG. 31

NO.	DATE	REVISION	APPR.
SUBMITTED			
PROFESSIONAL			
APPROVED			
CHIEF - DIVISION OF MINE RECLAMATION			
APPROVED			
DIRECTOR - BUREAU OF DESIGN			
FINAL			
S.J.M. JUL 28 1977			
<i>All Blue Coal in property line</i>			
COMMONWEALTH OF PENNSYLVANIA DEPARTMENT OF ENVIRONMENTAL RESOURCES OFFICE OF RESOURCES MANAGEMENT			
CONTRACT NO. SL 181 - 3 - 101.1			
SUGAR NOTCH RUN AMD ABATEMENT PROJECT WARRIOR CREEK AND SOLOMON CREEK WATERSHEDS			
GEO - Technical Services CONSULTING ENGINEERS & GEOLOGISTS			
851 So. 19th St.		HARRISBURG, PENNA.	
PLAN & PROFILE			
STA. 34+59.28 TO STA. 44+00			

DRAWN BY
W.E.H.

CHECKED BY
S.J.M.

DATE
MAY 1977

SCALE
As Shown

DRAWING NO.
4 of 40