


**PLAN**

SCALE: 1 IN. = 50 FT.

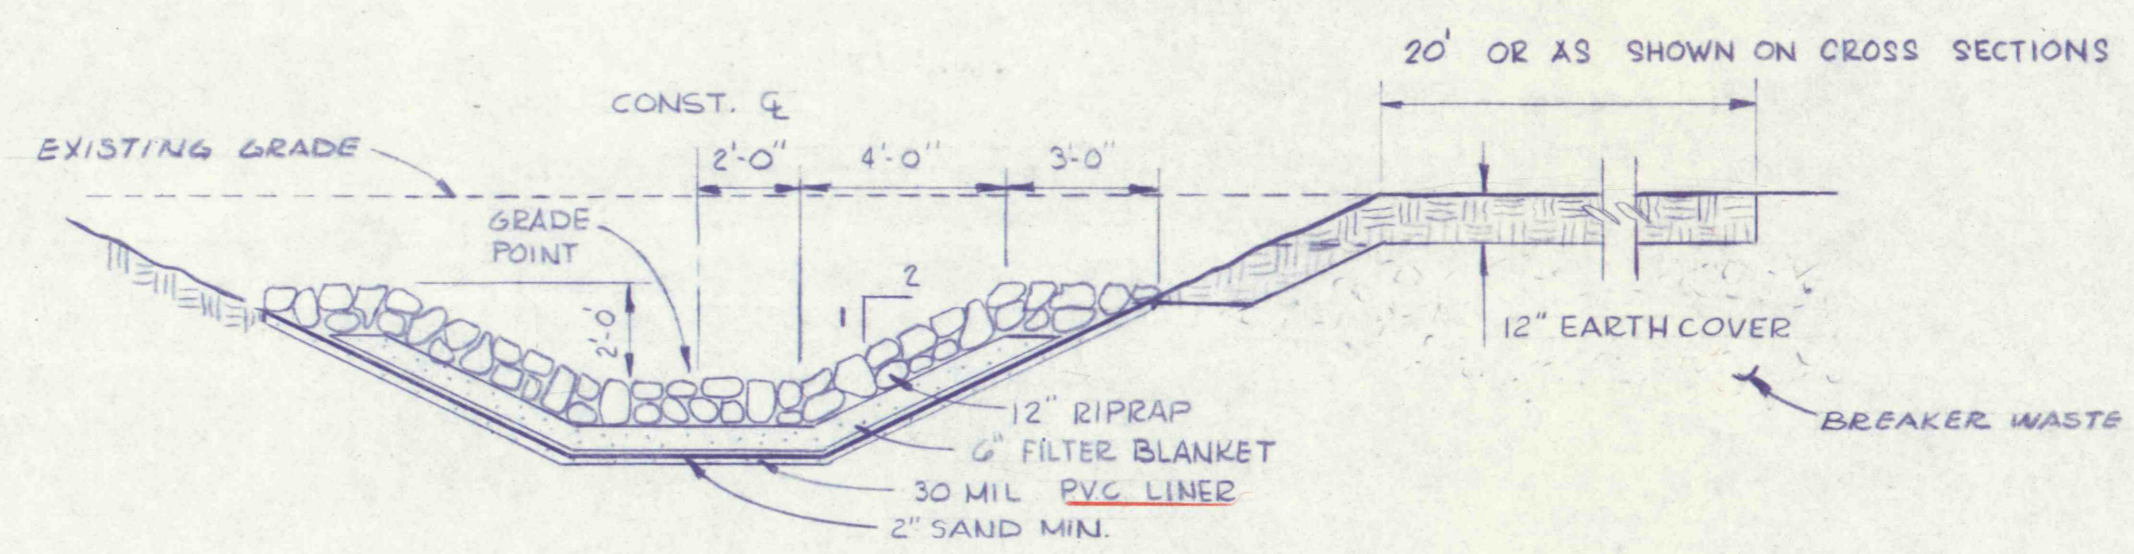

**BREAKER WASTE TREATMENT**

NOT TO SCALE

**CURVE DATA TABLE**

Curve No.	P. I. Coordinates		P. I. Station	Δ	D	R	T	L	P.C. Station	P.T. Station
	North	East								
10	382,609.34	2,500,938.71	83+05.57	13°42'19" RT.	4°58'56"	1150.00'	138.20'	275.08'	81+67.37	84+42.45

FOR CROSS SECTIONS SEE DWG 36

NO.	DATE	REVISION	APPR.
SUBMITTED			
PROFESSIONAL			
APPROVED			
CHIEF - DIVISION OF MINE RECLAMATION			
APPROVED			
DIRECTOR - BUREAU OF DESIGN			

**FINAL**

S.J.M. JUL 28 1977

COMMONWEALTH OF PENNSYLVANIA  
DEPARTMENT OF ENVIRONMENTAL RESOURCES  
OFFICE OF RESOURCES MANAGEMENT


CONTRACT NO. SL 181-3-101.1

SUGAR NOTCH RUN AMD  
ABATEMENT PROJECT  
WARRIOR CREEK AND  
SOLOMON CREEK WATERSHEDS

GEO - Technical Services  
CONSULTING ENGINEERS & GEOLOGISTS  
851 So. 19th St. HARRISBURG, PENNA.

**PLAN & PROFILE**  
**STA. 82+00 TO STA. 94+00**

DRAWN BY WEH	DATE SEPT. 1976	DRAWING NO. 8 of 40
CHECKED BY SJM	SCALE As Shown	

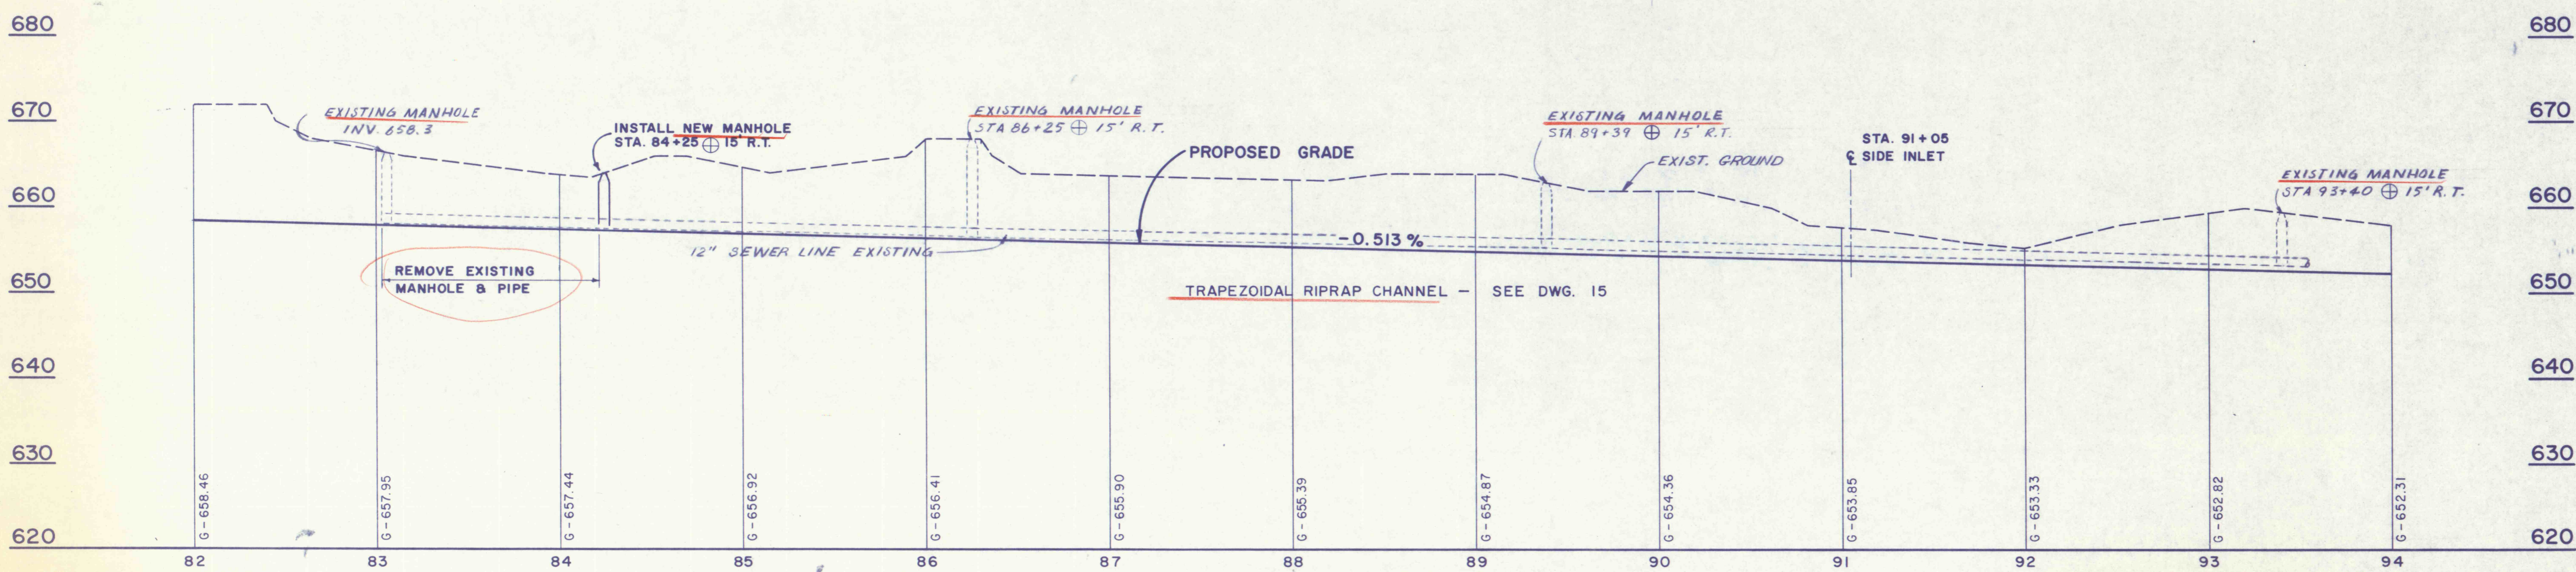

**PROFILE**