


E 2,499,000
N 383,500

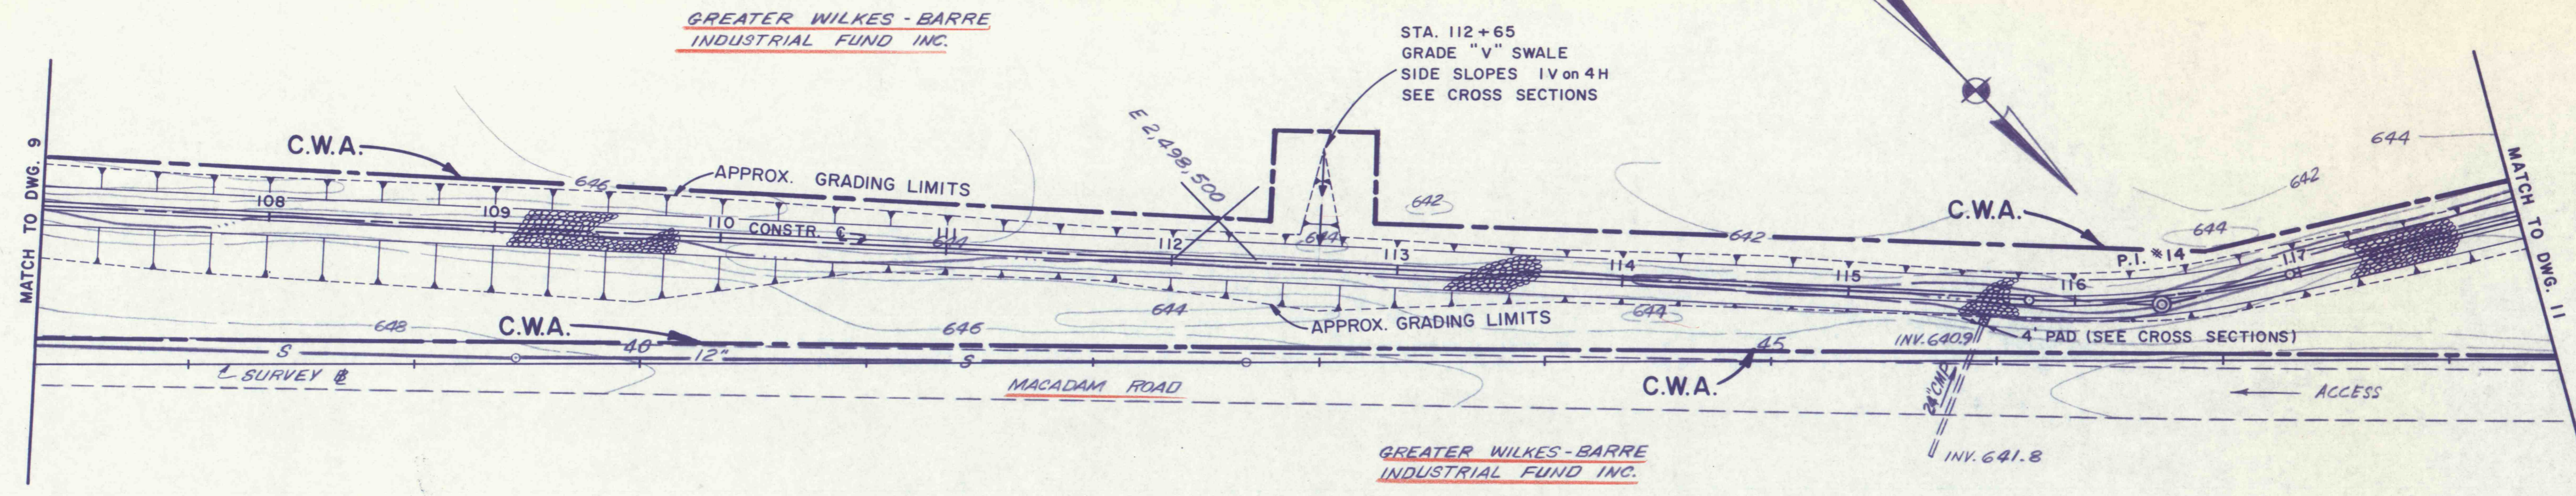


PLAN

SCALE: 1 IN. = 50 FT.

CURVE DATA TABLE

Curve No.	P.I. Coordinates		P.I. Station	Δ	D	R	T	L	P.C. Station	P.T. Station
	North	East								
14	384,310.52	2,498,218.22	116+37.98	16°53'48" LT.	14°19'26"	400.00'	59.41'	117.96'	115+78.57	116+96.53

FOR CROSS SECTIONS SEE DWG 37-38

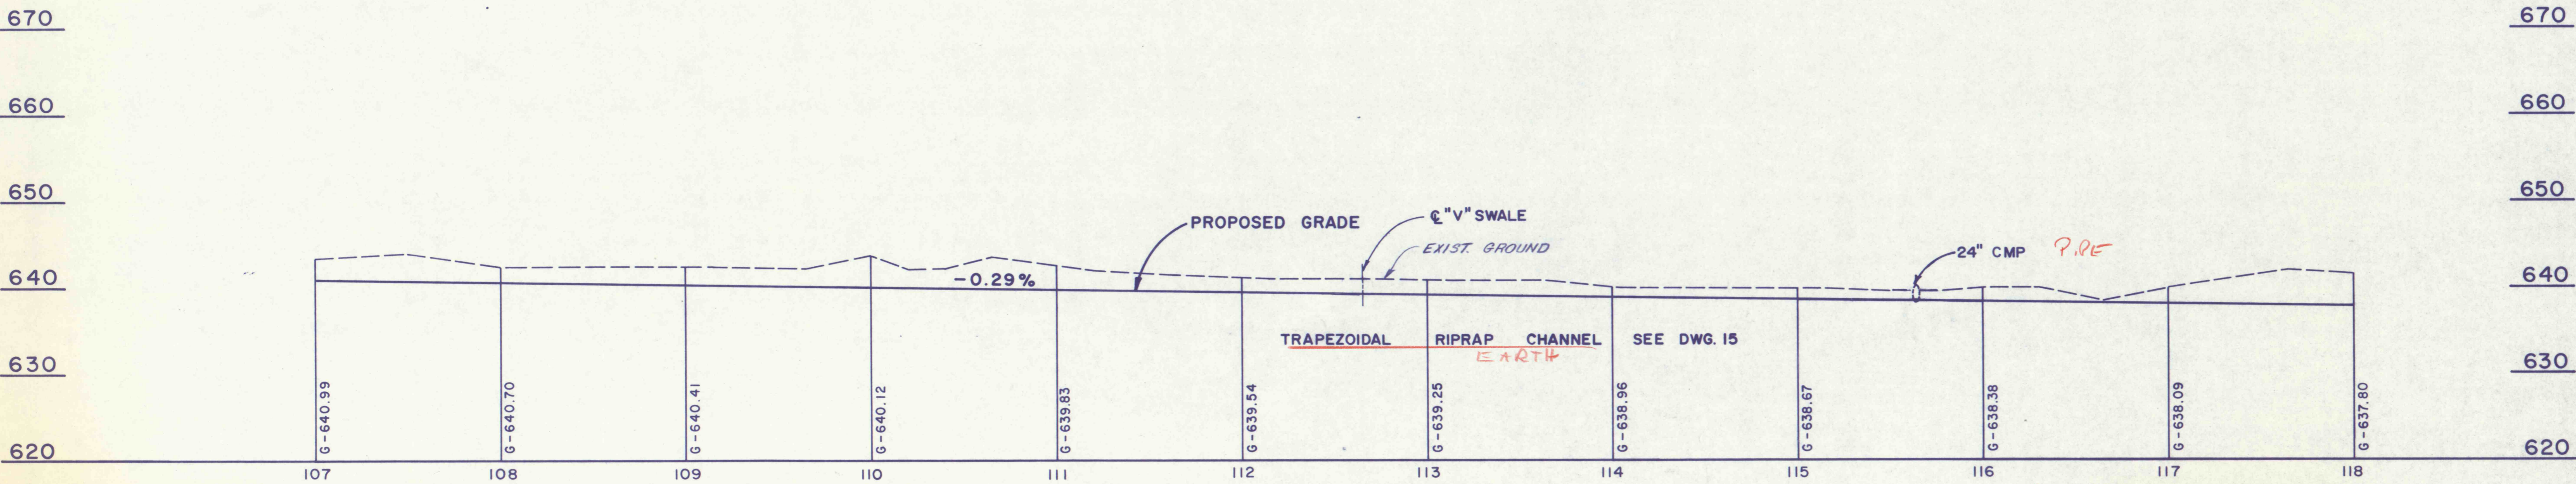

PROFILE

NO.	DATE	REVISION	APPR.
SUBMITTED			
PROFESSIONAL			
APPROVED			
CHIEF - DIVISION OF MINE RECLAMATION			
APPROVED			
DIRECTOR - BUREAU OF DESIGN			
FINAL			
S.J.M. JUL 28 1977			
COMMONWEALTH OF PENNSYLVANIA DEPARTMENT OF ENVIRONMENTAL RESOURCES OFFICE OF RESOURCES MANAGEMENT			
CONTRACT NO. SL 181-3-101.1			
SUGAR NOTCH RUN AMD ABATEMENT PROJECT WARRIOR CREEK AND SOLOMON CREEK WATERSHEDS			
GEO - Technical Services CONSULTING ENGINEERS & GEOLOGISTS 851 So. 19th St. HARRISBURG, PENNA.			
PLAN & PROFILE STA. 107+00 TO STA. 118+00			
DRAWN BY WEH	DATE SEPT. 1976	DRAWING NO. 10 of 40	
CHECKED BY SJM	SCALE As Shown		