

STA. 133+70.00
END LINED CHANNEL

SURVEY # "A-8"
P.I. Sta. 67+35.71
Δ = 198°57'39"
CHISELED CROSS ON MANHOLE RIM
N 384,381.76
E 2,496,487.93
ELEV. 618.48

SURVEY # "A-7"
P.I. Sta. 62+95.77
Δ = 252°37'03"
COPPERWELD
N 384,028.83
E 2,496,750.58

ROBERT W. CLEVELAND

ROBERT W. CLEVELAND

STA. 130+75 TO STA. 131+20
ENCASE SEWER PIPE IN CONCRETE
6" MIN. COVER


PLAN

SCALE: 1 IN. = 50 FT.

CURVE DATA TABLE

Curve No.	P.I. Coordinates		P.I. Station	Δ	D	R	T	L	P.C. Station	P.T. Station		
	North	East										
17	384,020.65	2,496,817.59	131+52.50	60°43'23" RT.	28°38'52"	200.00'	117.16'	211.96'	130+35.34	132+47.30		
18	384,153.53	2,496,643.51	133+49.14	23°14'18" RT.	57°17'45"	100.00'	20.56'	40.56'	133+28.58	133+69.14		
—	384,172.19	2,496,632.99	133+70.00	END CONTROLLED CHANNEL ALIGNMENT								

FOR CROSS SECTIONS SEE DWG 37

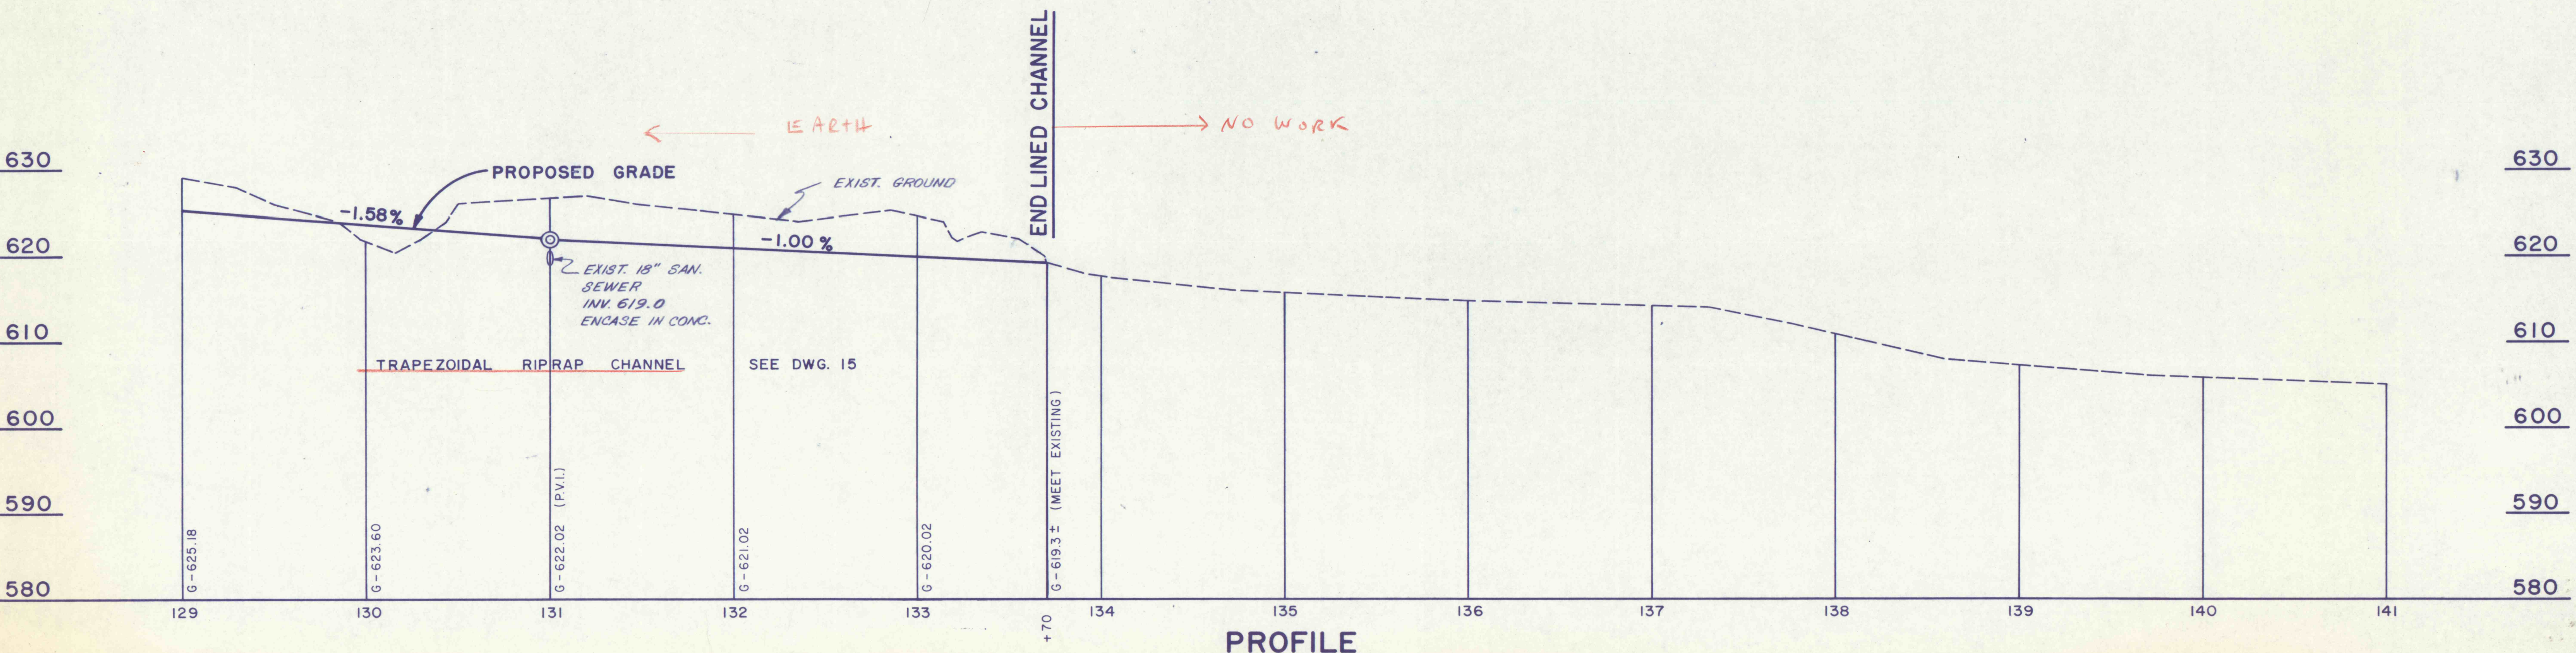

PROFILE

NO.	DATE	REVISION	APPR.
SUBMITTED			
PROFESSIONAL			
APPROVED			
CHIEF - DIVISION OF MINE RECLAMATION			
APPROVED			
DIRECTOR - BUREAU OF DESIGN			
FINAL			
S.J.M. JUL 28 1977			
COMMONWEALTH OF PENNSYLVANIA DEPARTMENT OF ENVIRONMENTAL RESOURCES OFFICE OF RESOURCES MANAGEMENT			
CONTRACT NO. SL 181-3-101.1			
SUGAR NOTCH RUN AMD ABATEMENT PROJECT WARRIOR CREEK AND SOLOMON CREEK WATERSHEDS			
GEO - Technical Services CONSULTING ENGINEERS & GEOLOGISTS 851 So. 19th St. HARRISBURG, PENNA.			
PLAN & PROFILE STA. 129+00 TO STA. 141+00			

DRAWN BY WEH	DATE NOV. 1976	DRAWING NO. 12 of 40
CHECKED BY SJM	SCALE As Shown	