


EASTERN MAPPING CO.

 250 FRENCH ROAD

 PITTSBURGH, PENNSYLVANIA 15228

 412/828-3410

PROJECT NO. AND NAME	D-2603 - 0.5m x 0.5m (32' x 32') 10/11
MODEL NO.	
SCALE	5' = 1" (1:150)
CONTOUR INTERVAL	2'
PARAMETER	CONTOUR
CHECKED	
DATE	

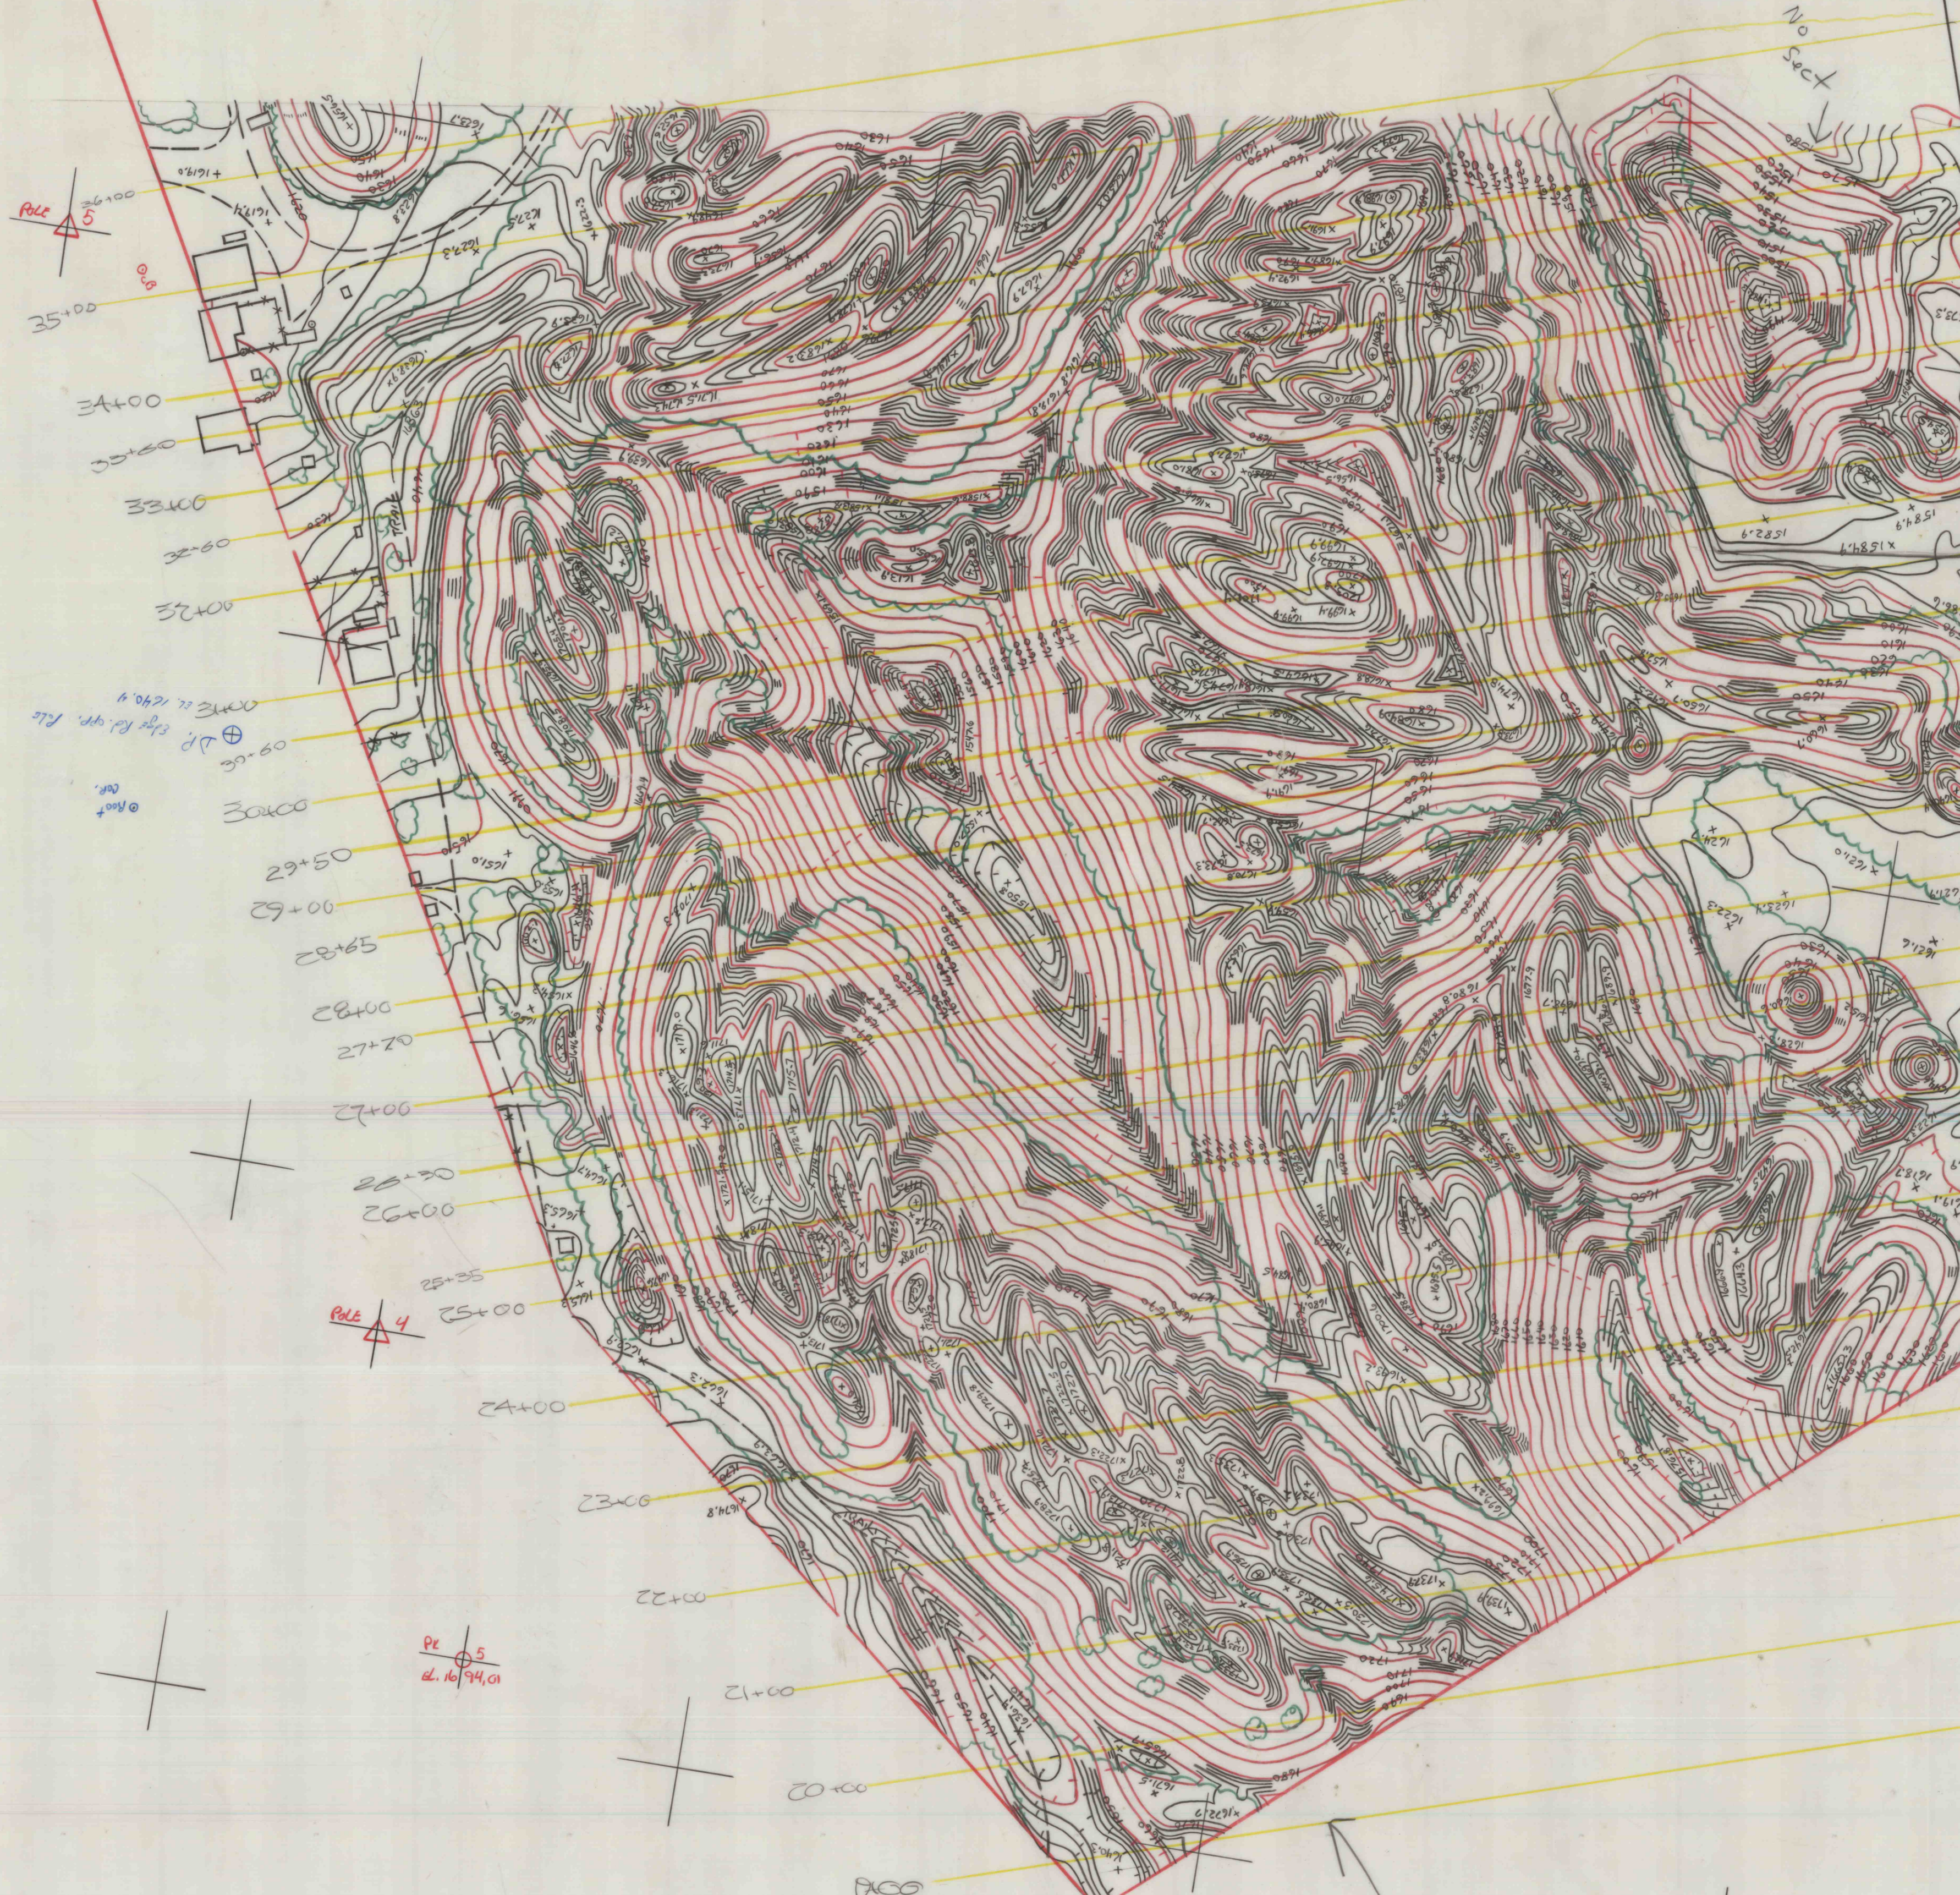


35+00
 34+00
 33+00
 32+00
 31+00
 30+00
 29+50
 29+00
 28+65
 28+00
 27+20
 27+00
 26+50
 26+00
 25+50
 25+00
 24+00
 23+00
 22+00
 21+00
 20+00

X-section
 No Sect
