
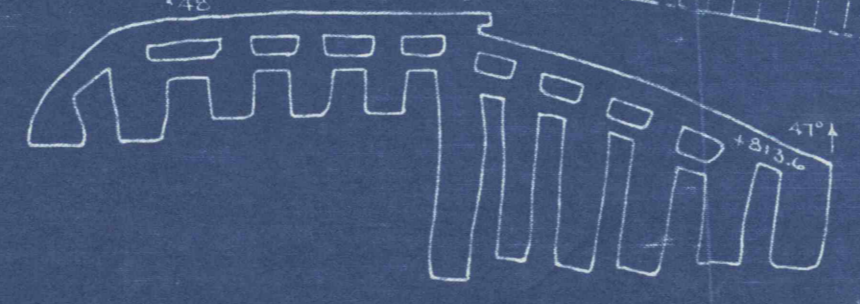


JOHN WHITE TRACT

THOMPSON TRACT

BARRIER
E-STAR
WORKINGS

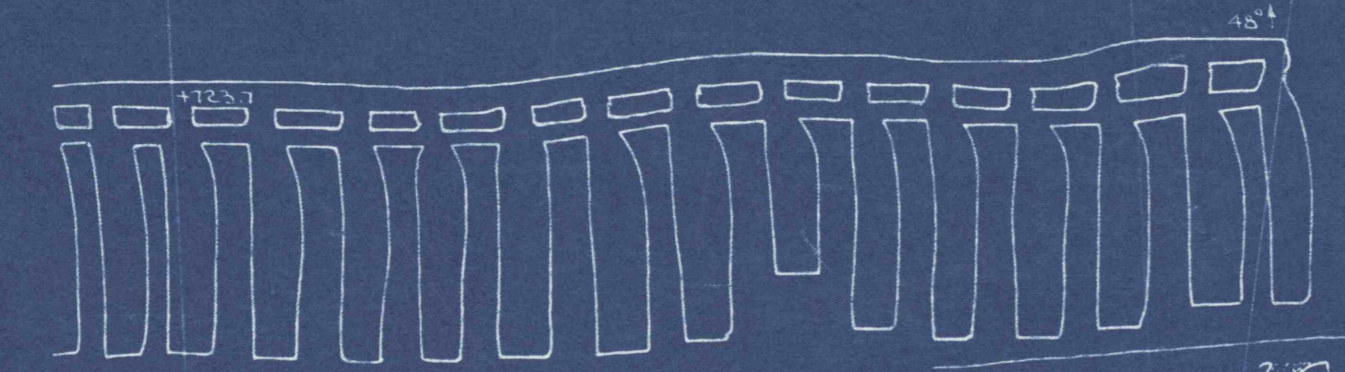

BRADY COAL CO WORKINGS
ABANDONED

BARRIER PILLAR

BARRIER

NO 9 VEIN
1"=100' 12-20-62